



PLAN
 DATE: 10-24-54
 DRAWN BY: L. H. HARRIS
 CHECKED BY: J. W. HARRIS
 NO. OF SHEETS: 20
 SHEET NO.: 20

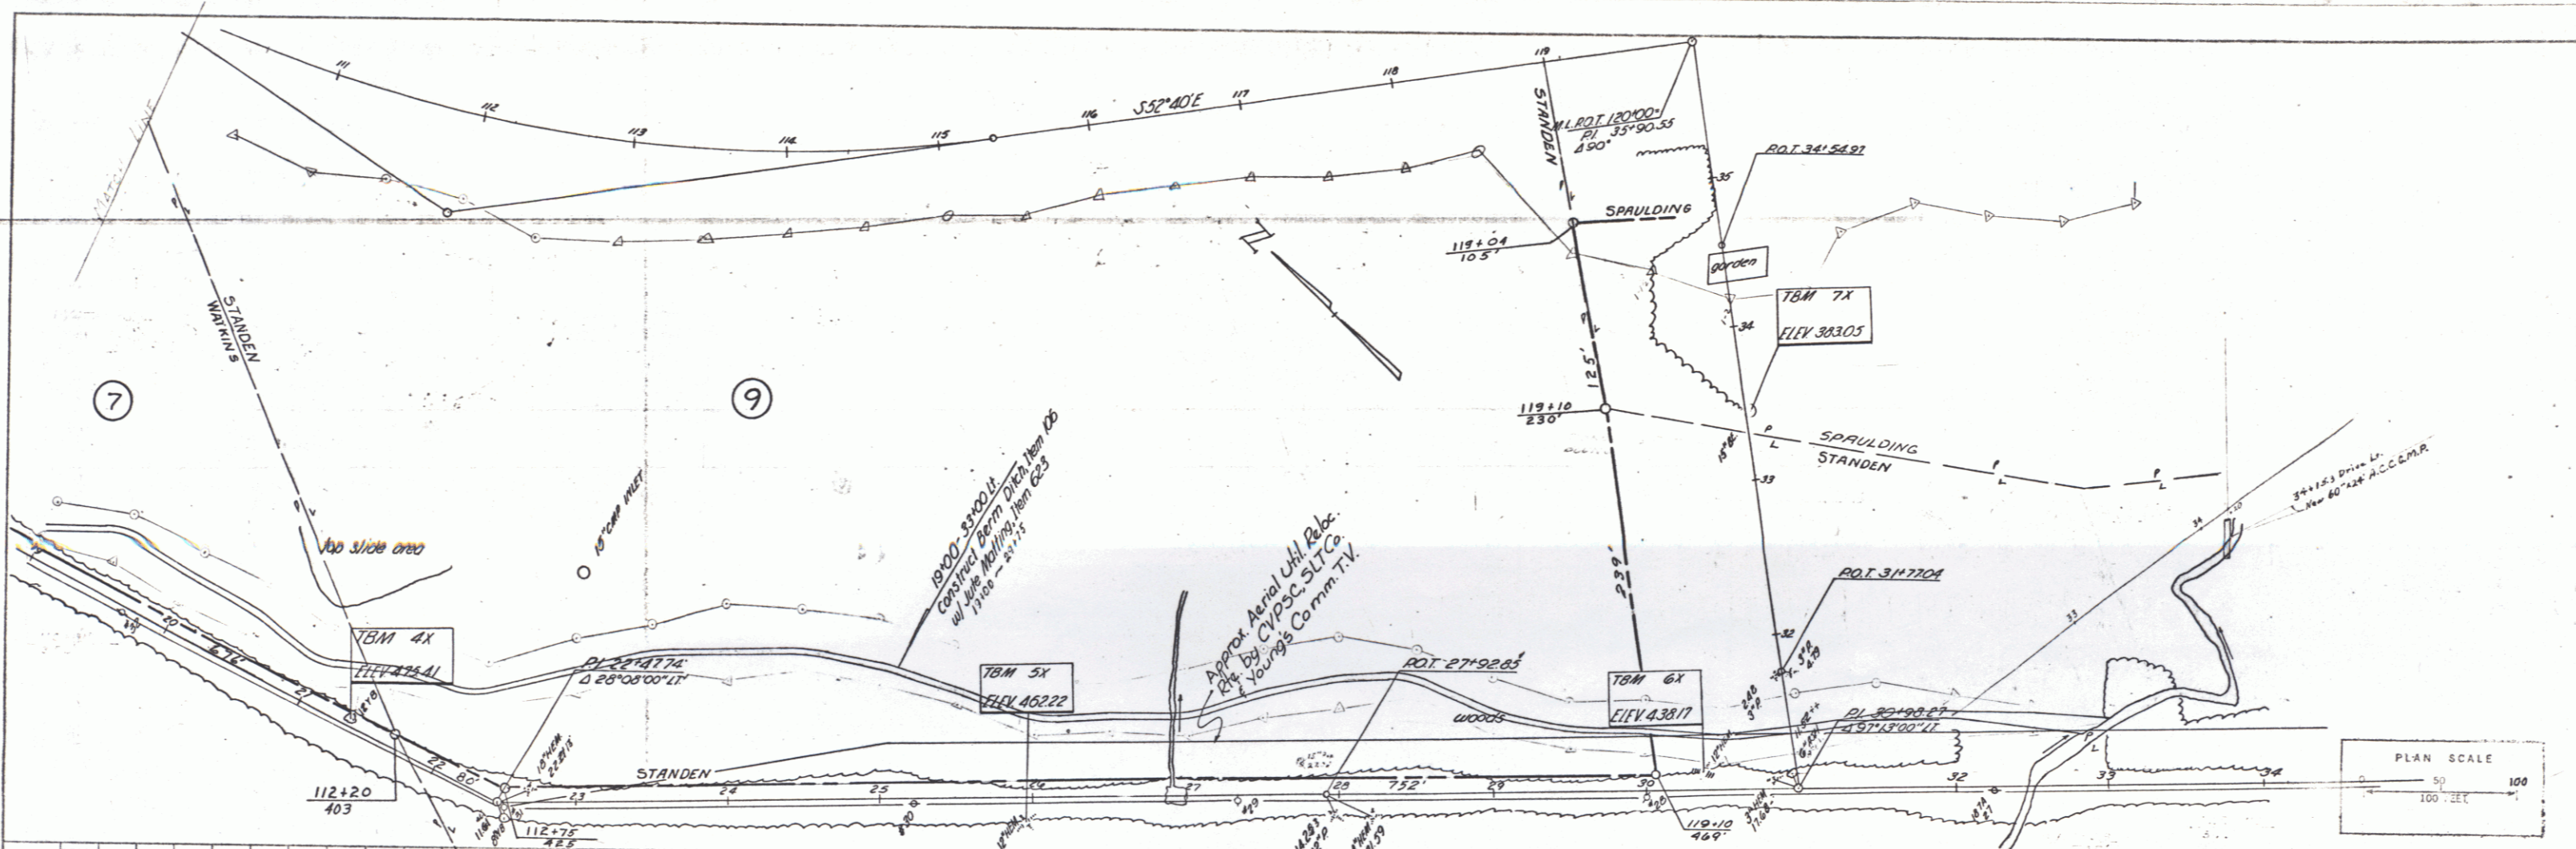

PLAN SCALE
 1" = 100' FEET

PROFILE
 DATE: 10-24-54
 DRAWN BY: L. H. HARRIS
 CHECKED BY: J. W. HARRIS
 NO. OF SHEETS: 20
 SHEET NO.: 20

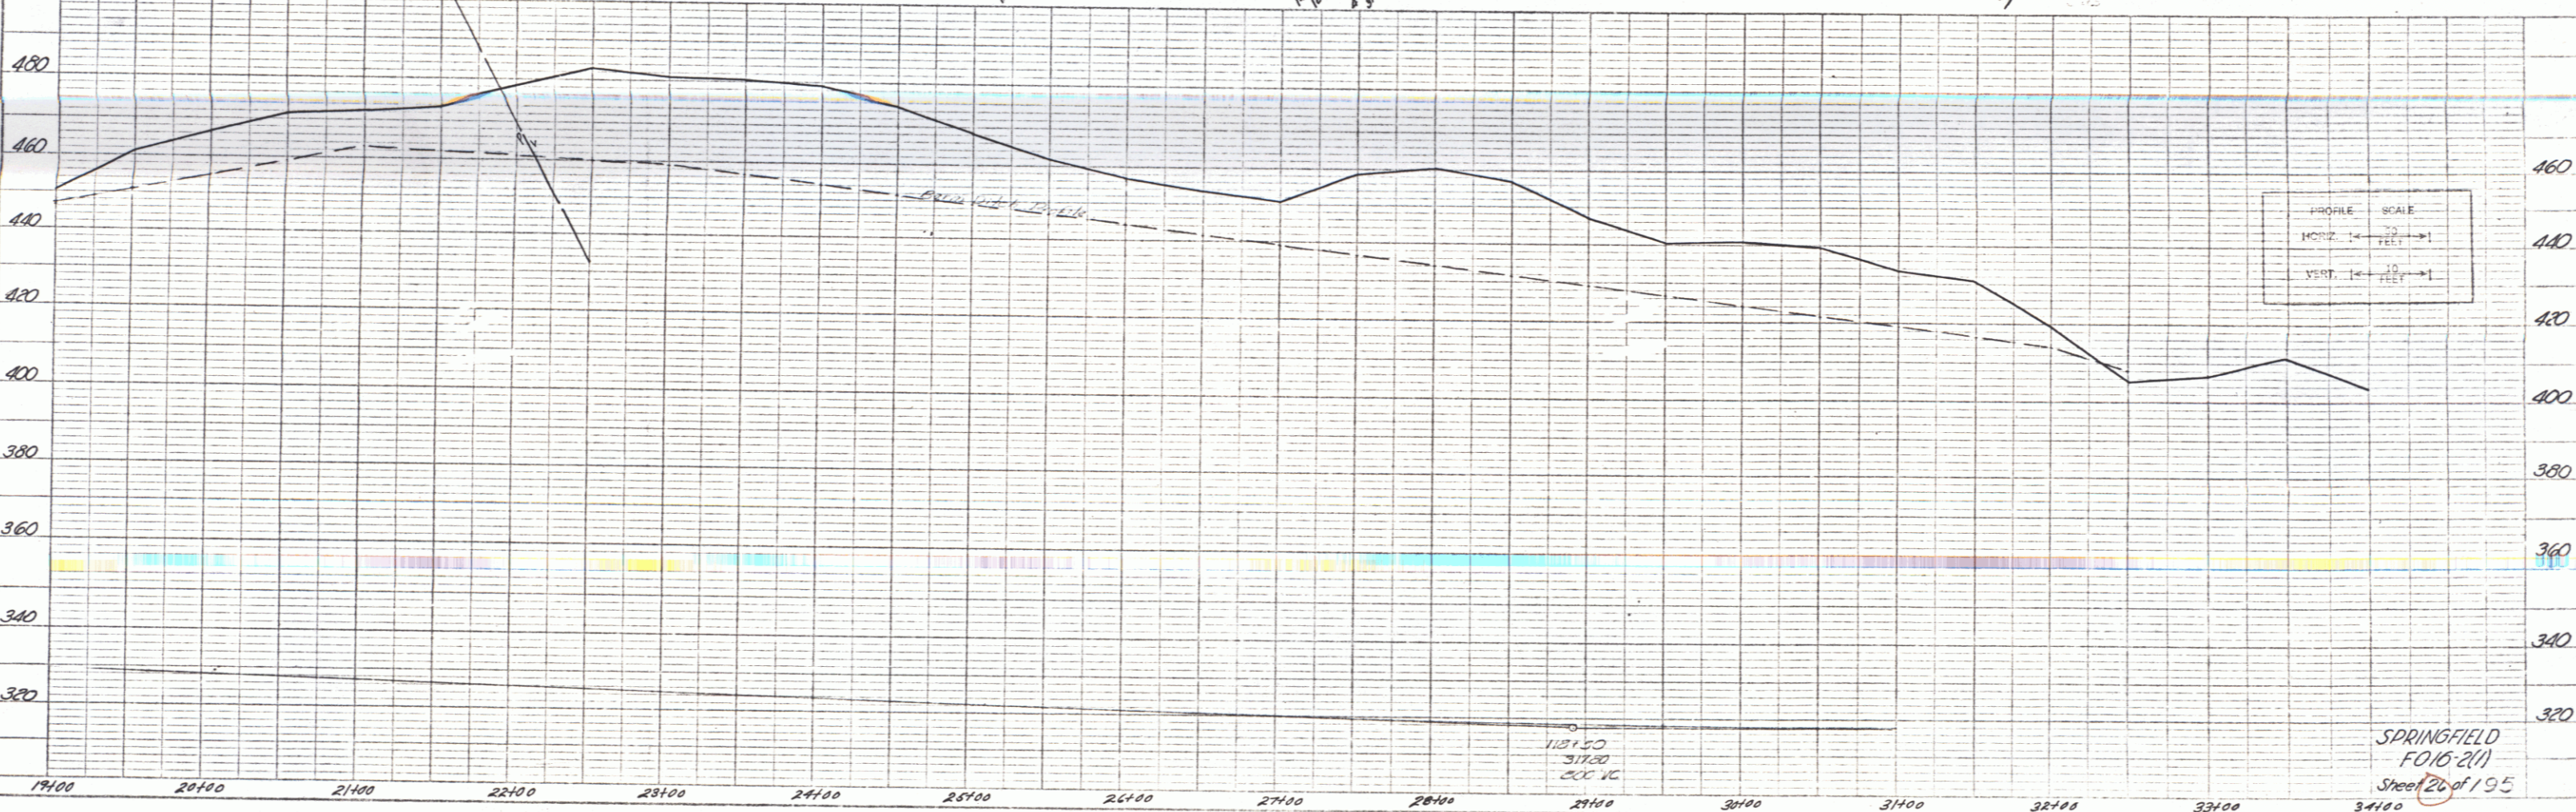

PROFILE SCALE
 HORIZ. 1" = 20' FEET
 VERT. 1" = 10' FEET

SPRINGFIELD
 F016-211
 Sheet 20 of 195

PLANS: 1/4" = 1" SCALE, 1/8" = 1" SCALE
 PROFILES: 1/4" = 1" SCALE, 1/8" = 1" SCALE