
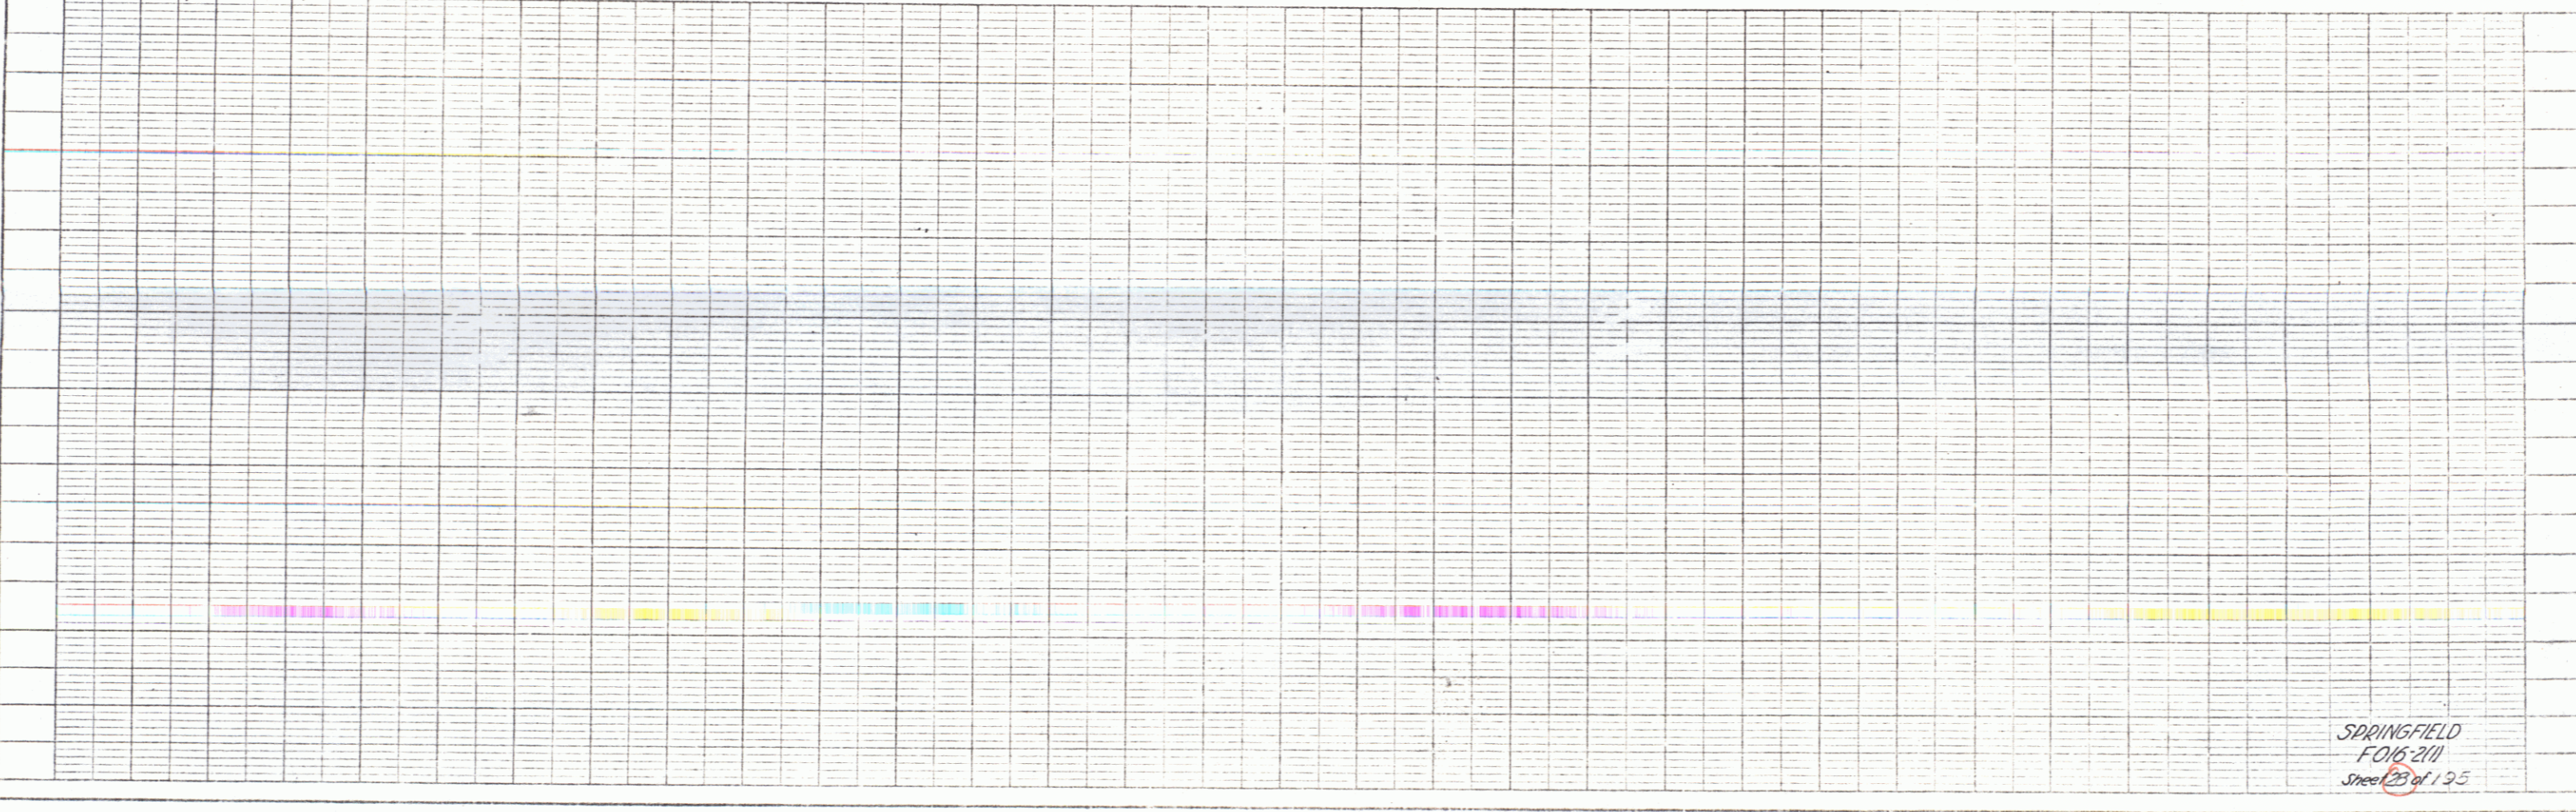
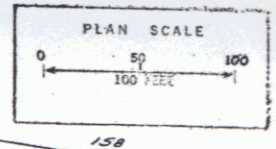


PLAN
 DATE: 7/15/11
 DRAWN BY: [Signature]
 CHECKED BY: [Signature]
 PROJECT: [Signature]
 SHEET NO.: 21

PROFILE
 DATE: 7/15/11
 DRAWN BY: [Signature]
 CHECKED BY: [Signature]
 PROJECT: [Signature]

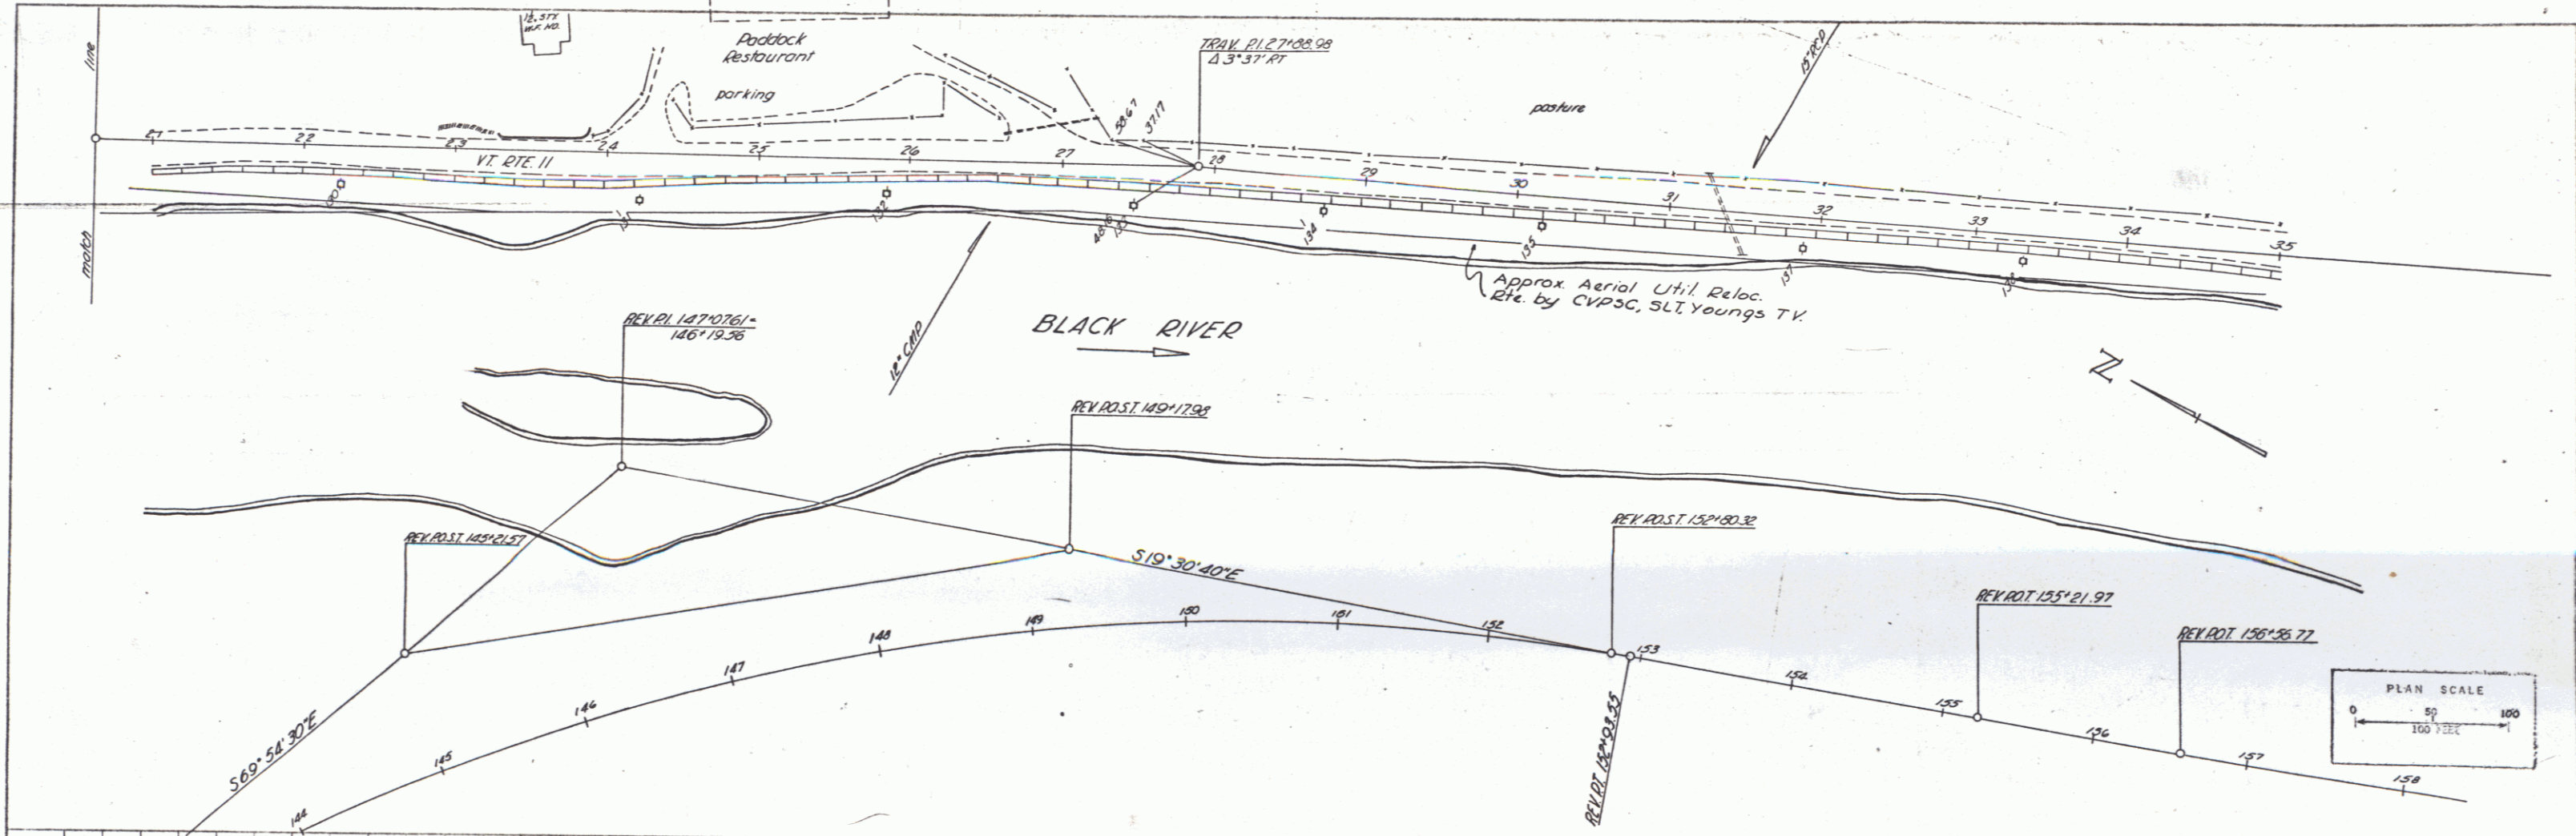

SPRINGFIELD
 FORM 2111
 Sheet 21 of 125

PLATE 1 FOR PROFILE S.P.A. & STANDARD
 SUPPLY LETTERS - NO. 9126
 1/2" x 1/4" NO. 248