

POOR ORIGINAL COPY


SURPLUS PARCEL #115
STA. 7+85 - 9+55 SL
AREA 0.26 A ±

DEMOLITION AND REMOVAL OF BUILDINGS
ITEM 386
STA. 48+20 RT TO 1

EXCAVATION AND REMOVAL OF ROAD SURFACE
ON ROADWAYS, ITEM 18-A
47+50 - 51+90 LT

PARCEL	LINE	STA. POINT	ST. POINT
QUANTITY			
POINTS			
DAILY YARDS			
RECORDED			

BENCHING OF SLOPE, ITEM 101-A
STA 47+50 TO STA 52+50 RT

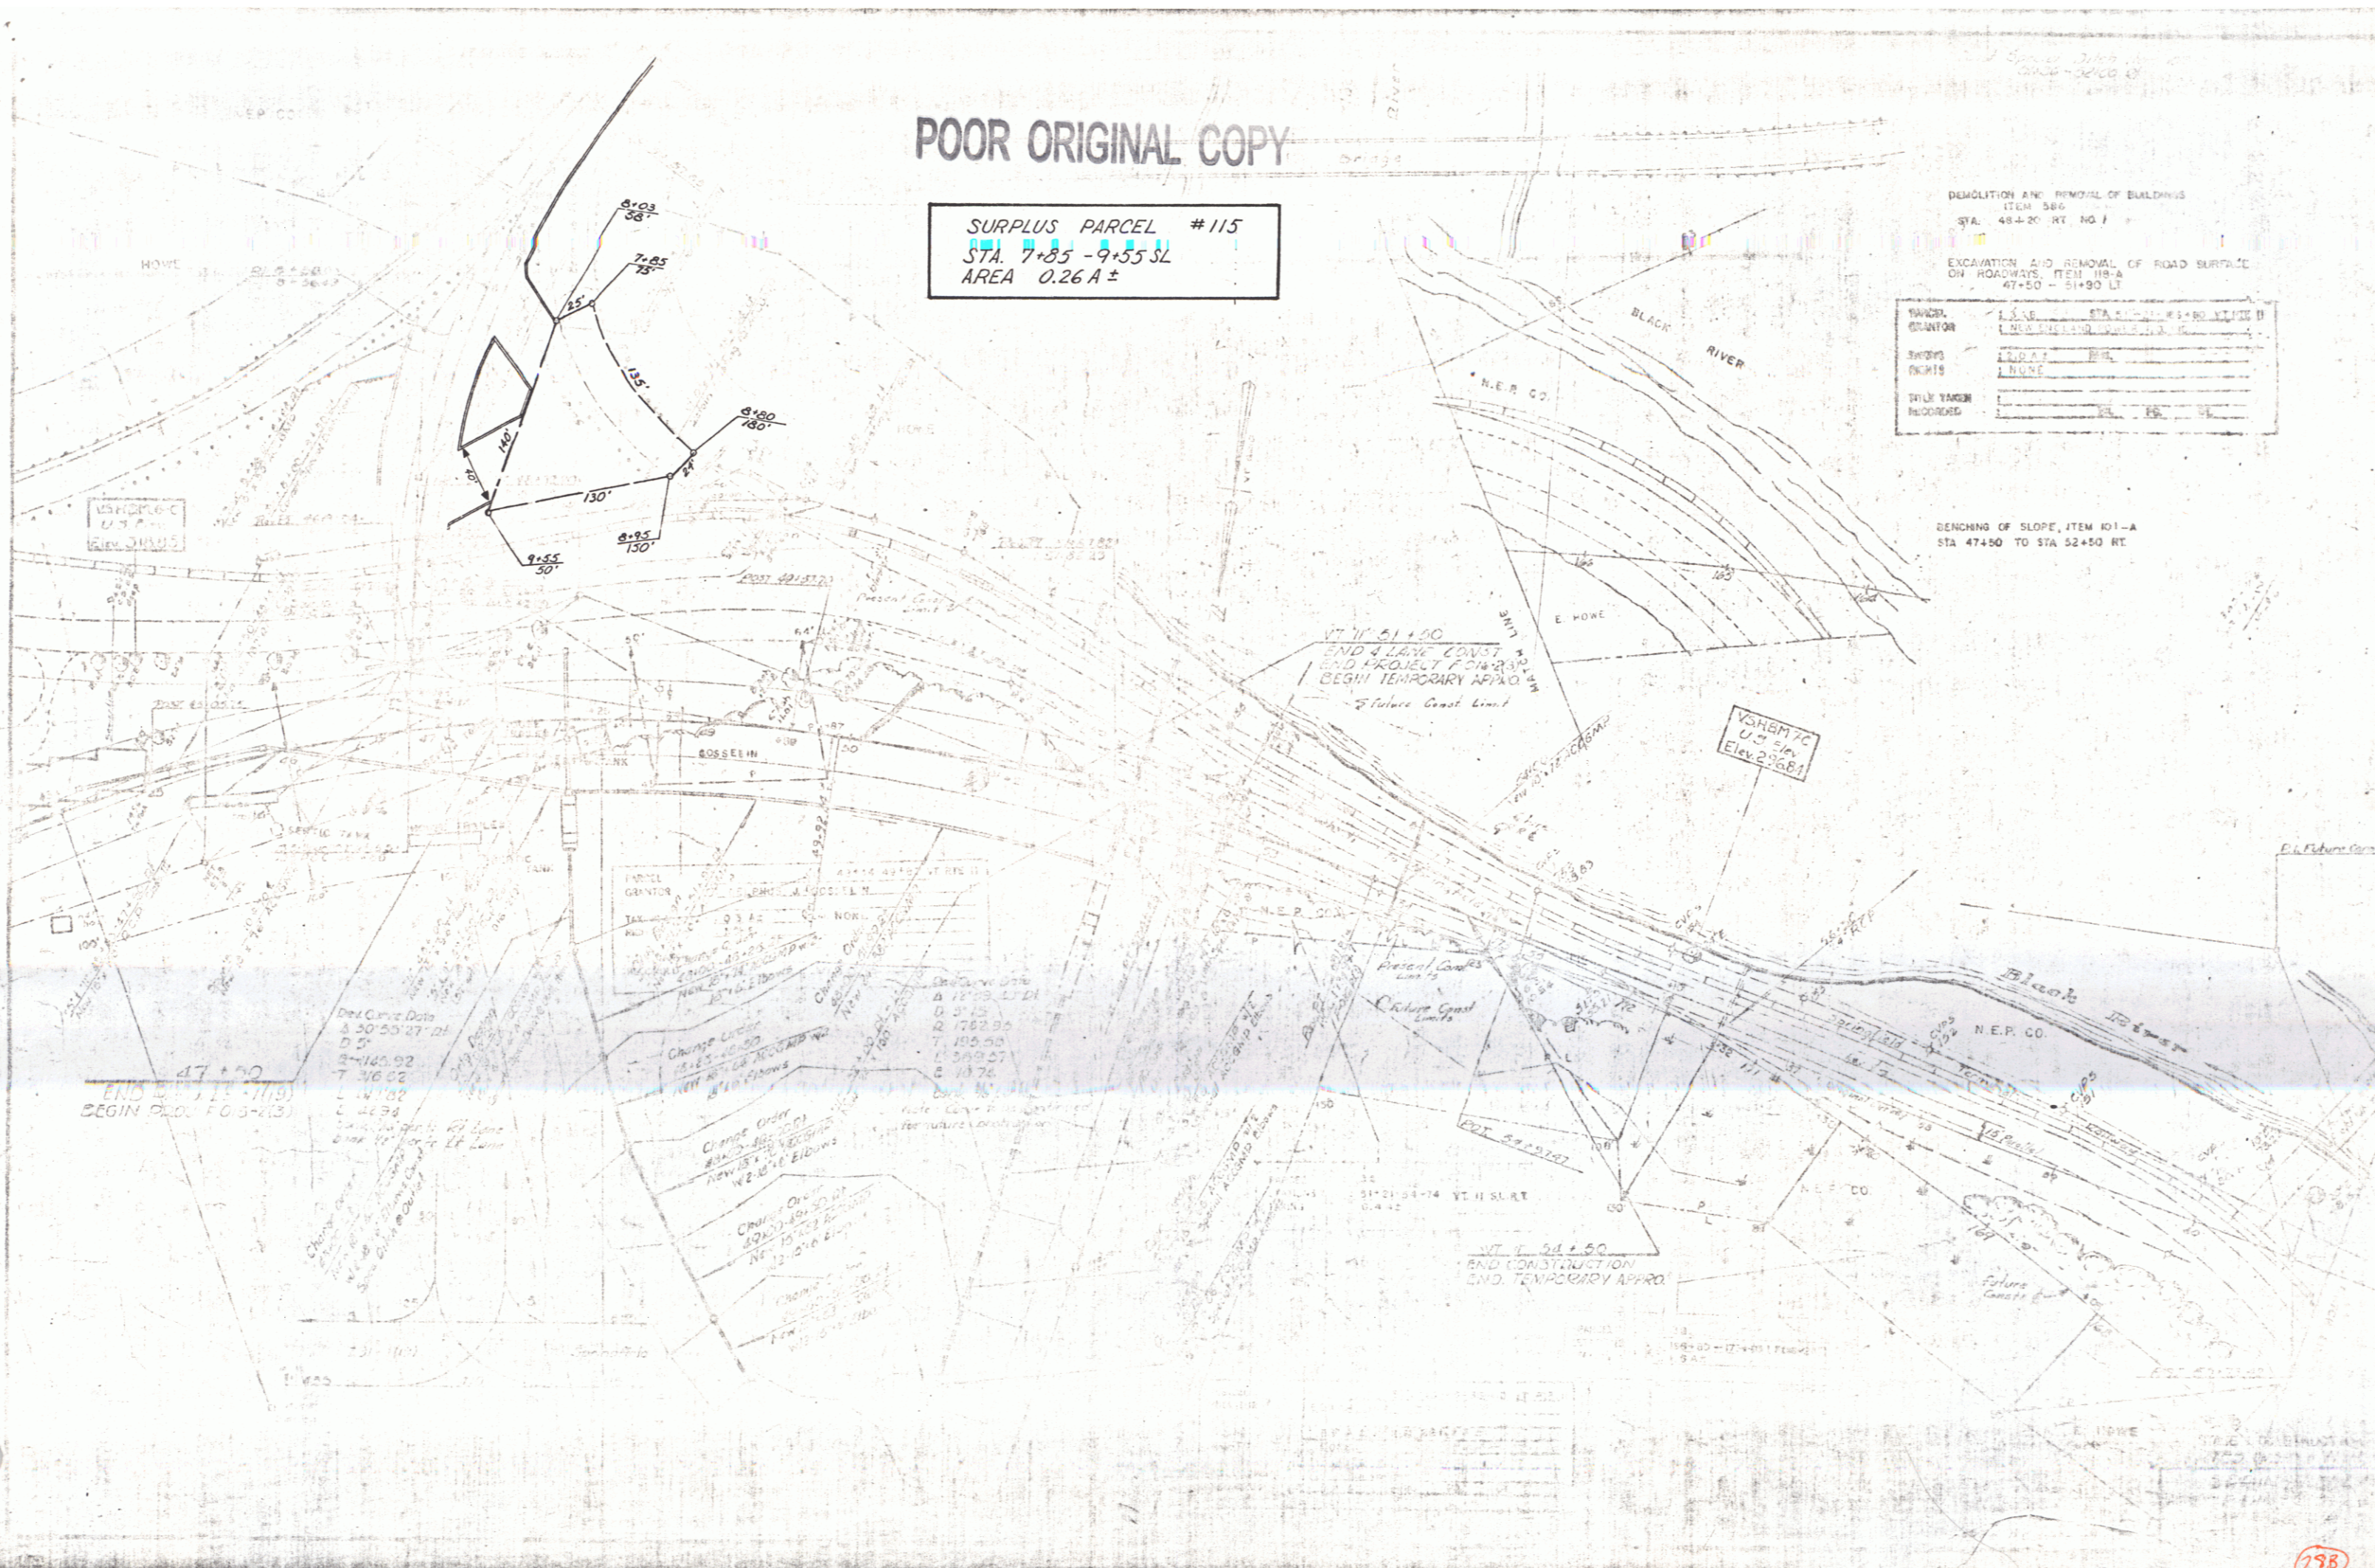

298