
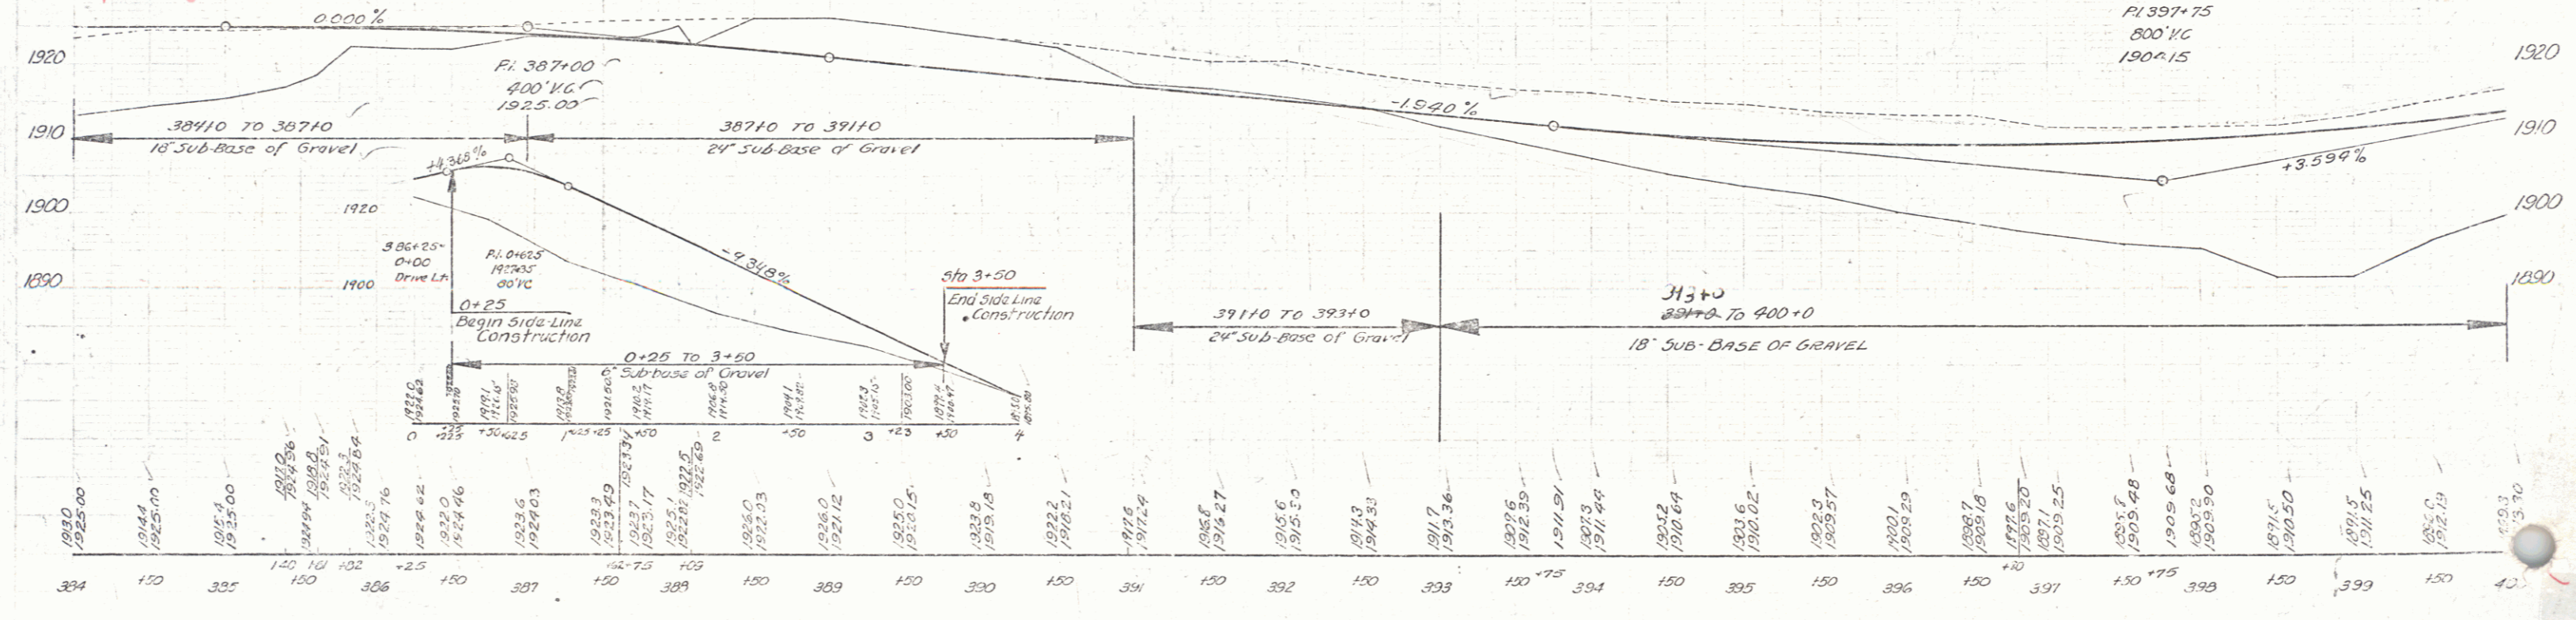


PARCEL	INSTRUMENT	DATE	GRANTOR	GRANTEE	RECORDED PERU	REMARKS
#12A	WDOE	2-20-45	WILLIAM & ALICE LOCKHART	ST. OF VT.	BOOK 17 PAGE 310	5-18-45
#8 C	WDOE	2-18-45	ALFRED M. BEST	ST. OF VT.	17 567	5-18-45 #8 ACROSS 8-FOOT ON ST. 9
#10	COND.	12	NORMAN & LUCY STEVENSON	"	17 166-173	10-25-46
#11 A	AGRMT.	1-30-47	TIDE WATER ASSOC. OIL CO., OF N.Y. ST. OF VT.	"	17 216	6-10-47 } B Lgs 385+50 ± R

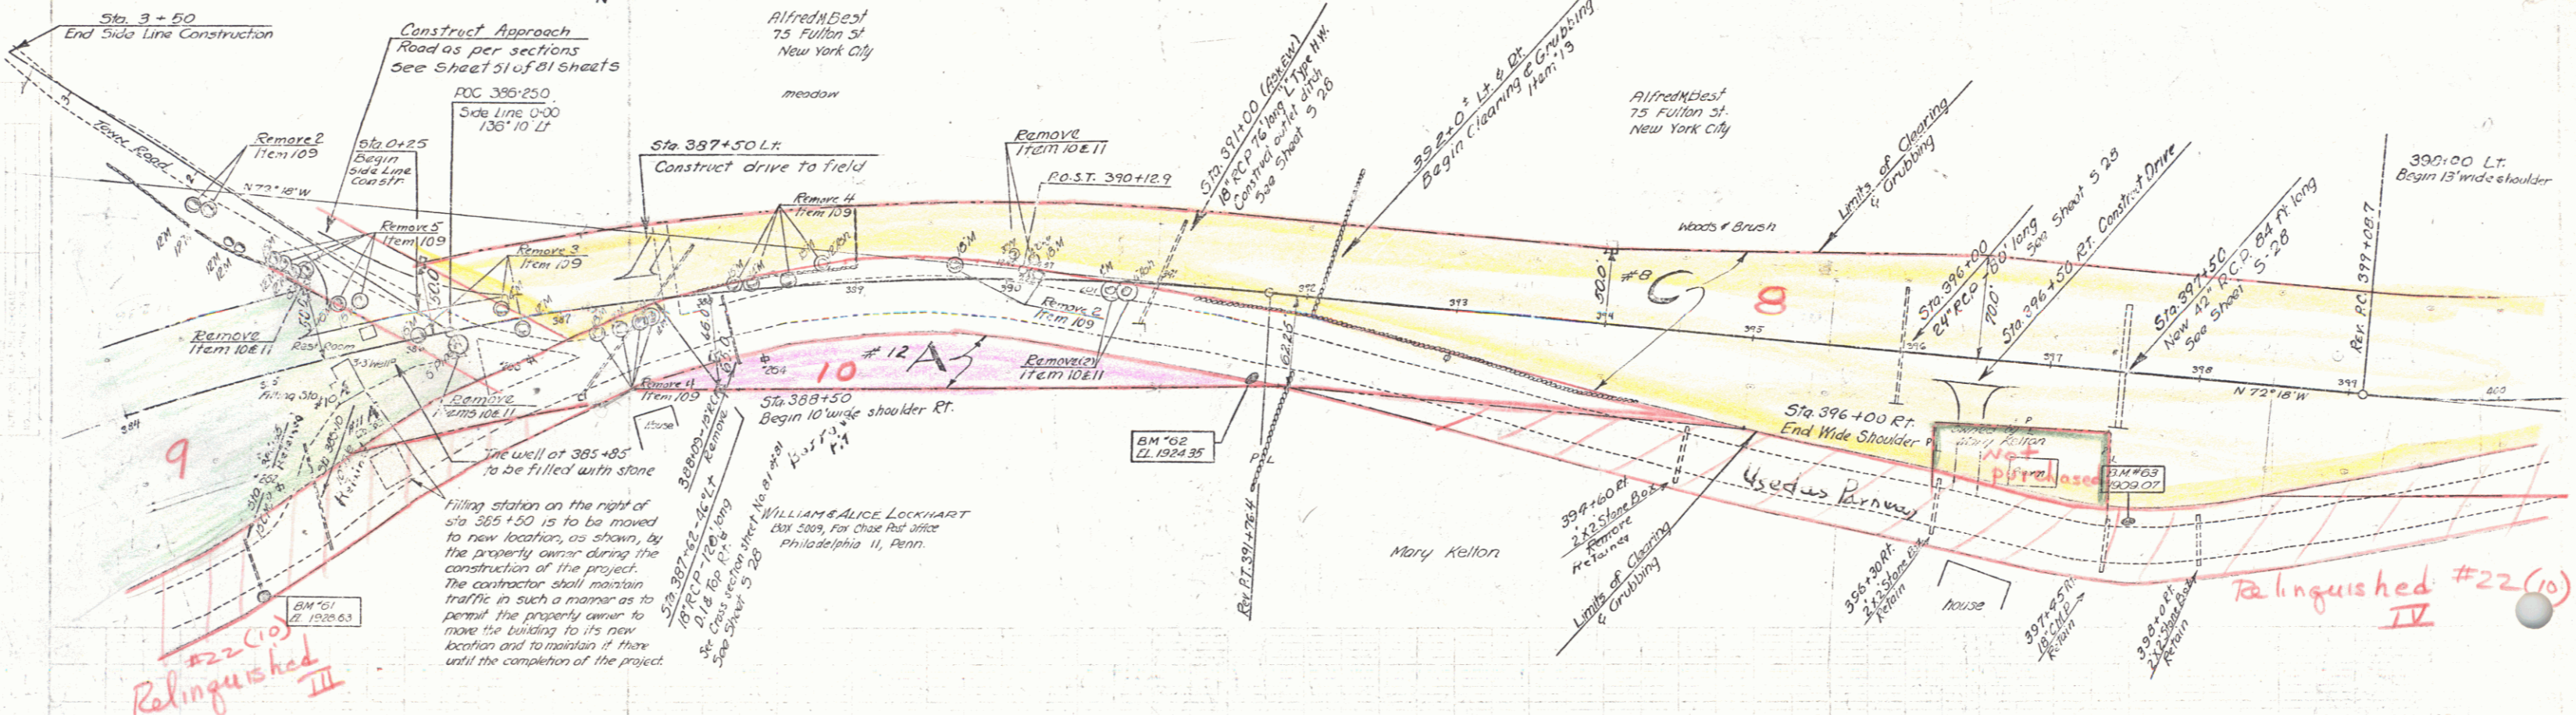

B.M. #61 Spot on boulder 140' Rt. Sta. 384+30 elev. 1926.63
 B.M. #62 Spot on boulder 337' Rt. Sta. 397+70 elev. 1921.31
 B.M. #63 Spot on boulder 100' Rt. Sta. 397+60 elev. 1920.07