


WOOD GUIDE POSTS  
Sta. Lt. Rth.  
12100 - 1

REINF. CONC. PIPE CULVERTS  
Sta. Diam. Leng. C.R.M.  
12100 18" 46' 1.5%


FED. ROAD DIST. NO. STATE PROJ. NO. FISCAL YEAR SHEET NO. TOTAL SHEETS  
3 VT. C-99-C 1932 5 13

R.D. # 100  
L.M. 1/12  
1/12

R.D. # 100  
L.M. 1/12  
1/12

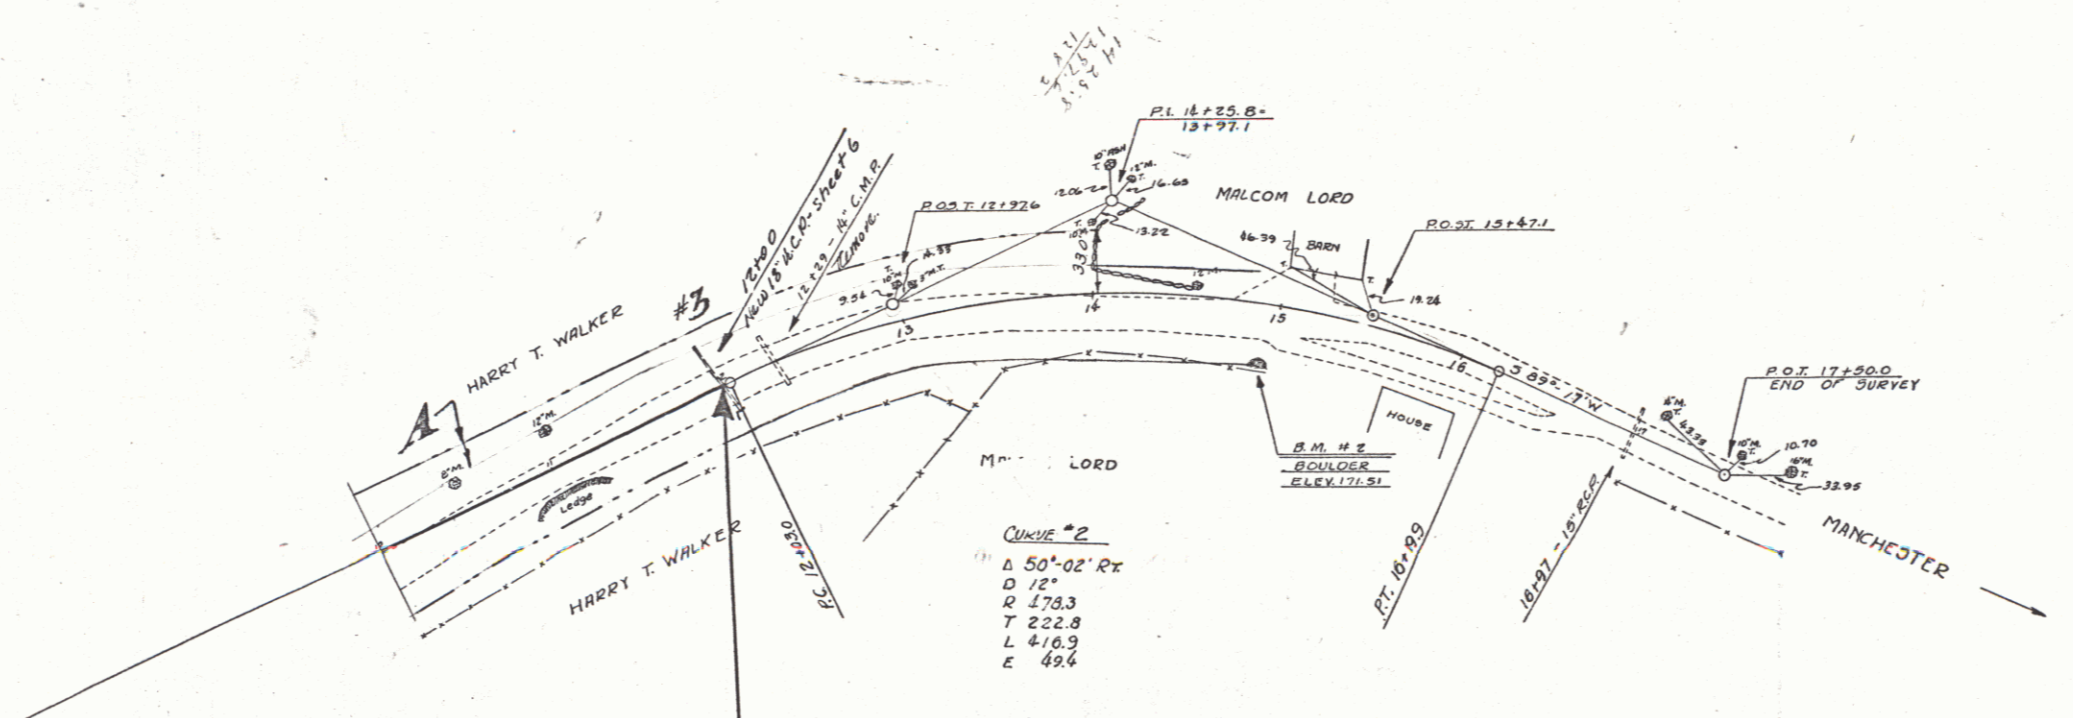

PARCEL INSTRUMENT	DATE	GRANTOR	GRANTEE	RECORDED	REMARKS
A-D	Q.C.D.	10-25-32	H.T. & J. WALKER & J. RUSSELL	ST. OF VT.	DATE CUL #3 1/6 26/27 11-21-32 12+00

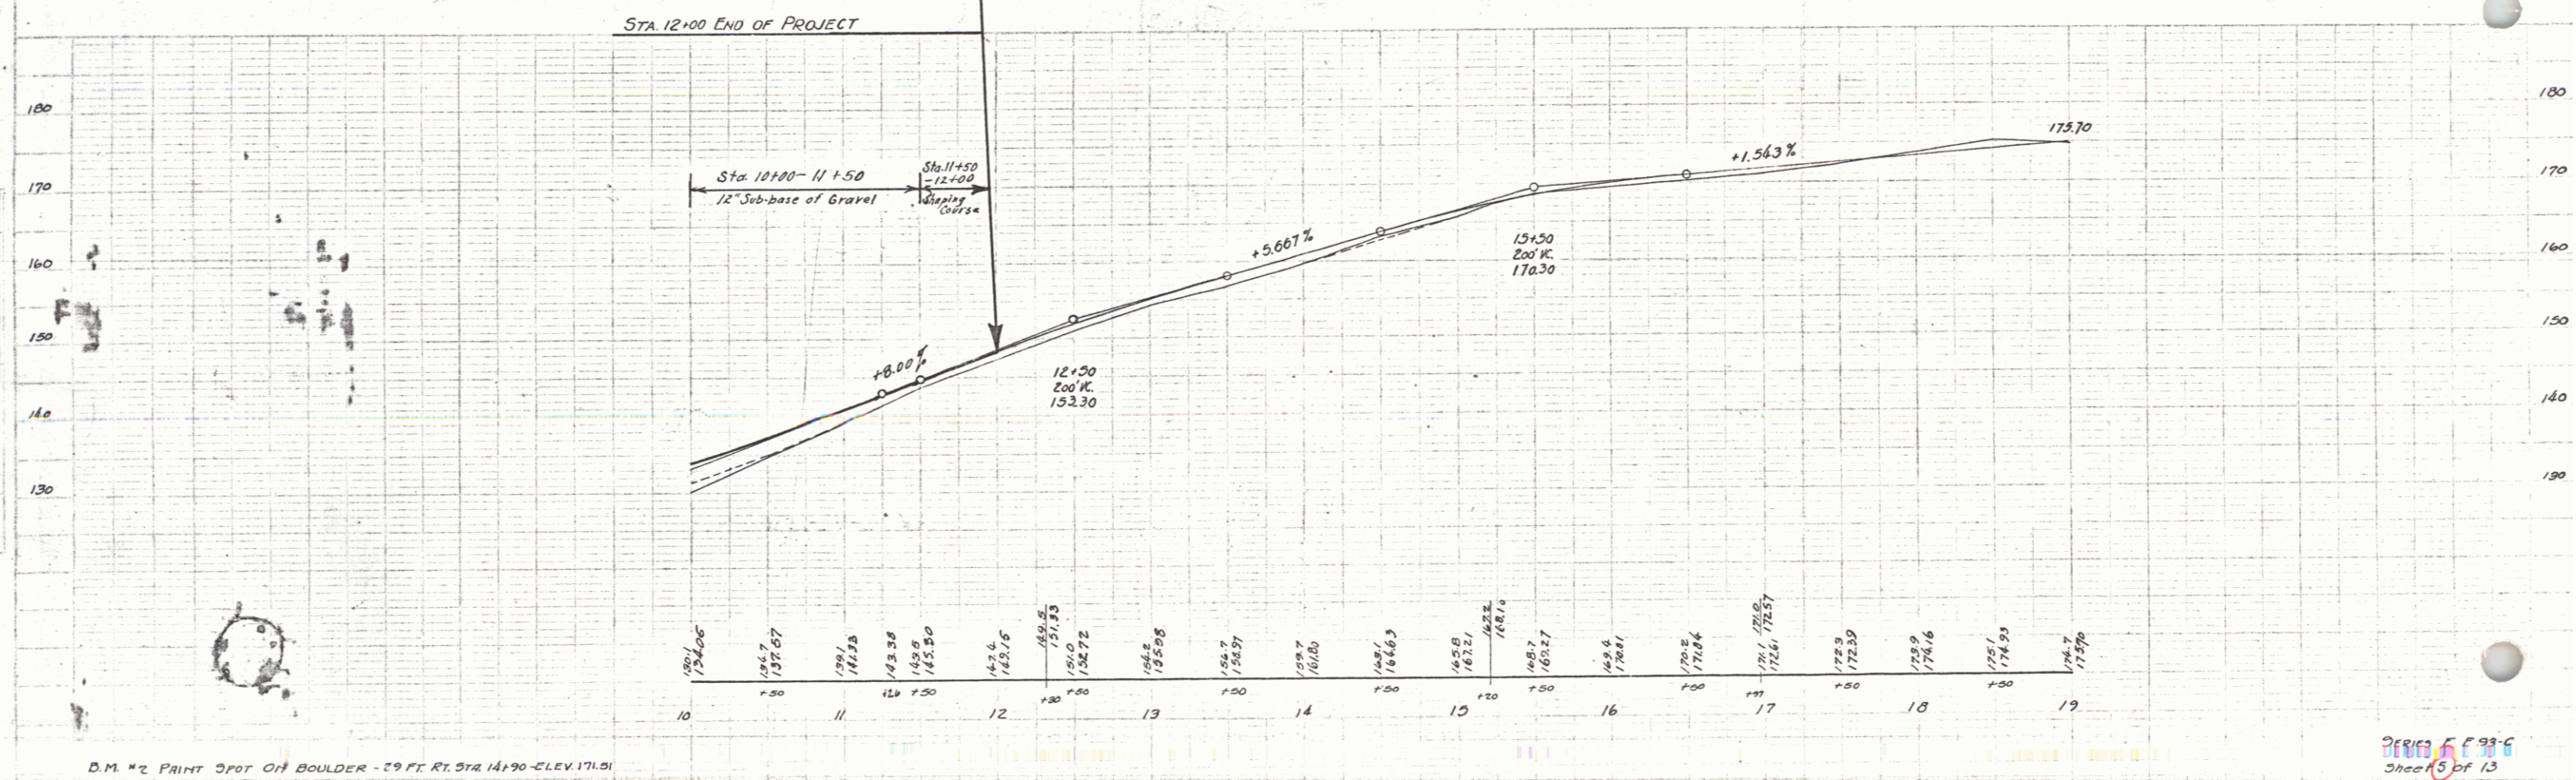

D.M. #2 PRINT SPOT ON BOULDER - 29 FT. RT. STA. 14+90 - ELEV. 171.51

SERIES C-99-C  
Sheet 5 of 13

3