


WOOD GUIDE POSTS			CADLE GUARD RAIL			NEW CAST IRON PIPE CULVERTS				REINFORCED CONCRETE PIPE CULVERT					
CHAMBER STA	LEFT	RIGHT	STA TO STA	LEN	CONSPANT	PER LENG	STA	DIAM	LEN	CONC	STEEL	STATION	SIZE	LENG	C.M.
8+50	-	1	2+80-5+80	LT 350'	40'	34"	4+10	36"	95'	2.3%	25"	8+60	18"	52'	1.8%
			3+80-4+88	RT 128'	40'	1.65"									
			7+50-12+44	LT 464'	40'	504"									

FLAR
DATE: 10/25/32
BY: J.E.K.
SCALE: 1"=40'

FLAR
DATE: 10/25/32
BY: J.J.R.
SCALE: 1"=40'

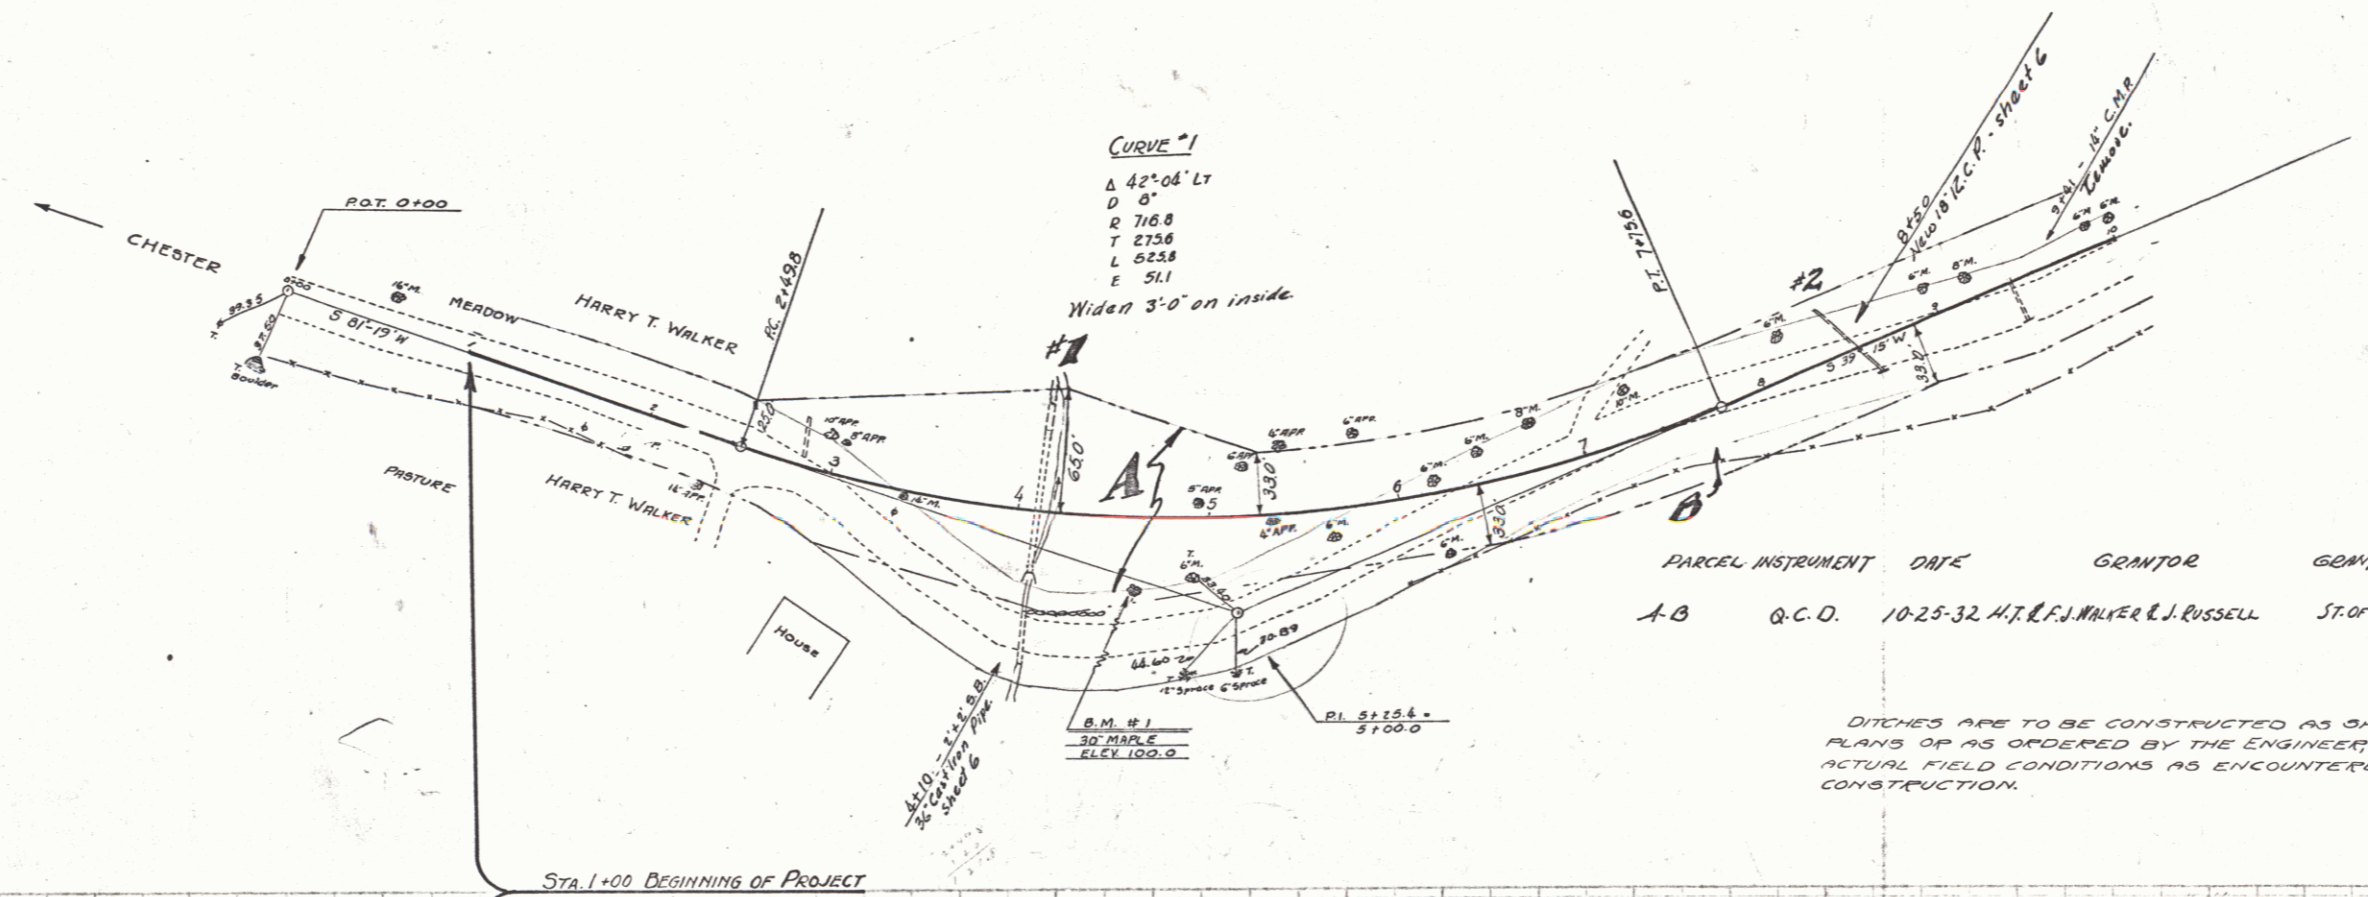

PARCEL	INSTRUMENT	DATE	GRANTOR	GRANTEE	RECORDED	REMARKS
A-B	Q.C.D.	10-25-32	H.T. WALKER & J. RUSSELL	ST. OF VT.	BOOK PAGE DATE	CULSPR-2-3 K110 8+300 12.4.00

DITCHES ARE TO BE CONSTRUCTED AS SHOWN ON THE PLANS OR AS ORDERED BY THE ENGINEER, TO MEET THE ACTUAL FIELD CONDITIONS AS ENCOUNTERED DURING CONSTRUCTION.

