


BM #19 Elev. 734.01 - F 100 (II)  
 U.S. P.B.M. Elev. 1368.59 - F 93 (II)  
 Difference 634.58

PARCEL	INSTRUMENT	DATE	GRANTOR	GRANTEE	RECORDED LANDGROVE	REMARKS
#1 A	W.D.O.E.	9-2-47	AUGUST W & ELIZABETH J. SCHORCH	ST. OF VT.	BOOK PAGE DATE G 429-430 9-11-47.	
#2 A	" " "	7-22-47	ARTHUR & MILDRED BUELL	" " "	G 419-420 7-22-47	
#3 A	ADMIN. DEED	4-7-48	G.B. DAVIS, EST.	ST. OF VT.	G 518-519 4-12-48	CULM REL.

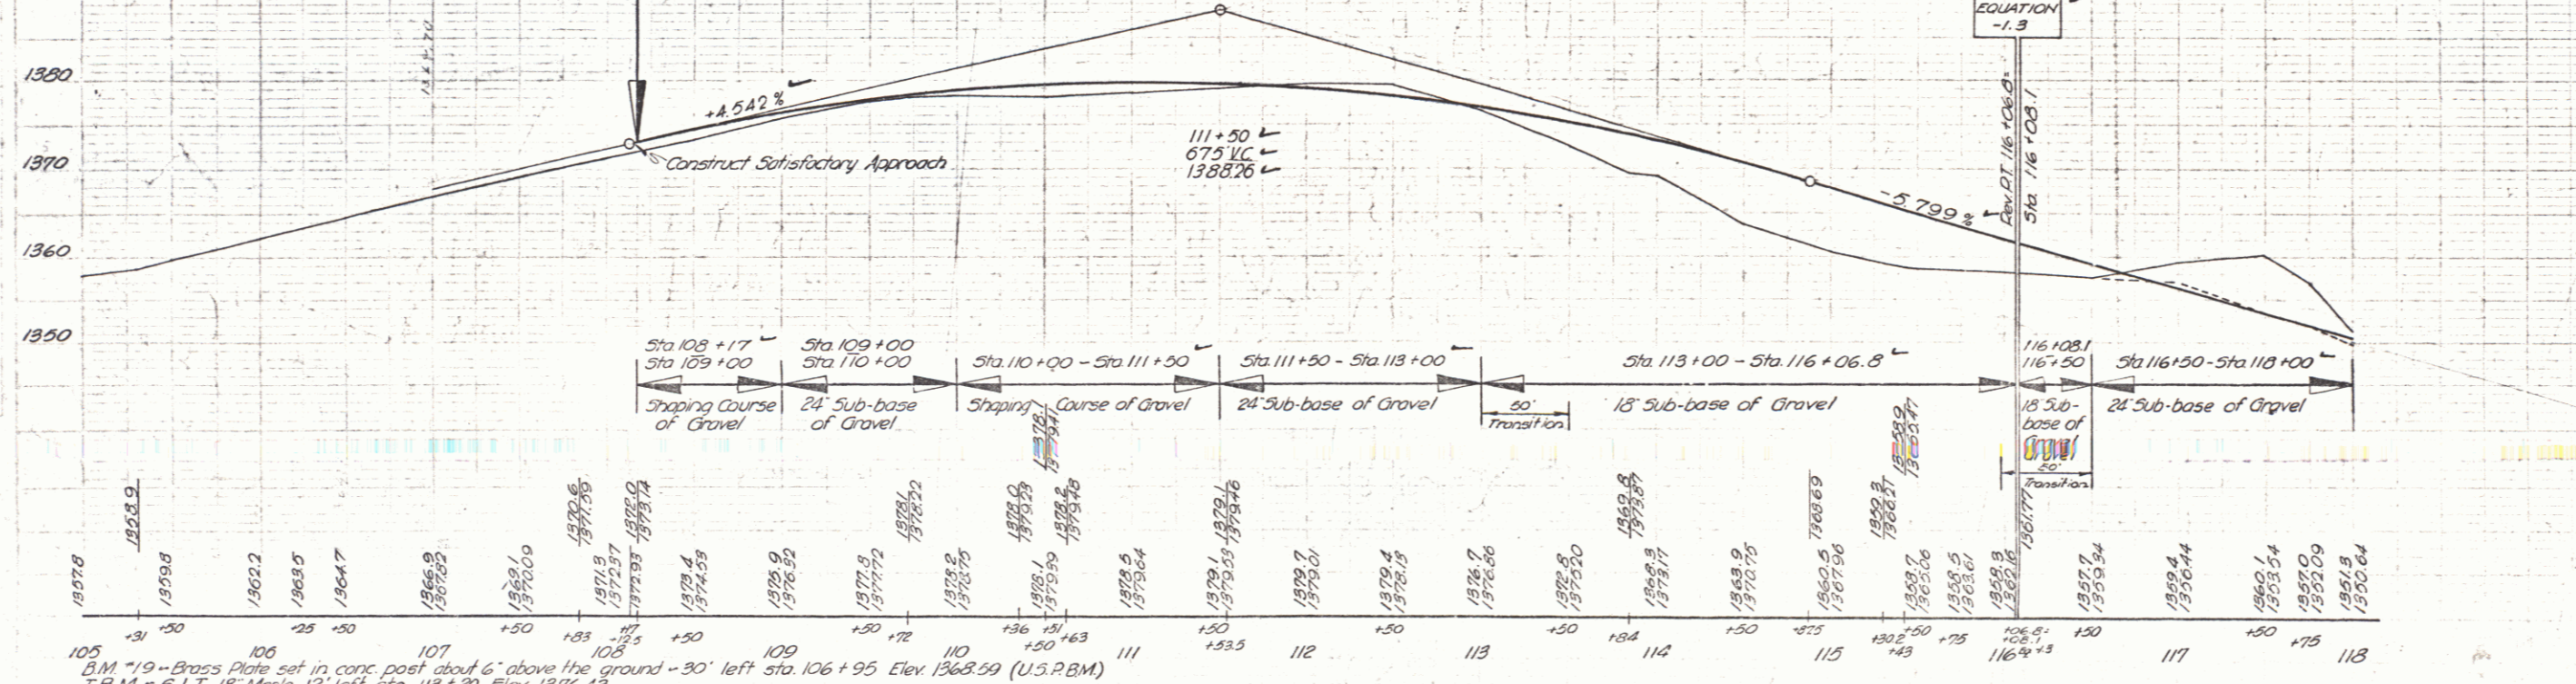

105 BM #19 - Brass Plate set in conc. post about 6" above the ground - 30' left sta. 106+95 Elev. 1368.59 (U.S.P.B.M.)  
 106 T.B.M. - 5.1 T. 18 Maple 12' left sta. 113+20 Elev. 1376.43  
 107 B.M. #20 - 5.1 R. 15 Cherry stump 41' left sta. 117+14 Elev. 1358.57