
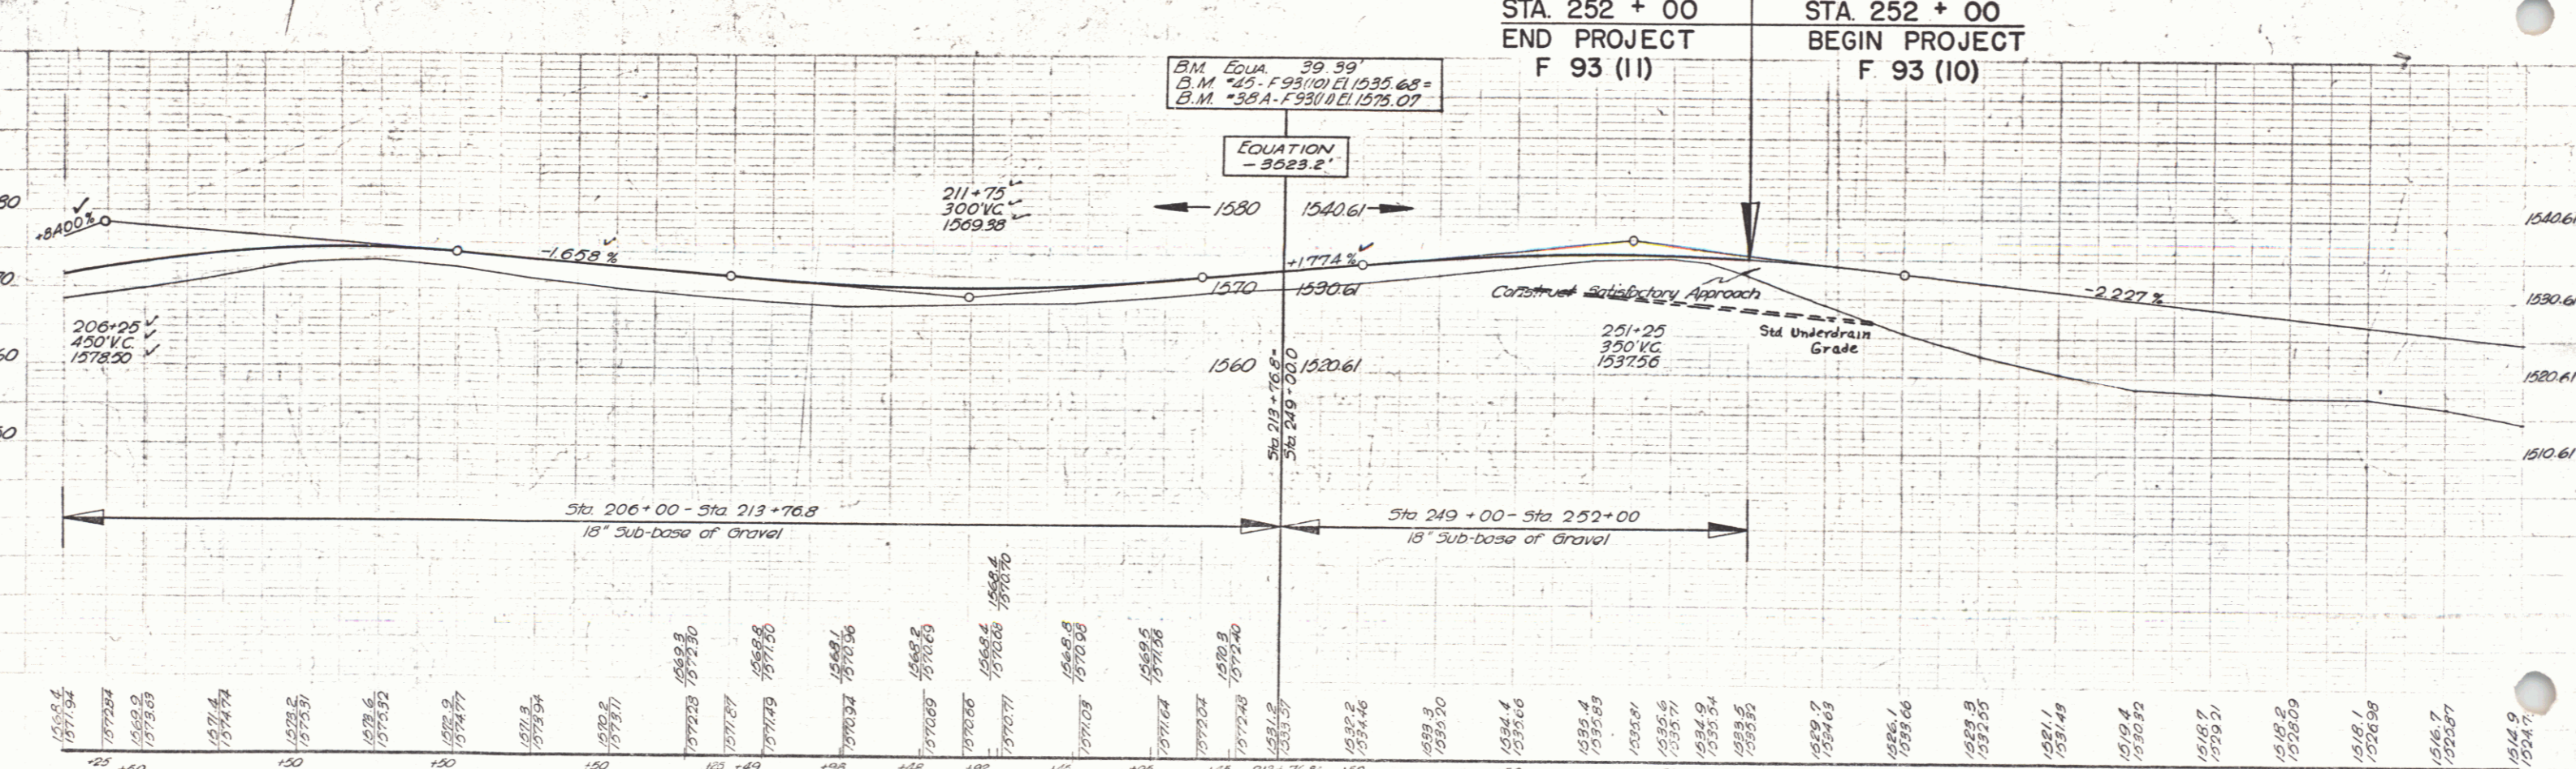


REV CURVE	PARCEL INSTRUMENT DATE	GRANTOR	GRANTEE	RECORDED PERU	REMARKS
D 4' 27" Lt	#16 A, B, C, D, E W.D.O.E. 9-3-47	CHARLES H. & LILLIAN B. GRANT	ST. OF VT.	BOOK 17	#16 A, B, C, D, E
D 5729.65'	#16 A, B, C 9-2-47	FRANCE C. KENT		DATE 9-12-47	#16 A, B ON SH. II
T 222.6'					
L 445.0'					

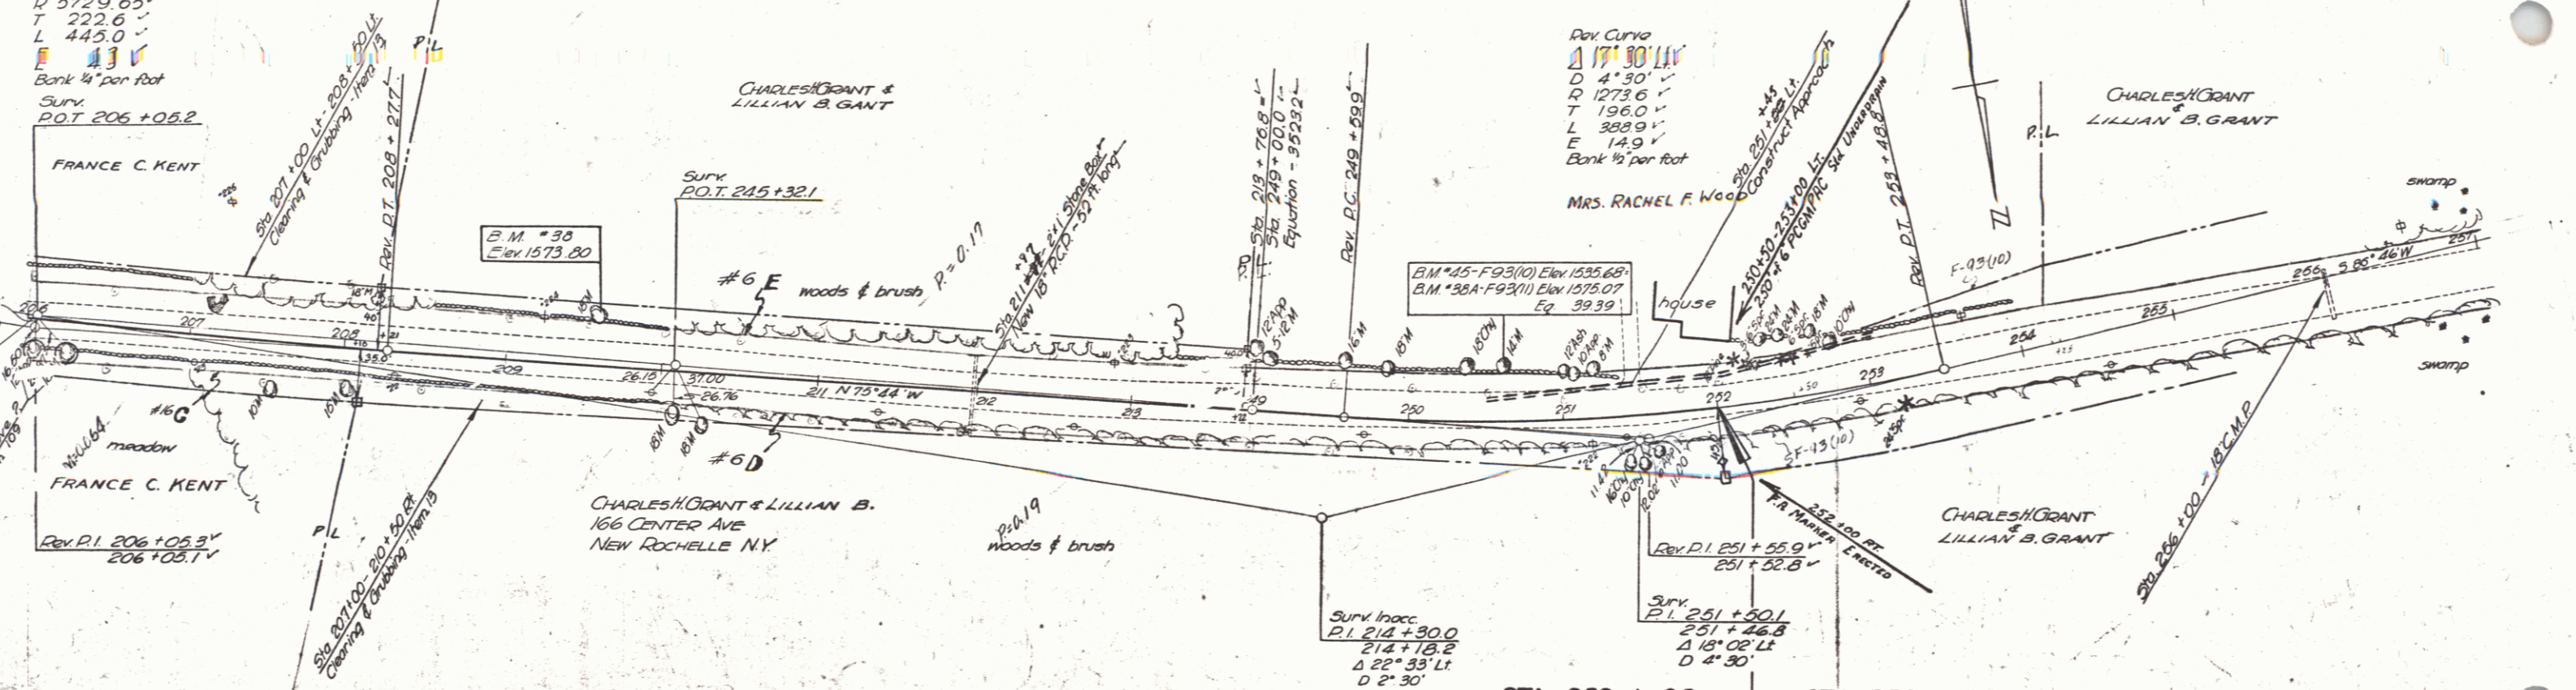

206 B.M. #33 - S.I.R. 18' Maple 27' Lt. Sta. 209+57 Elev. 1573.80
 B.M. #38A - F 93(1) S.I.R. 14' Maple 30' Lt. Sta. 250+60 Elev. 1575.07 - B.M. #45 F 93(10) Elev. 1595.68 - Diff. 39.39'
 256 series F no 93 (1) sheet 12 of 46 sheets LANDGROVE - PERU