


PLAN
 PROJECT: 52100
 SHEET NO.: 52
 DATE: 11/14/07
 DRAWN BY: P. HOFF
 CHECKED BY: C. LANE

PROFILE
 PROJECT: 52100
 SHEET NO.: 52
 DATE: 11/14/07
 DRAWN BY: P. HOFF
 CHECKED BY: C. LANE

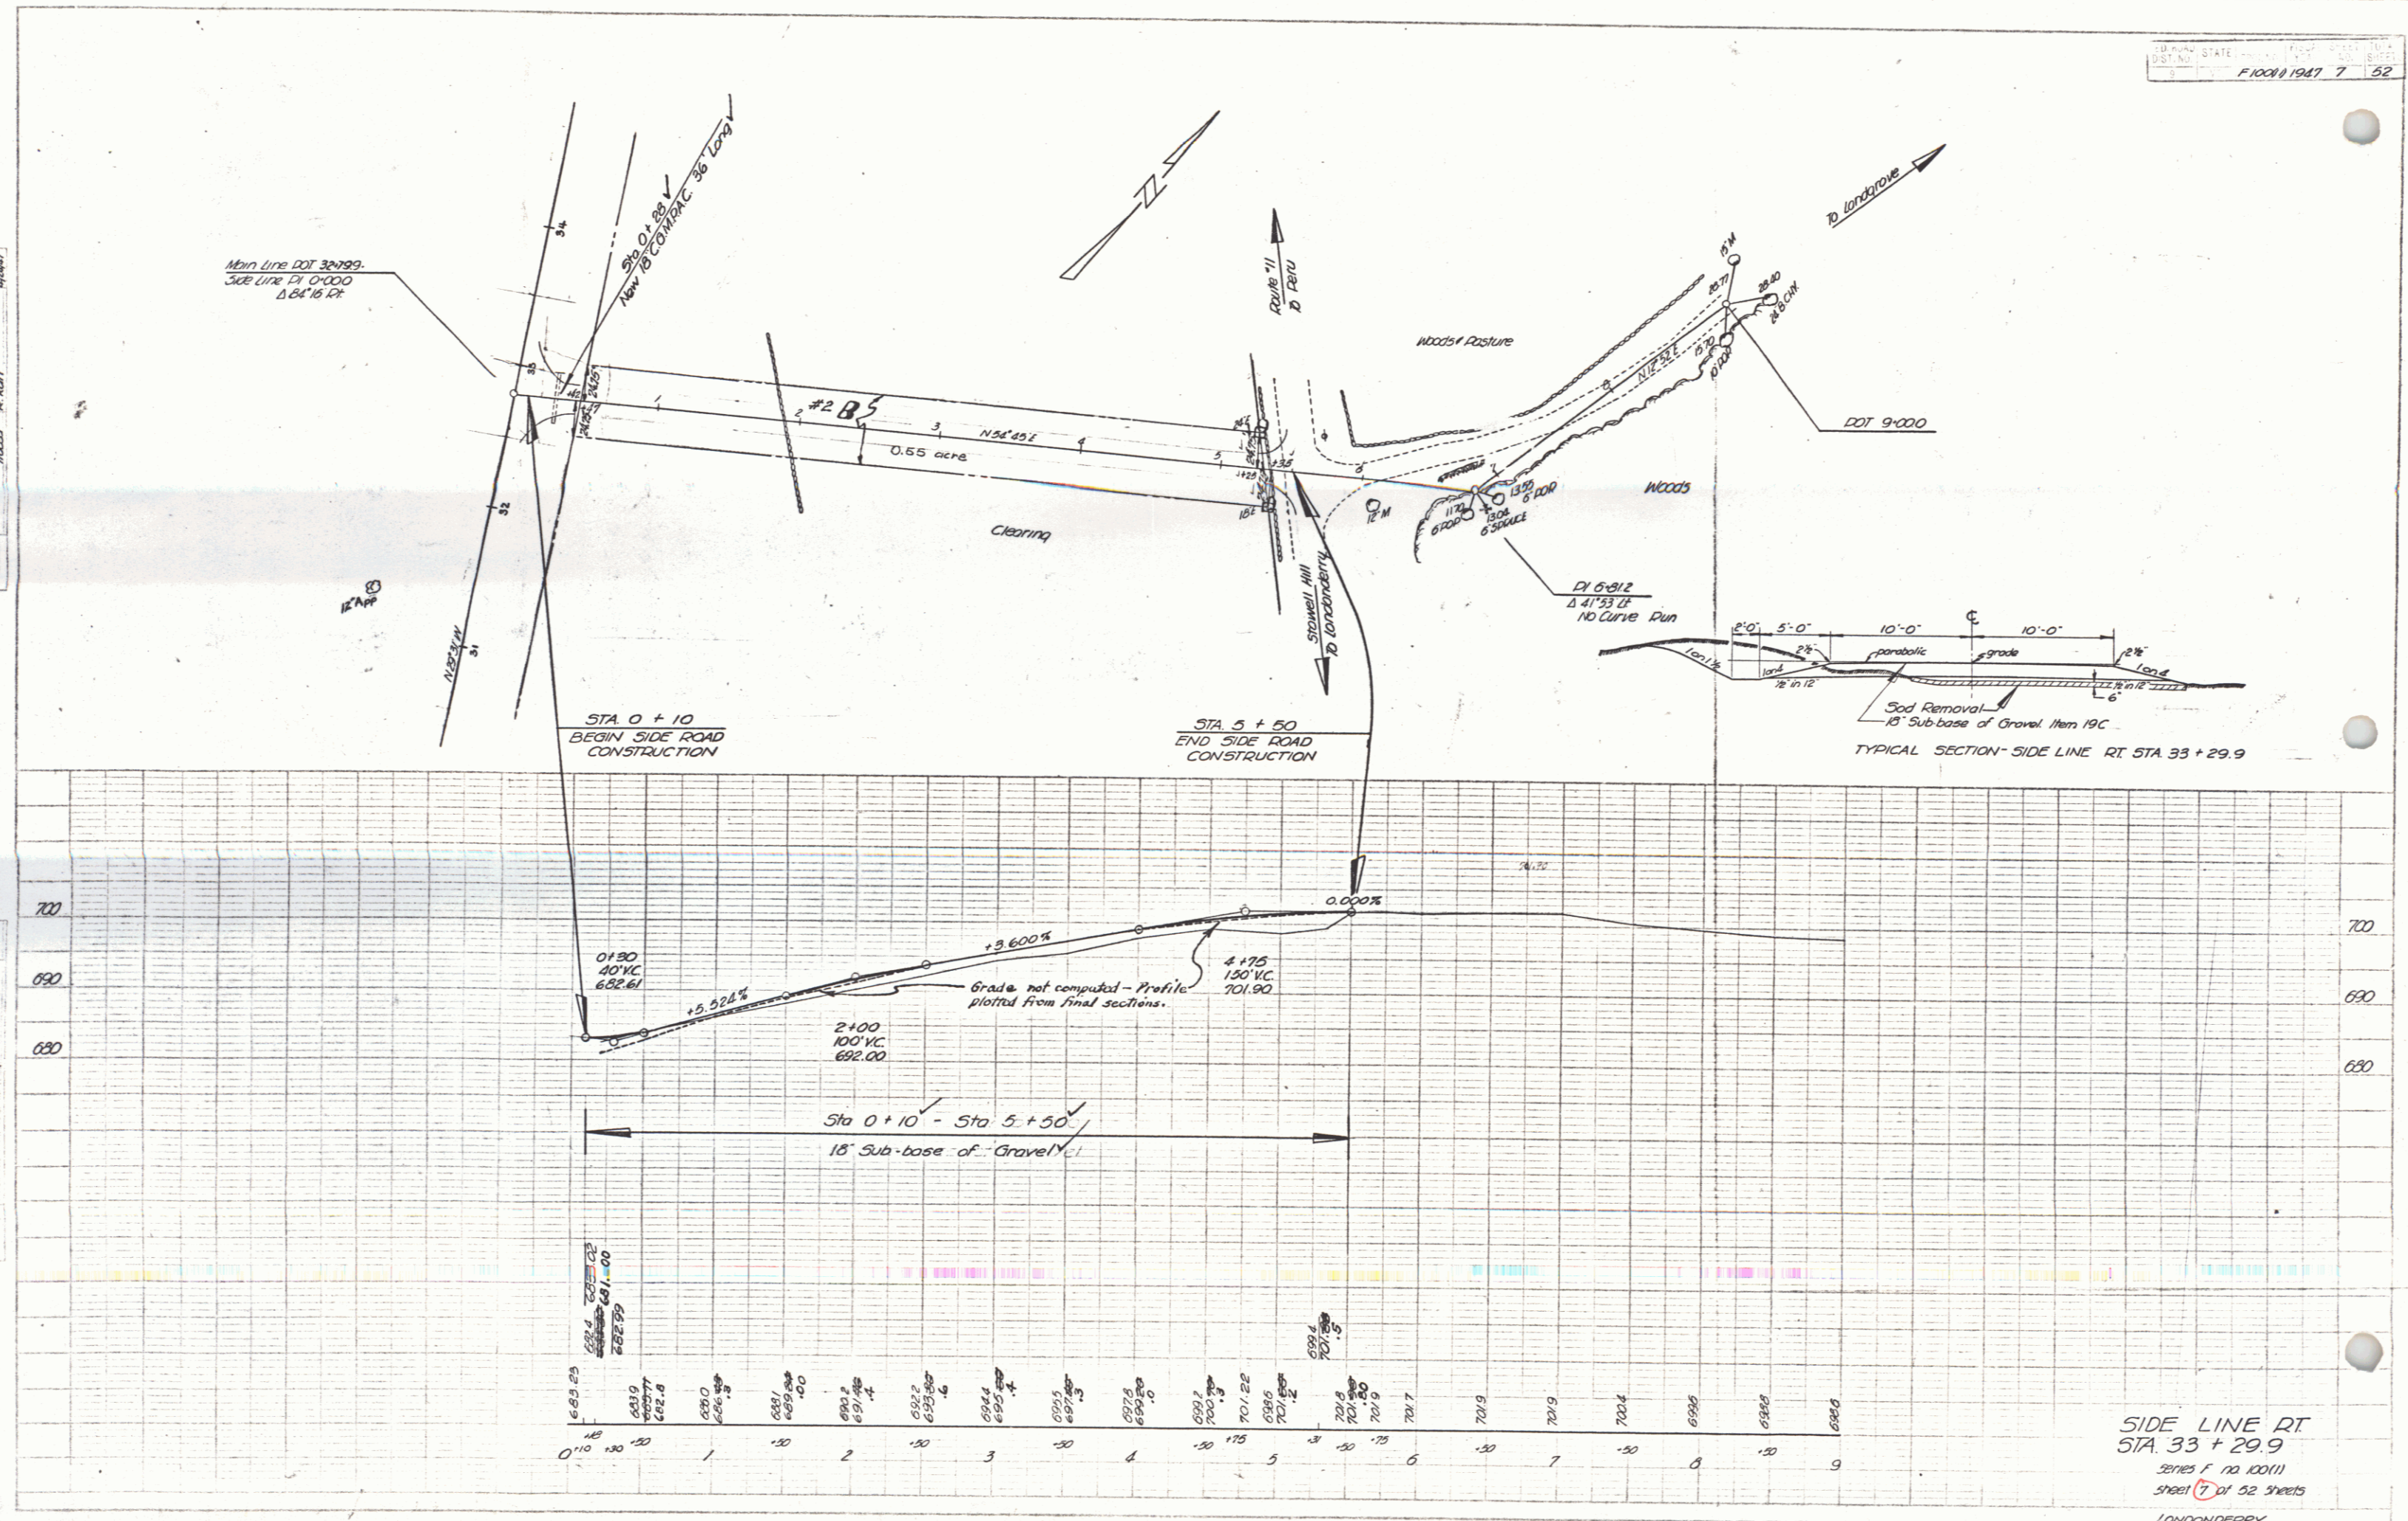

SIDE LINE RT
 STA. 33 + 29.9
 SERIES F no 100111
 SHEET 7 of 52 sheets
 LONDONDERRY