
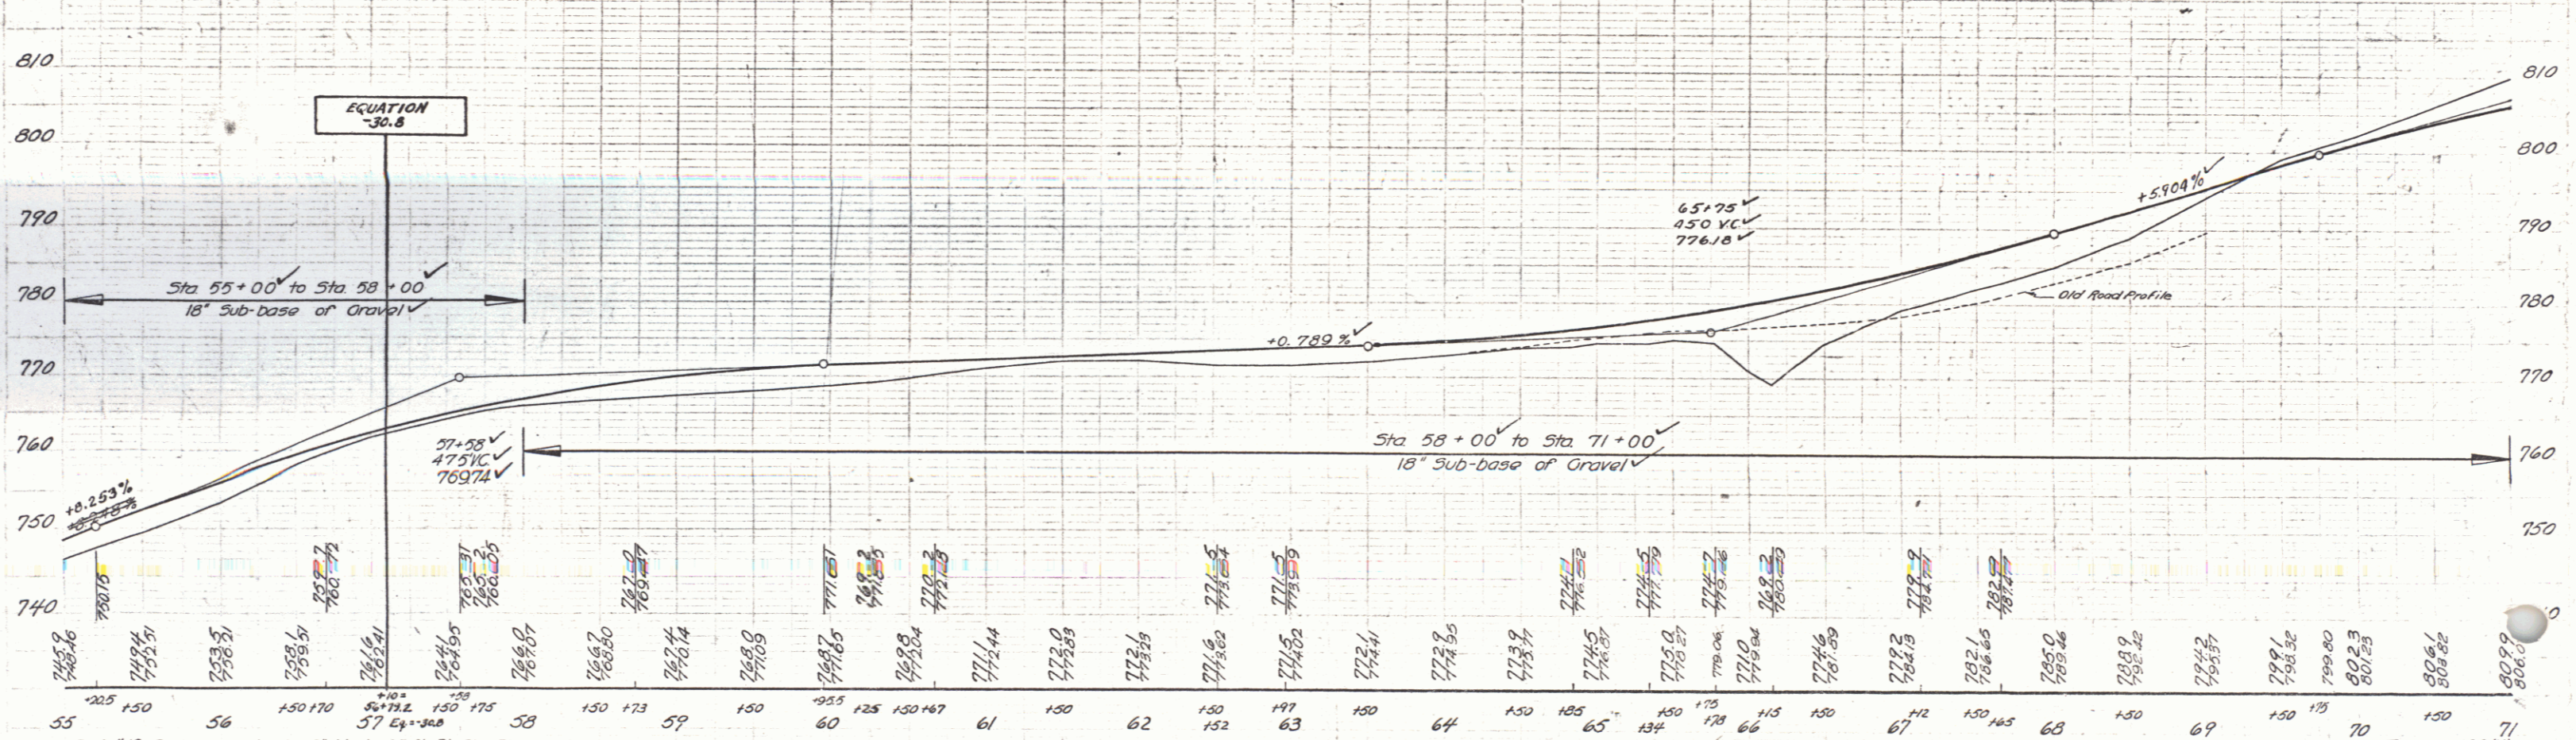


PARCEL INSTRUMENT DATE GRANTOR GRANTEE RECORDED LONDONDERRY REMARKS
 BOOK PAGE DATE
 ABB W.D.Q.E. 7-28-47 CHARLOTTE TAYLOR EST ST.OF VT 26 221 8-27-47

F100(1) 1947 9 52

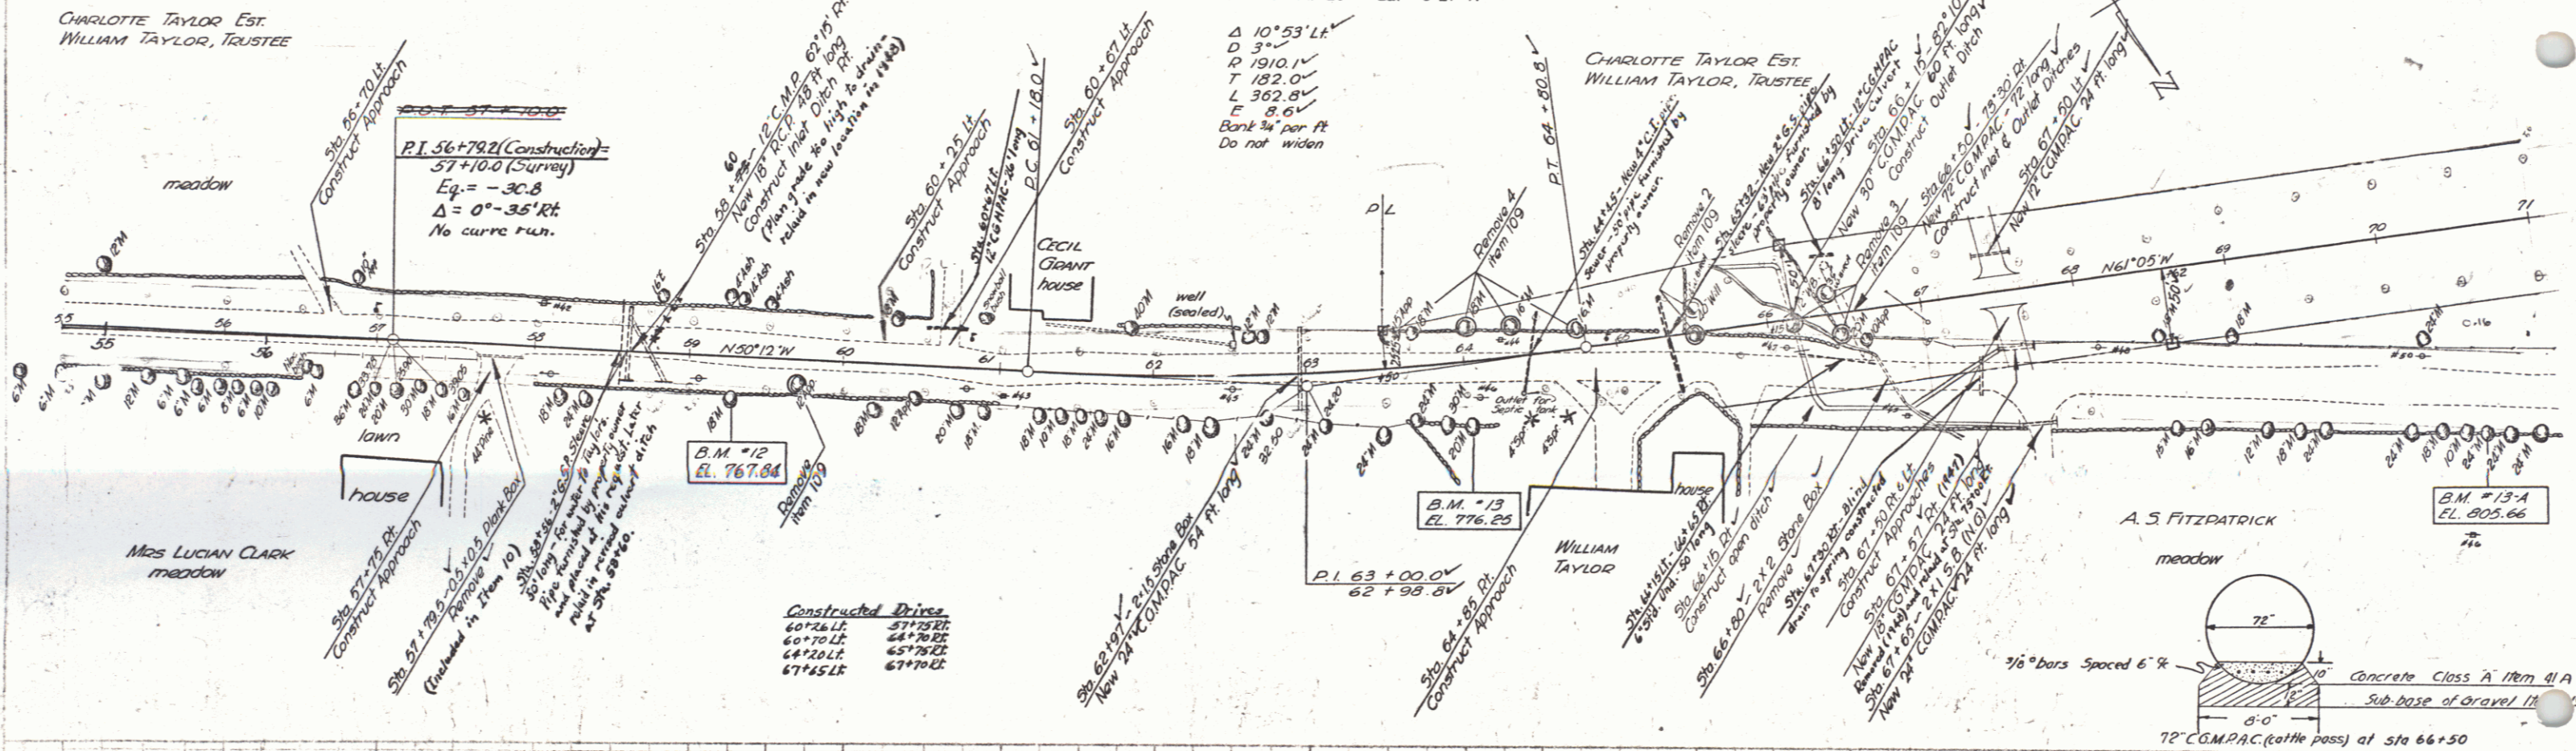

B.M. #12 Spike in root of 18" Maple 25 ft. ft. Sta 59+26 Elev 767.84
 B.M. #13 Spike in root of 20" Maple 25 ft. ft. Sta 64+07 Elev 776.25
 B.M. #13A Spike in root of 24" Maple 34 ft. ft. Sta 70+66 Elev 802.66

series F no 100(11)
 sheet 9 of 52 sheets
 LONDONDERRY