
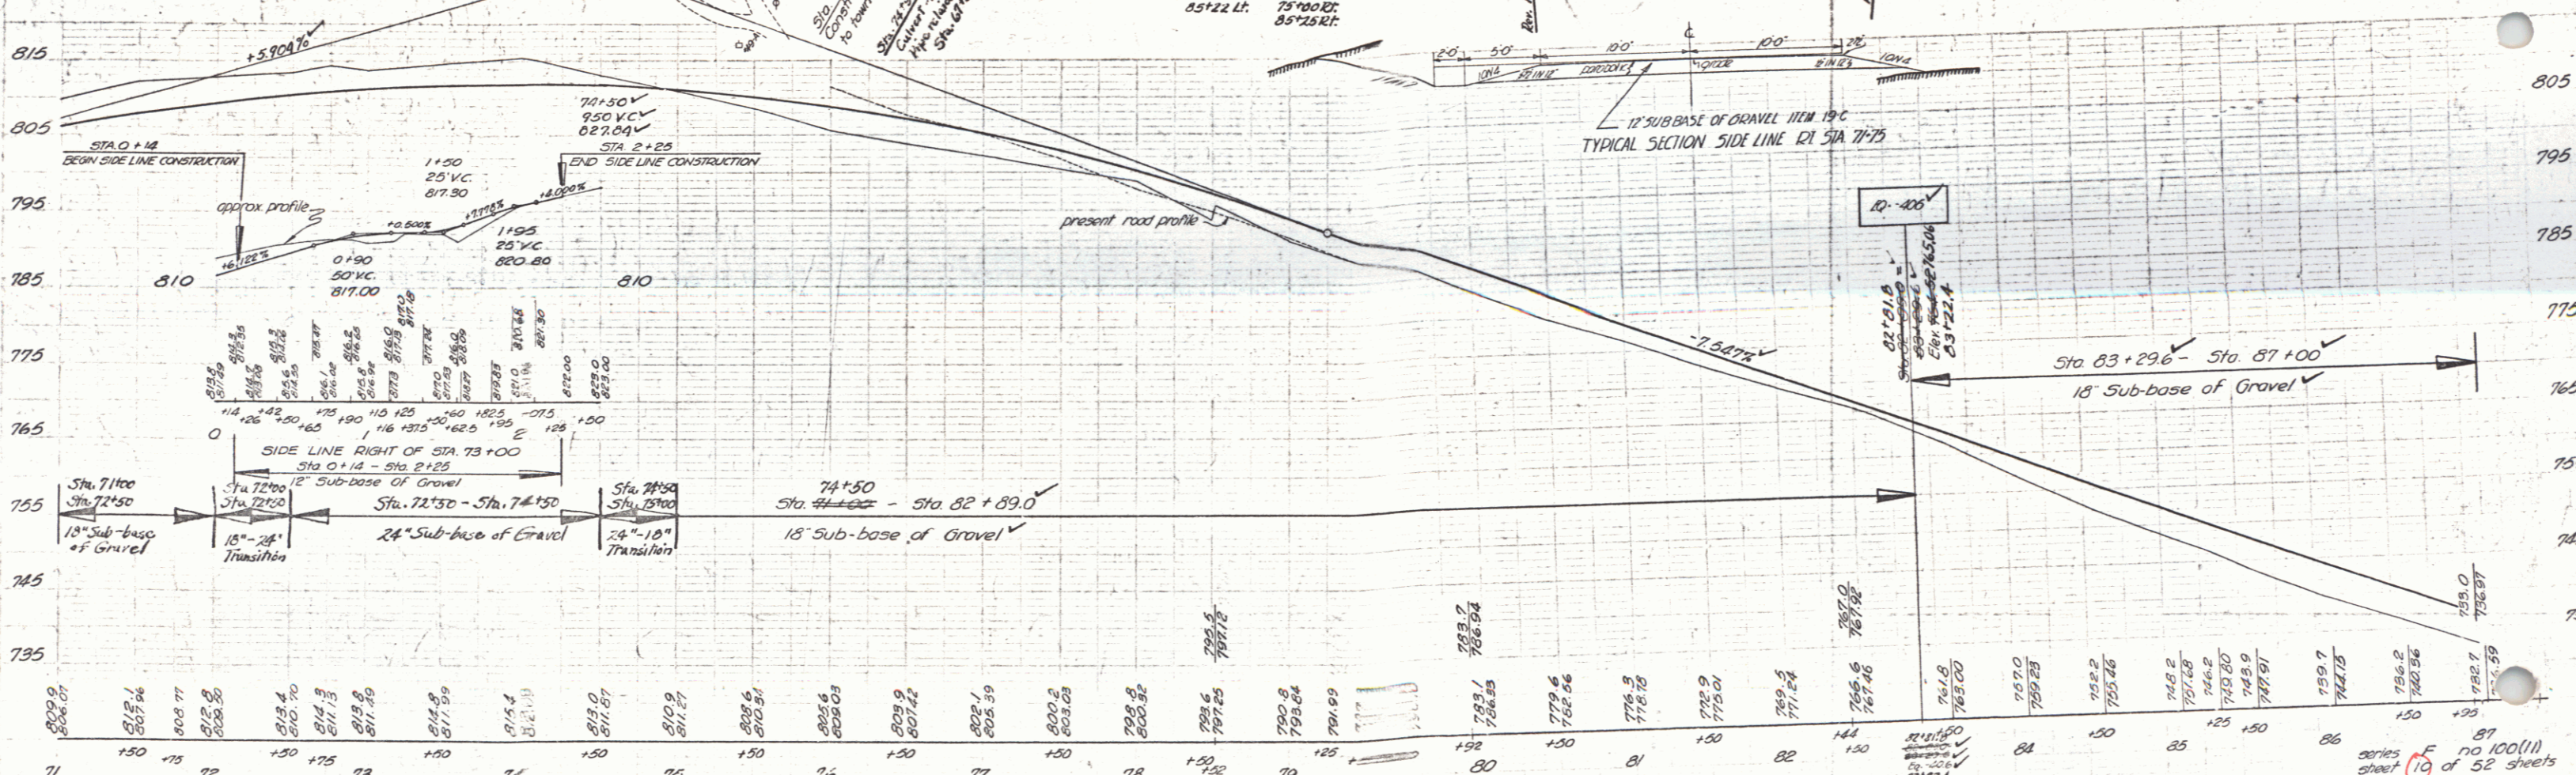


PARCEL	INSTRUMENT	DATE	GRANTOR	GRANTOR LONDONDERRY	REMARKS
#4A	W.D.O.E.	7-29-47	ALEXANDER & GENEVIEVE ST. OF VT. 26	216	8-13-47
#5A,B,C,D	A.D.	4-7-48	G.B. DAVIS ESTATE	260	4-13-48
			FITZPATRICK		#5C CHARLOTTE TAYLOR EST.
					#5D DON WILLIAM TAYLOR, TRUSTEE

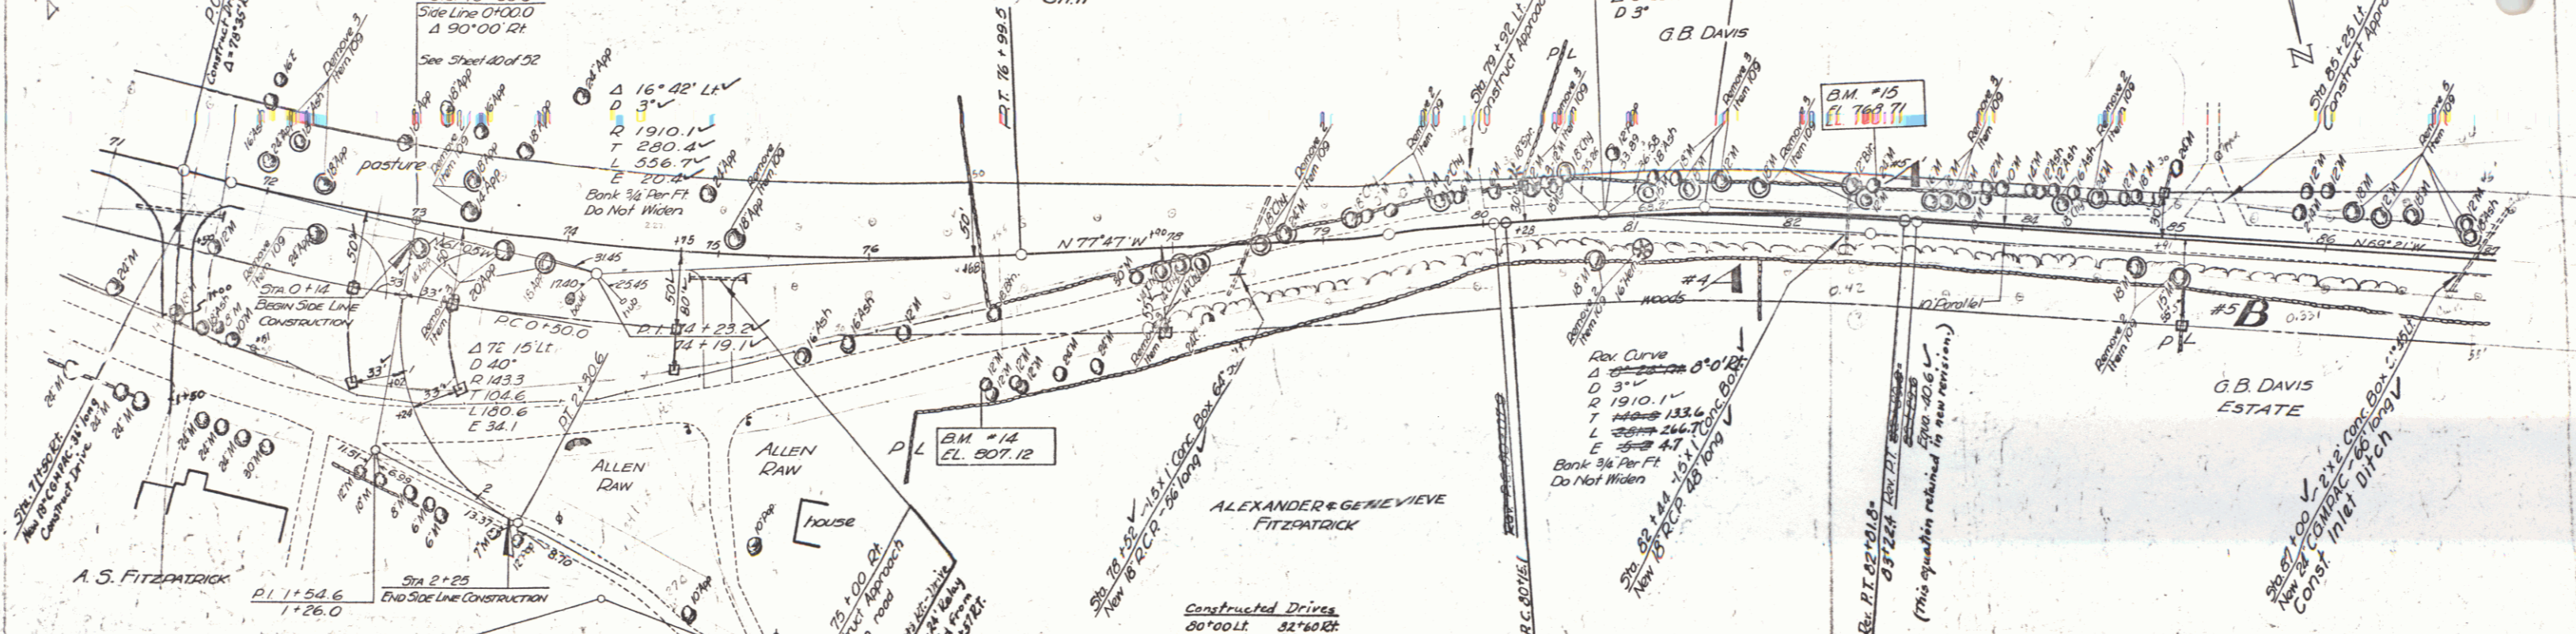

B.M. #14 - 51 P. 12" Maple 80' Rt Sta 76+75 - Elev. 807.12  
 B.M. #15 - 51 R. 24" Maple 18' Lt Sta. 82+55 - Elev. 768.71

FROM 1967 10 52

series sheet 10 of 52 sheets  
 LONDONDERRY