


QCD to Lorenzo W. Duncan
 + Jacqueline E. Duncan
 dated 11/5/71
 BK? Pg?
 "easement to cross over
 land of State of VT."

Re: Project Londonderry FER4
 1940 - Vt. 11
 MM 2.04 - 2.34

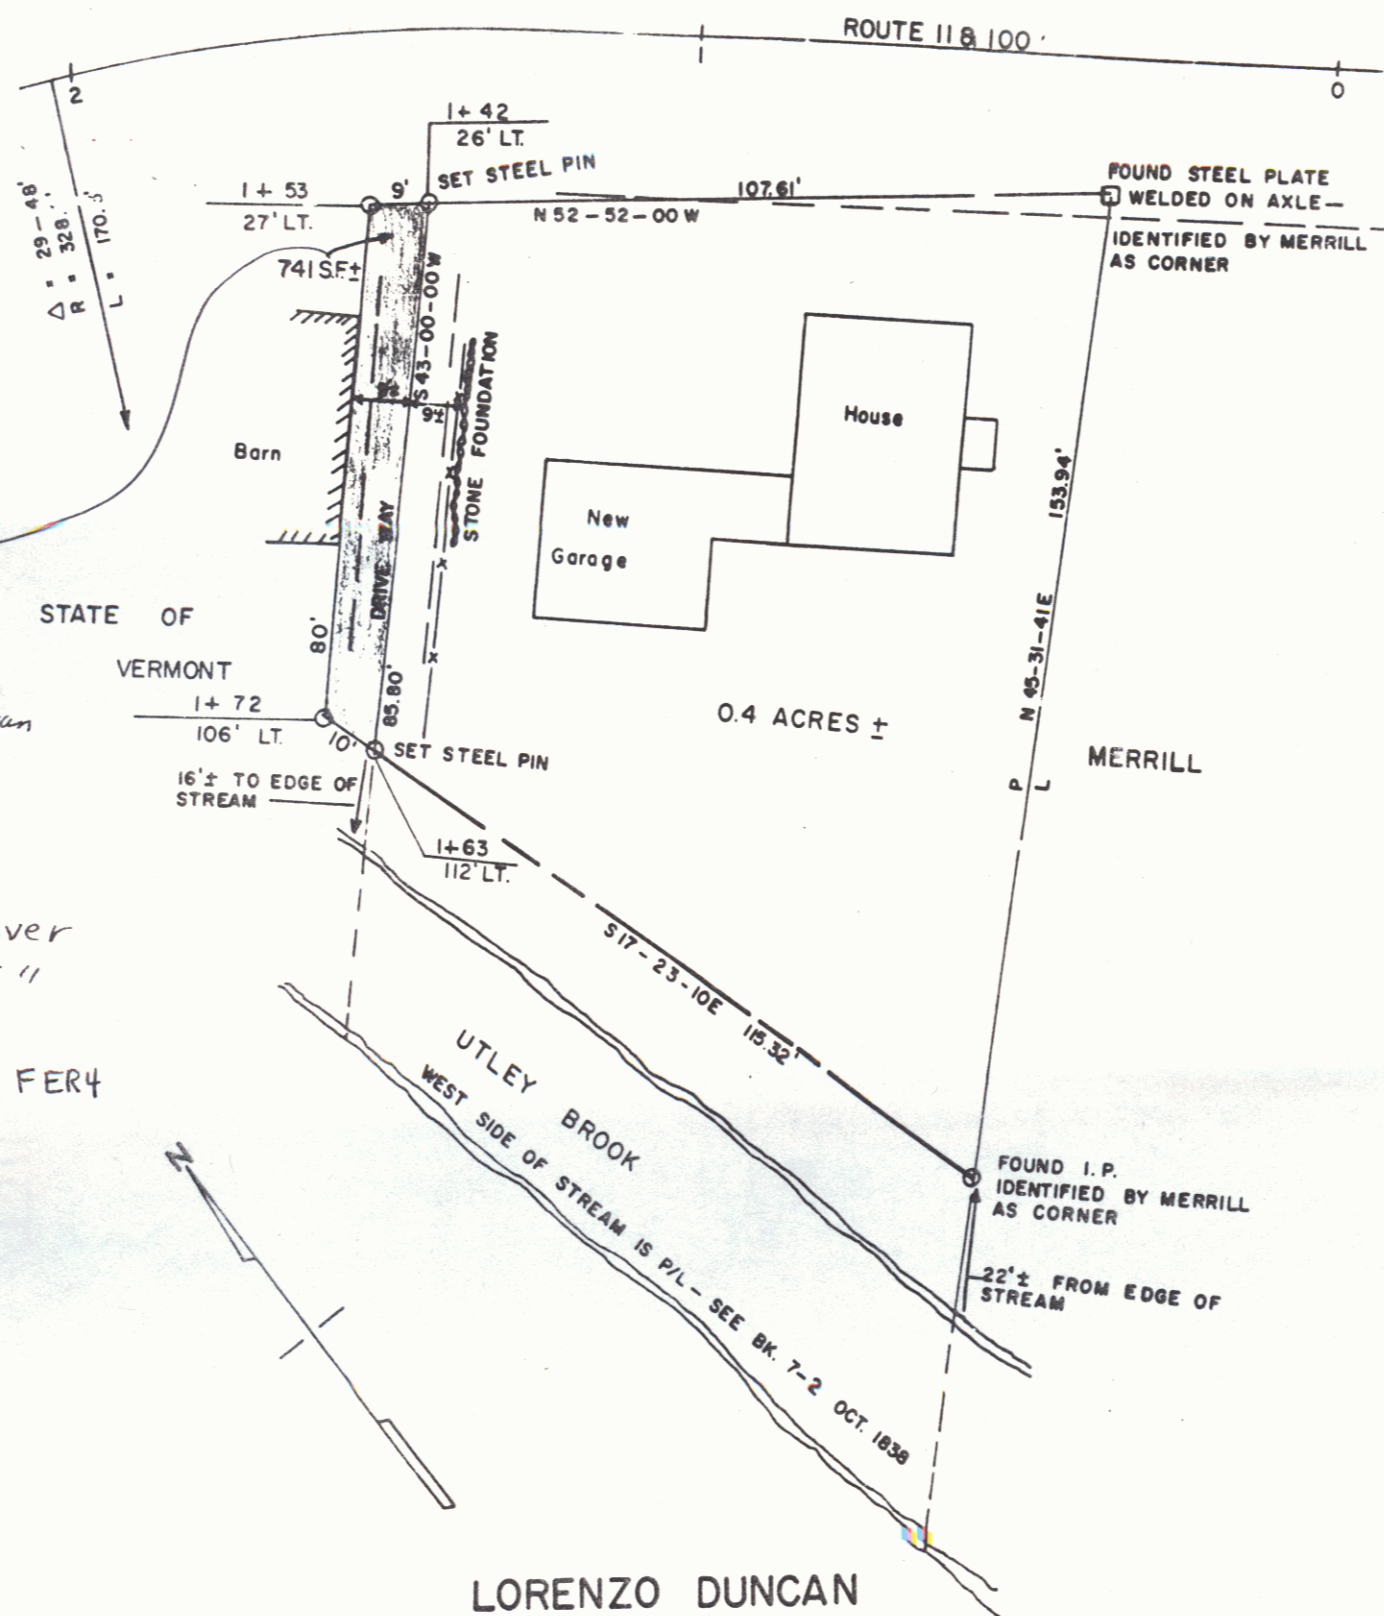

LORENZO DUNCAN
 NOVEMBER, 1970
 NOT TO SCALE
 SCALE 1" = 20



GA

5