


D 60'-37" FF
 O 8'
 P 716.8
 T 418.0
 L 757.7
 E 113.5
 GUY WRIGHT

PARCEL	INSTRUMENT	DATE	GRANTOR	GRANTEE	RECORDED	REMARKS
ABCD	B.C.D.	8-9-37	WILLIAMS BROS.	ST. 17	24	866 8-11-37
A'	B.C.D.	8-10-37	GUY WRIGHT	"	"	"

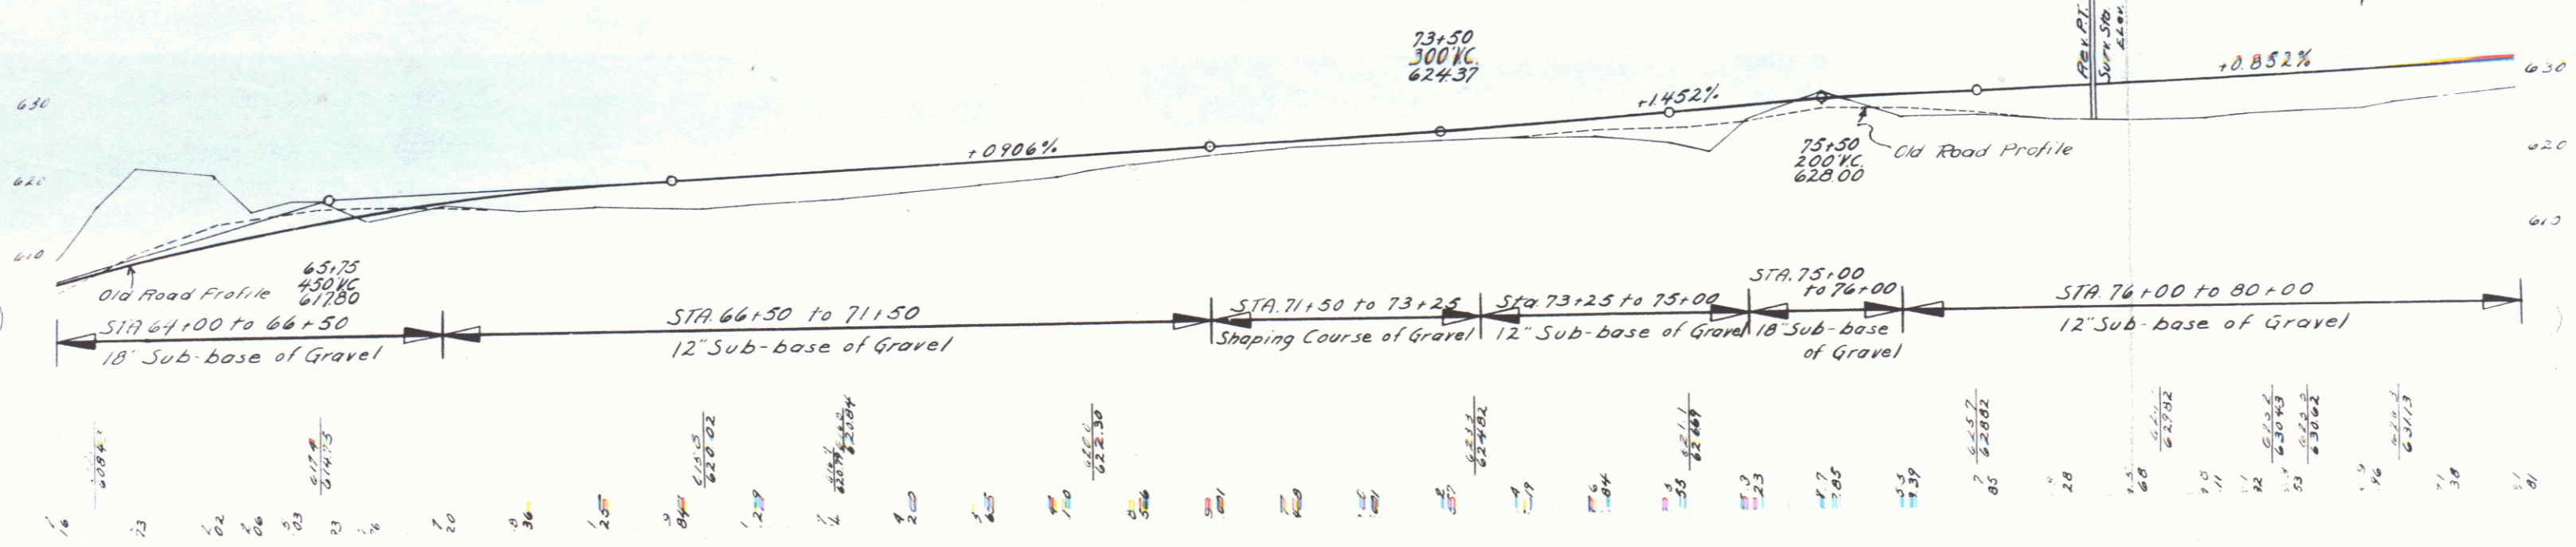

STA 64+00 to 66+50 18" Sub-base of Gravel
 STA 66+50 to 71+50 12" Sub-base of Gravel
 STA 71+50 to 73+25 Shaping Course of Gravel
 STA 73+25 to 75+00 12" Sub-base of Gravel
 STA 75+00 to 76+00 18" Sub-base of Gravel
 STA 76+00 to 80+00 12" Sub-base of Gravel

