


PARCEL INSTRUMENT	DATE	GRANTOR	GRANTEE	RECORDED AND INDEX BOOK PAGE DATE	REMARKS
A-B	P.C.D.	7-28-38	ETTA M HUNTOON	ST. OF VT. 17 59 8-18-38	

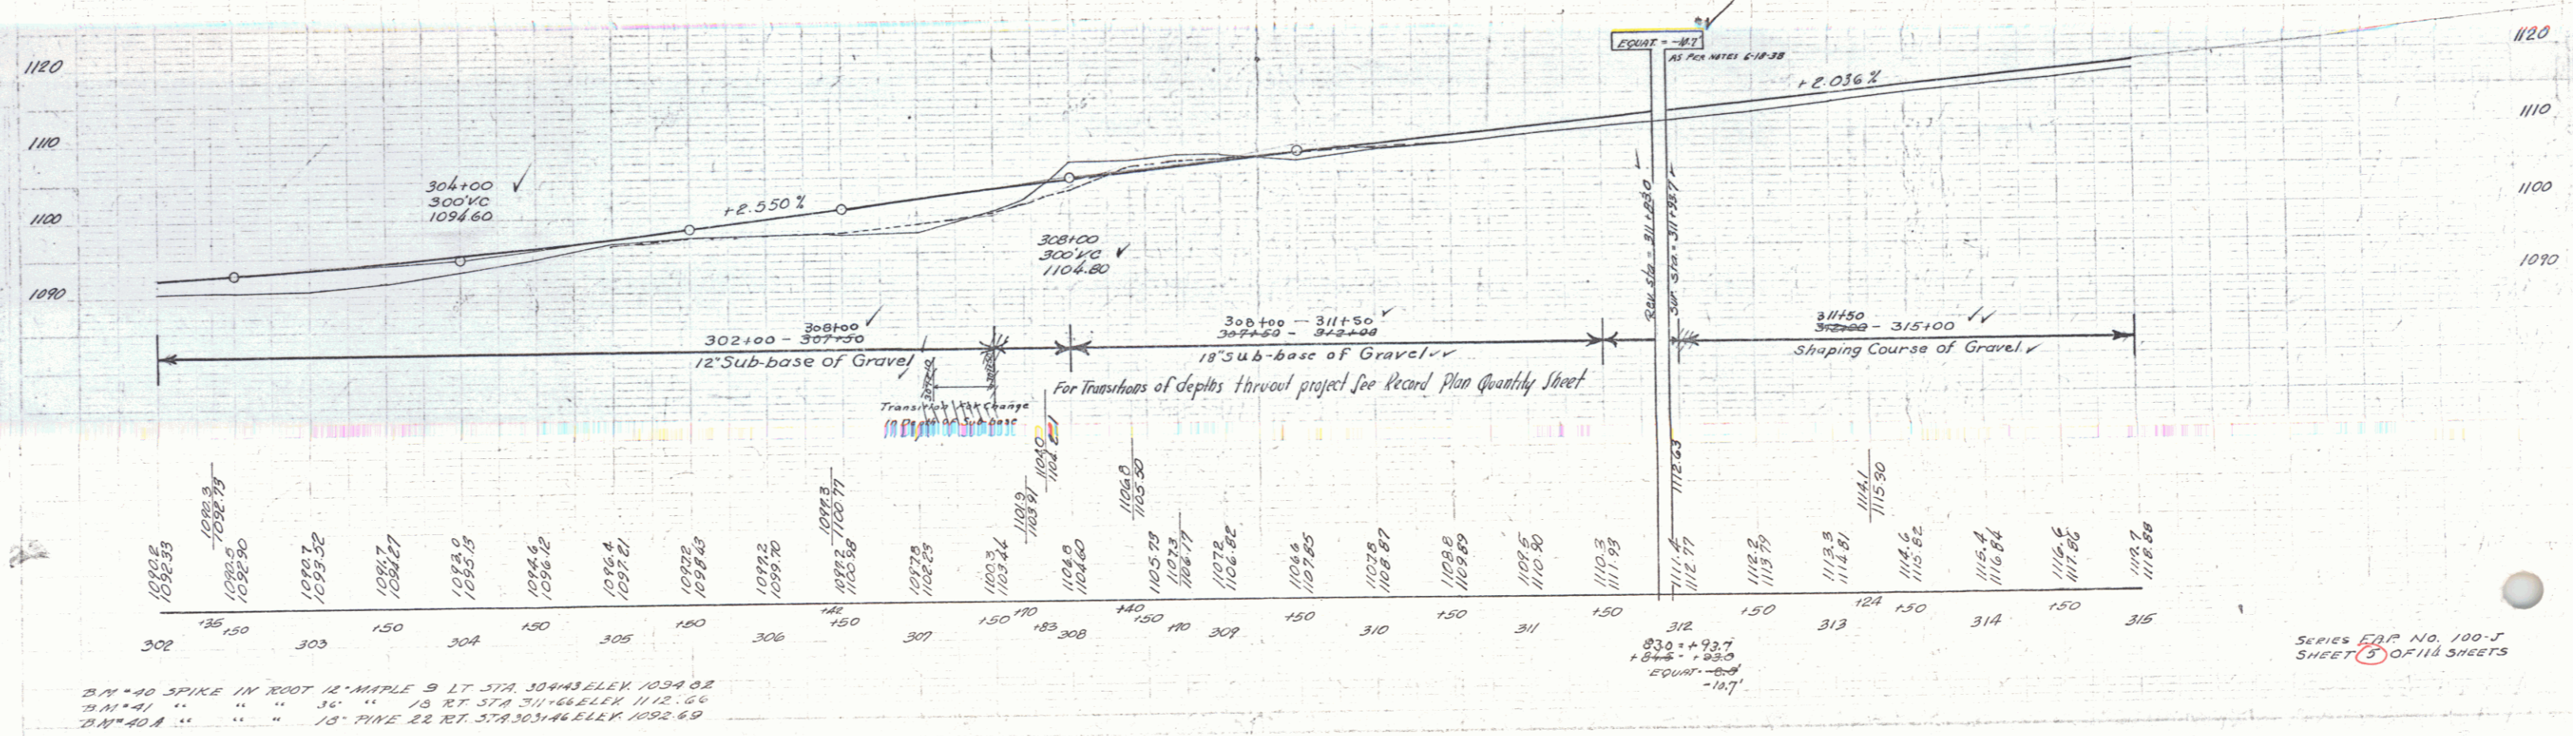

B.M. #40 SPIKE IN ROOT 12" MAPLE 9 LT 57A 30443 ELEV. 1094.92  
 B.M. #41 " " " 36 " 18 RT 57A 31166 ELEV. 1112.66  
 B.M. #40 A " " " 18" PINE 22 RT. 57A 30346 ELEV. 1092.69