


PARCEL	INSTRUMENT	DATE	GRANTOR	GRANTEE	RECORDED AND INDEXED	REMARKS
A	Q.C.D.	7-7-38	MES. A. I. ROWELL	ST. OF VT	BOOK PAGE DATE 17 59 7-21-38	
C-D	Q.C.D.	7-28-38	ETTA M. HUNTOON	"	17 59 8-18-38	CULV. AT STA. 319+50
A-B-C-U	PART. REL.	7-14-38	FED. LAND. BK.	ETTA M. HUNTOON	17 60 8-18-38	

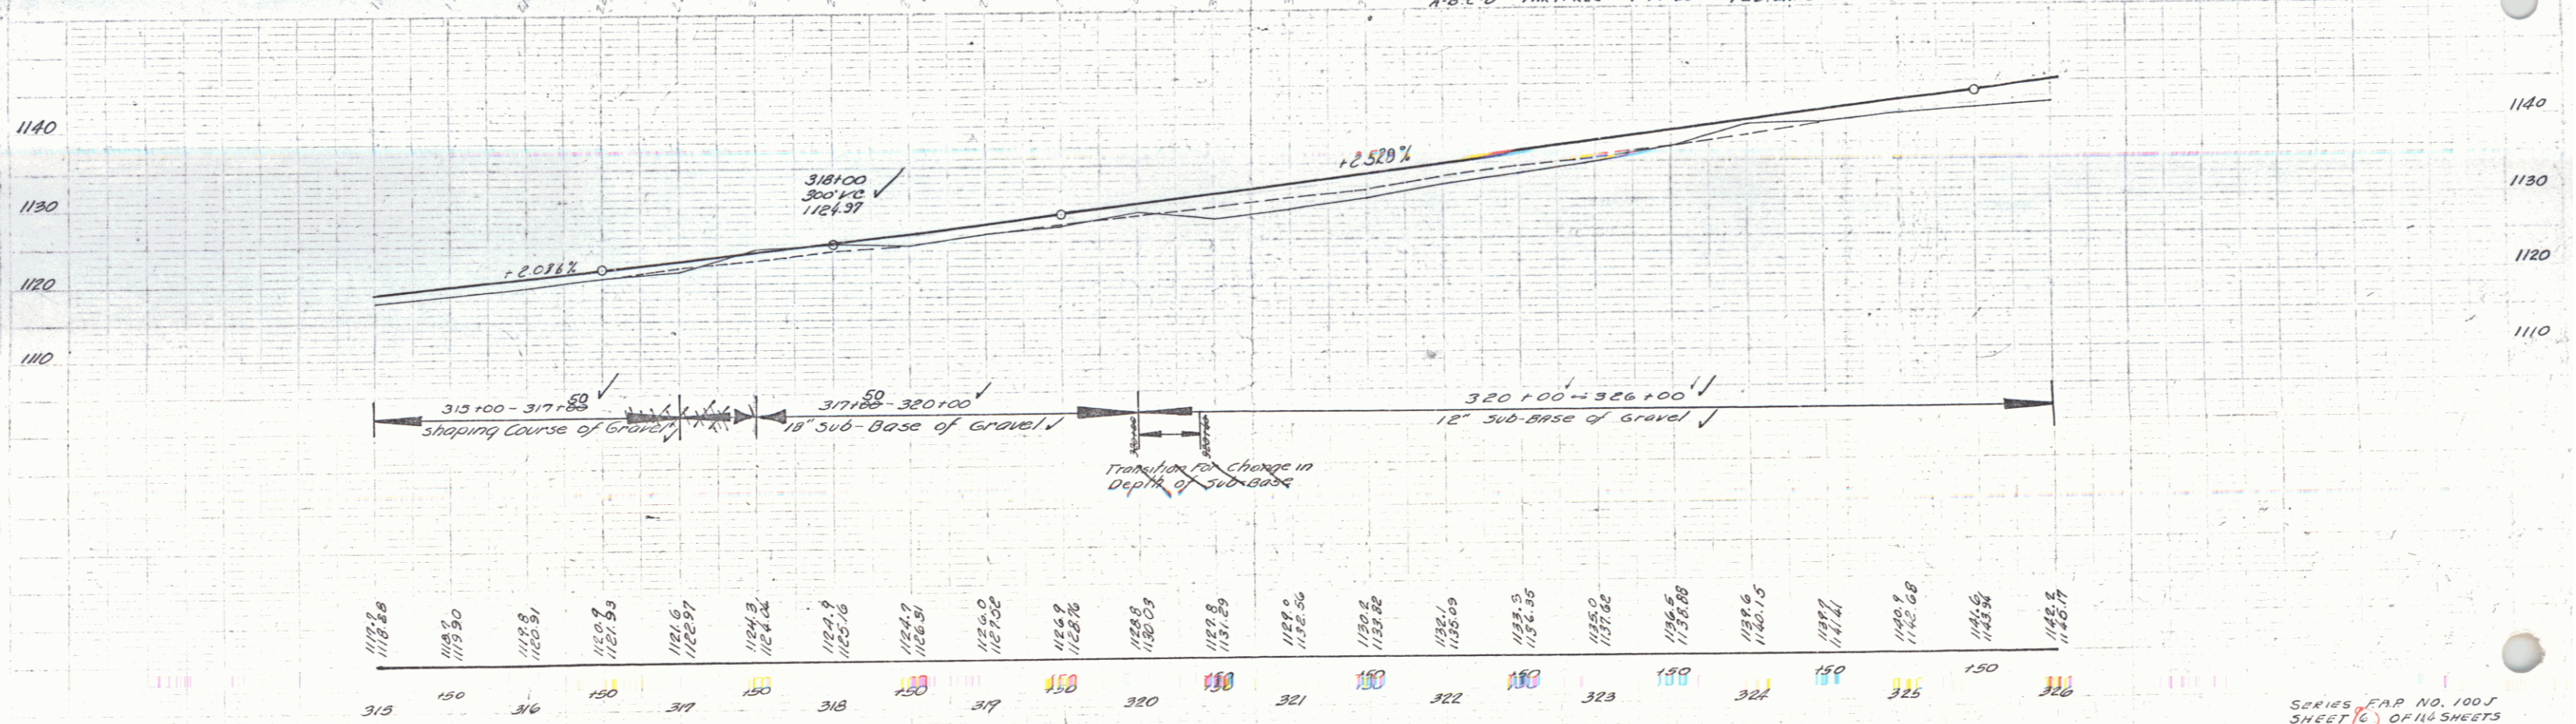

B.M. 42 SPIKE IN ROOT OF 10' MAPLE 14' LT 320+25 ELEV 1129.94