


PARCEL	INSTRUMENT	DATE	GRANTOR	GRANTEE	RECORDED	REMARKS
C	Q.C.D.	7-28-38	JOHN A & ROBERTA CHICK	ST. OF VT.	LONDONDERY BOOK 25 PAGE 33	DATE 8-1-38 CWN 34 513100

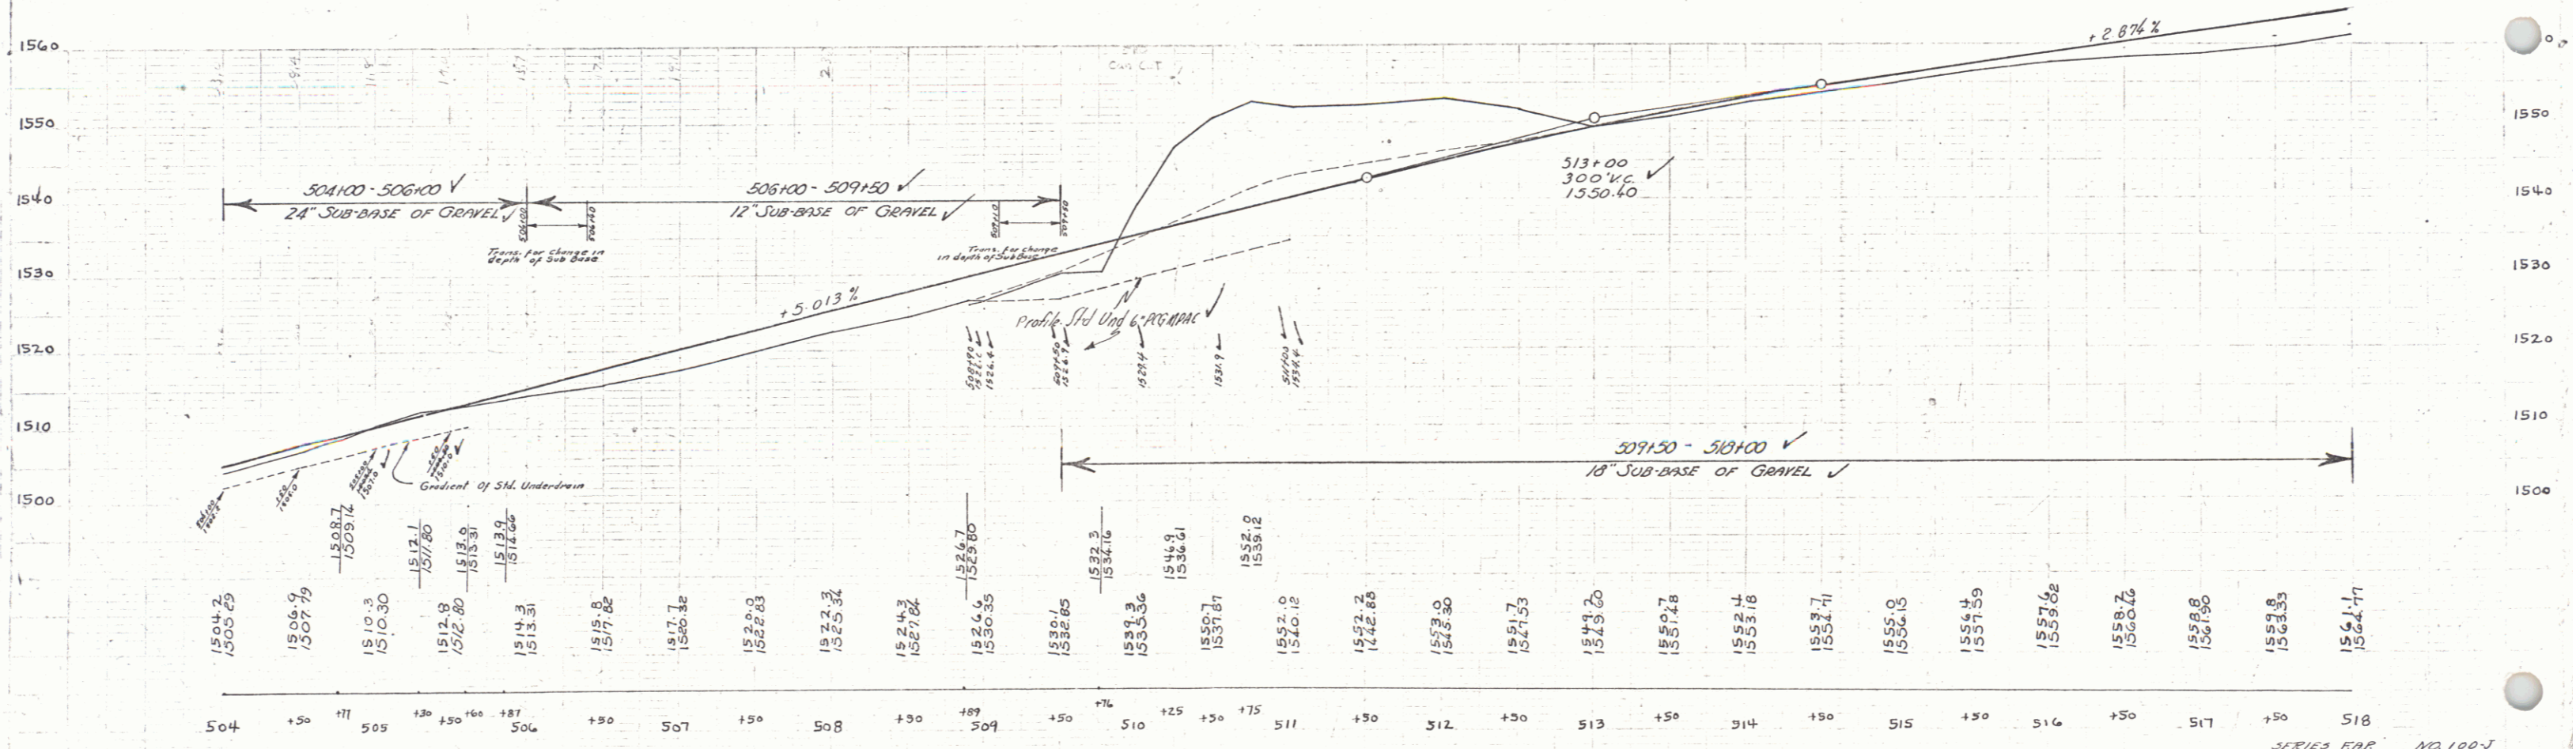

B.M. 64 SPIKE IN ROOT 15" MAPLE 140' RT 300.35 ELEV 1525.64  
 B.M. 65 " " TRUNK 14" MAPLE 49' RT 517.19 ELEV 1561.97

SERIES RAR NO 100-J  
 SHEET 13 OF 116