


PARCEL	INSTRUMENT	DATE	GRANTOR	GRANTEE	RECORDED	REMARKS
A-B	Q.C.D.	7-7-38	G.M. VANDERWARKER	ST. OF VT	25	32 7-12-38 STA 690+10
A'	Q.C.D.	7-7-38	W.M. MINERVA LAVALLEY	ST. OF VT	25	28 7-12-38
D	Q.C.D.	7-7-38	W.E. & ELLEN FONTAINE	"	20	26 7-12-38

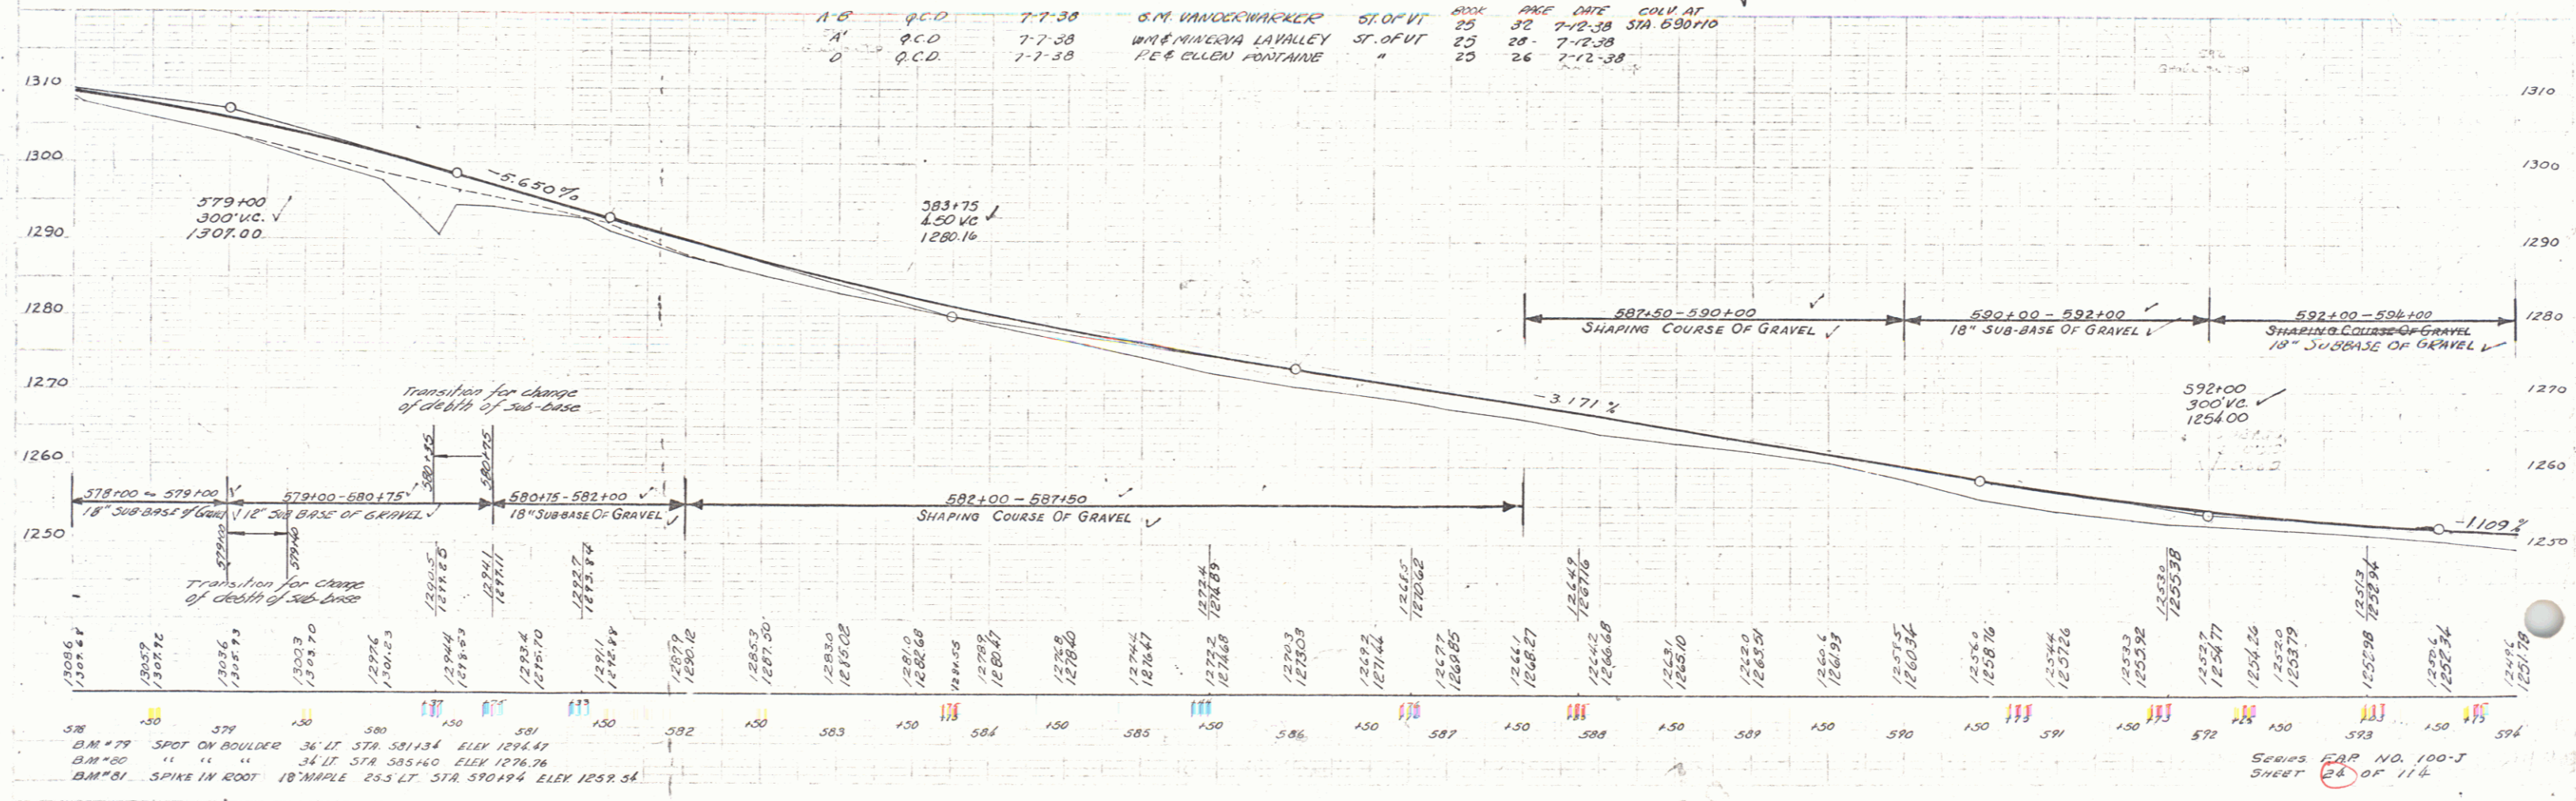

578+00 - 579+00 18" SUB-BASE OF GRAVEL  
 579+00 - 580+175 18" SUB-BASE OF GRAVEL  
 580+175 - 582+00 18" SUB-BASE OF GRAVEL  
 582+00 - 587+50 SHAPING COURSE OF GRAVEL  
 587+50 - 590+00 SHAPING COURSE OF GRAVEL  
 590+00 - 592+00 18" SUB-BASE OF GRAVEL  
 592+00 - 594+00 SHAPING COURSE OF GRAVEL

SERIES MAP NO. 100-J  
 SHEET 24 OF 114