


PARCEL	INSTRUMENT	DATE	GRANTOR	GRANTEE	RECORDED	REMARKS
C	Q.C.D.	7-7-38	G.M. VANDERWERKER	ST. OF VT.	BOOK 25 PAGE 32 DATE 7-12-38 STA. 693+00	

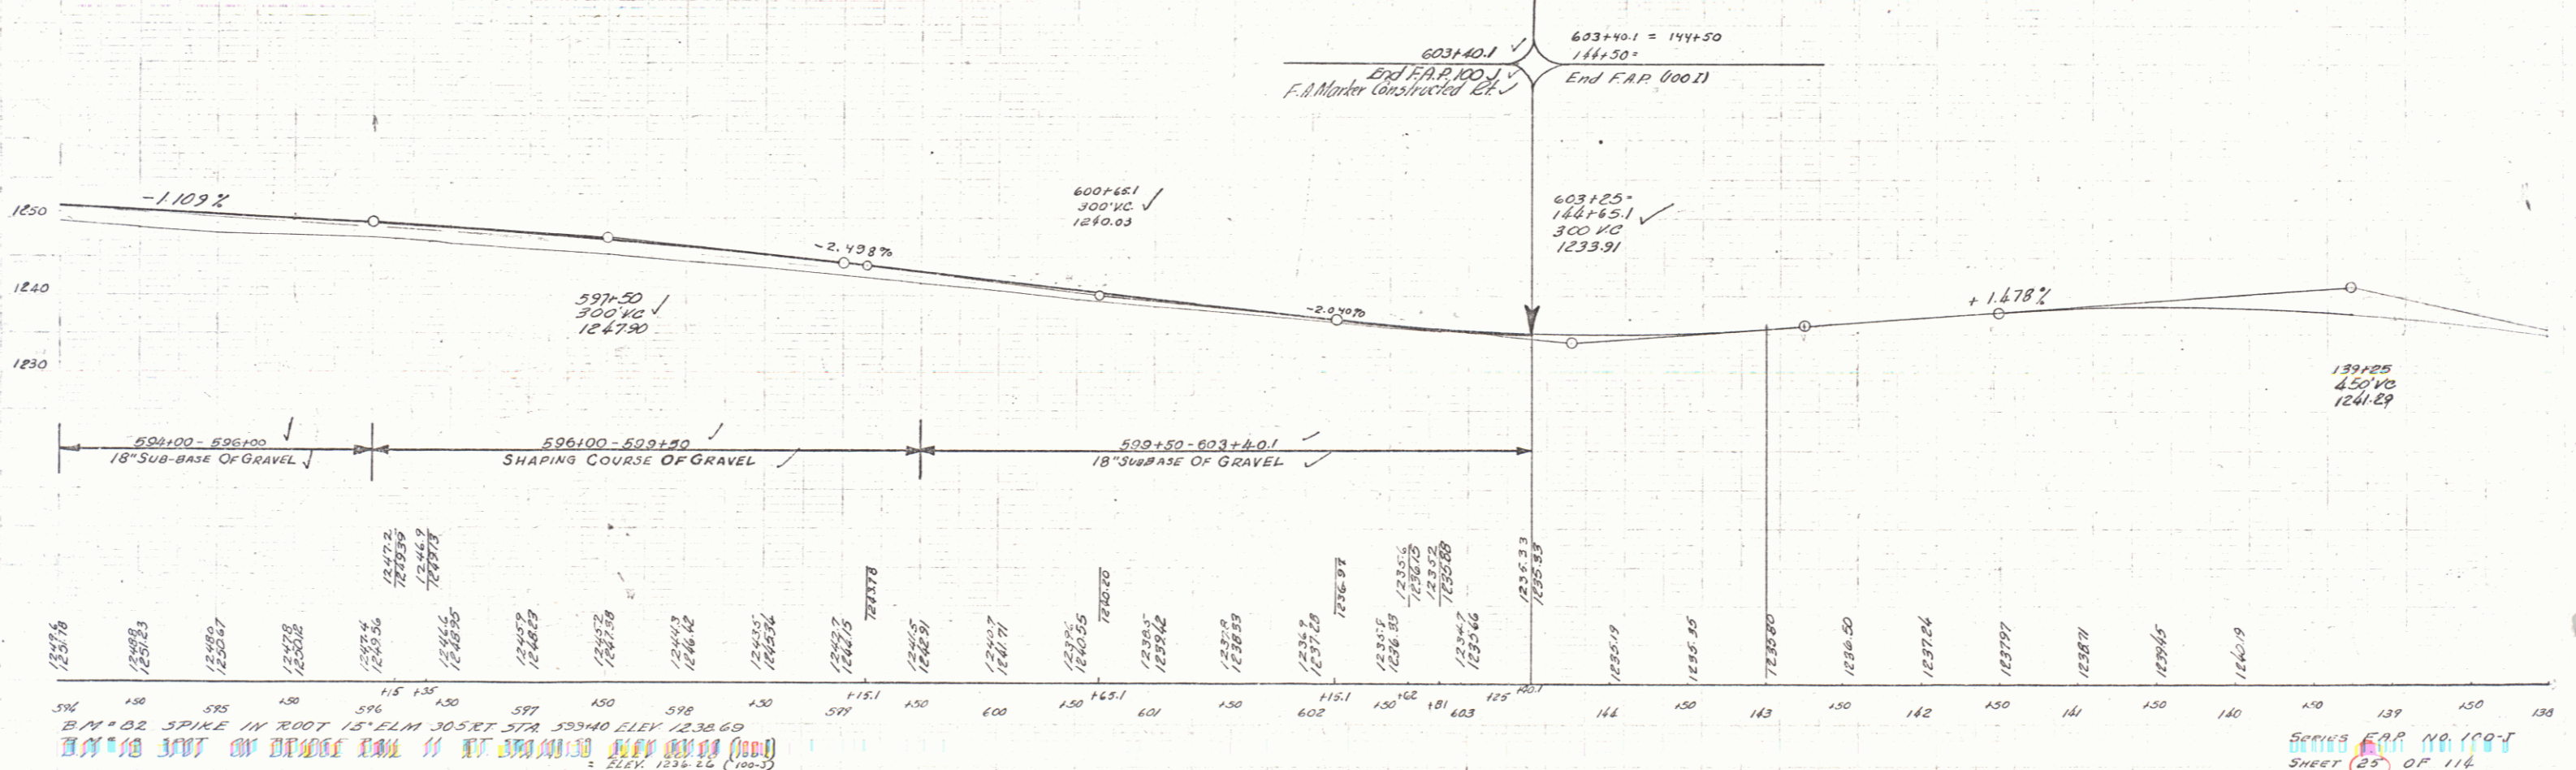

5% B.M. #02 SPIKE IN ROOT 15' ELM 305 RT STA 593+40 ELEV 1238.60

Series F.A.P. NO. 100-J
SHEET 25 OF 116