


Channel Surveyed on 10/10/50

Channel Width Profile

1. CROSS SECTION CHANNEL LINE EVERY 25' SECTION @ LEAST 50' AT 1 FT.
2. RUN IN EXISTING & BOUNDARY 500' EACH SIDE OF STA 21+23.3 REIN PROFILE INTO SECTION 50' EACH SIDE OF E. TAKE SECTIONS @ 50' INTERVALS.
3. PICK UP TOPO

POOR ORIGINAL COPY

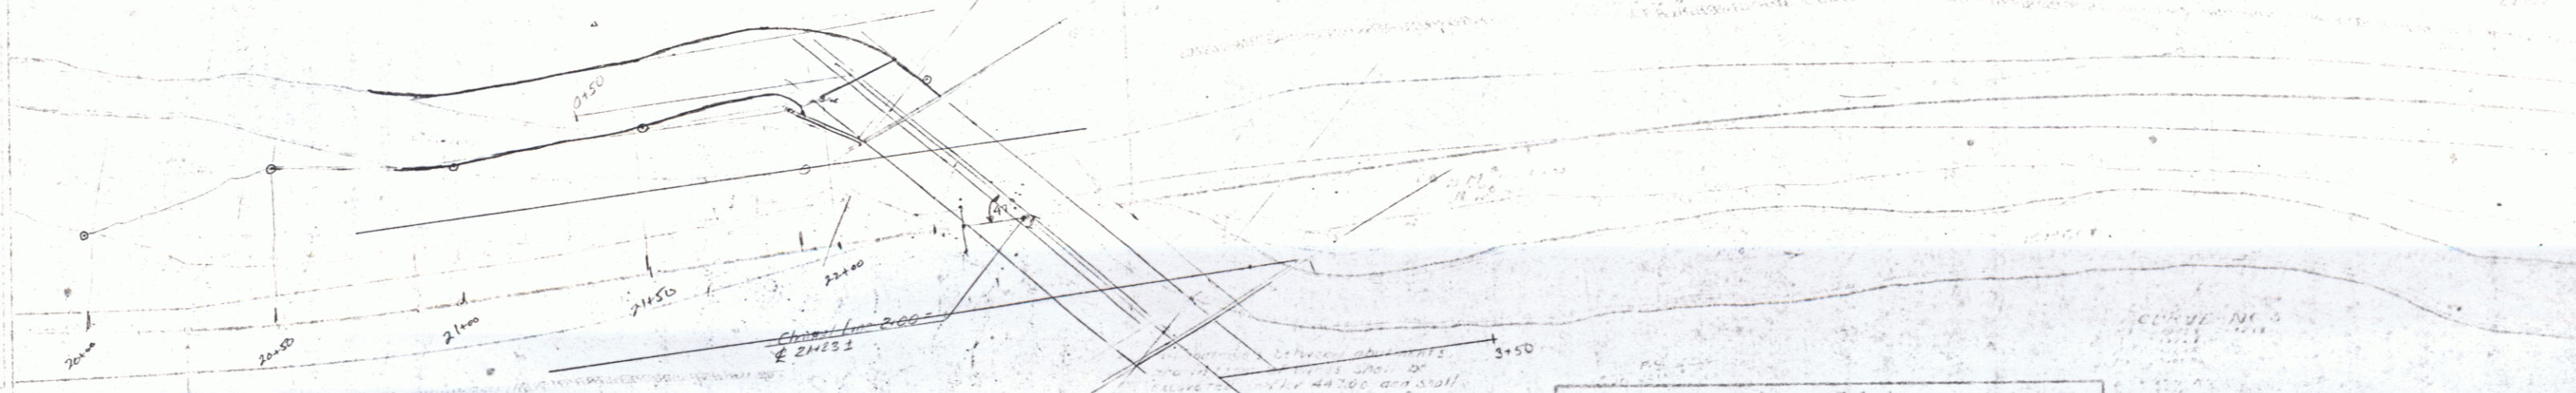

SECTION 5-0

SUMMARY OF QUANTITIES

10.00	Excavation	1,200	cu yd
15.00	Structure excavation	1,000	cu yd
20.00	Gravel surface course	1,100	cu yd
30.00	Concrete class (1:2:4)	1,200	cu yd
35.00	Concrete class (1:2:4) - 2' thick	1,200	cu yd
40.00	Reinforcing steel	26,000	lb
60.00	Top iron for bank protection	850	lb
65.00	Cable guard rail	850	lb
66.00	Manhole	1	unit

- SECTION 5-0 SHEET 10 OF 10 USED
- 1. Channel Profile
 - 2. Cross Section
 - 3. Right Bank
 - 4. Section of Topography
 - 5. Sheet Construction Details
 - 6. Sheet Construction Details
 - 7. Sheet Construction Details
 - 8. Sheet Construction Details
 - 9. Sheet Construction Details