

CURVE NO. 9	
ORIGINAL	REVISED
81.03 R	81.39
41.00 D	31.00
75.7 T	66.7
151.3 L	173.6
2.0 E	3.3
1432.5 R	1146.0



SECTION B-6
NEW CULVERTS REQUIRED
Sta. 53194 to 53196 (2) 15' Length 30' FT
Concrete Class III (1.2.4) 2.5 Cu Yds.
Reinforcing Steel 12.3 Lbs.
See Street Series S No. 20

SECTION B-6
CABLE GUARD RAIL REQUIRED
LEFT
Sta. 53182 to 54106 Length 24 Lin. Ft.
RIGHT
Sta. 53182 to 54106 " 24 - -"
TOTAL 48 LIN. FT.

SECTION R-3
SUMMARY OF QUANTITIES
Item 10-11 Common Excavation 100 Bottom 87 Cu Yds.
20A Gravel Surface Course 186 - -

SECTION R-3
SHEETS TO BE USED
1 SHEET PLAN AND PROFILE
1 " CROSS SECTIONS
EARTHWORK SHEET
TYPICAL SECTION OF IMPROVEMENT 24' GRAVEL

100C 1924 26 90

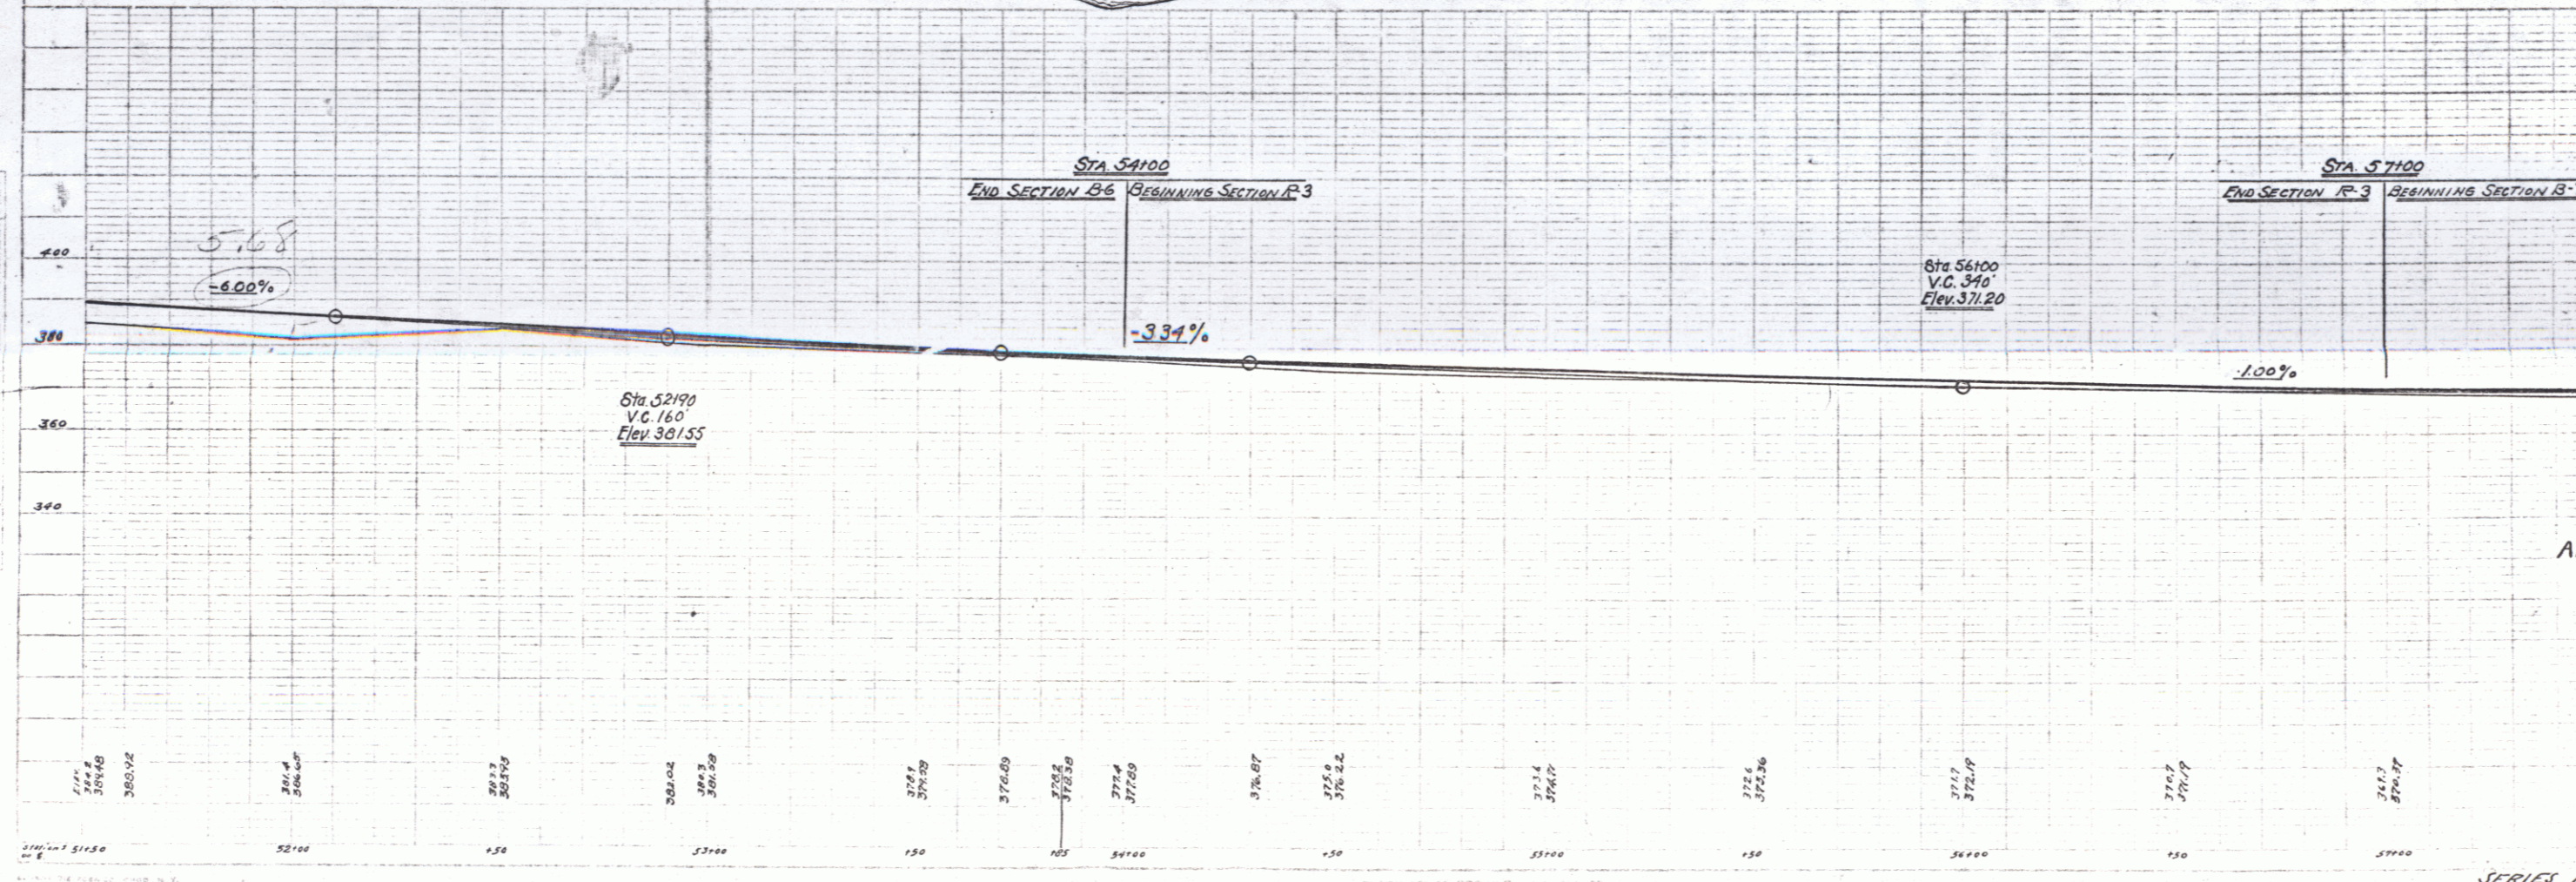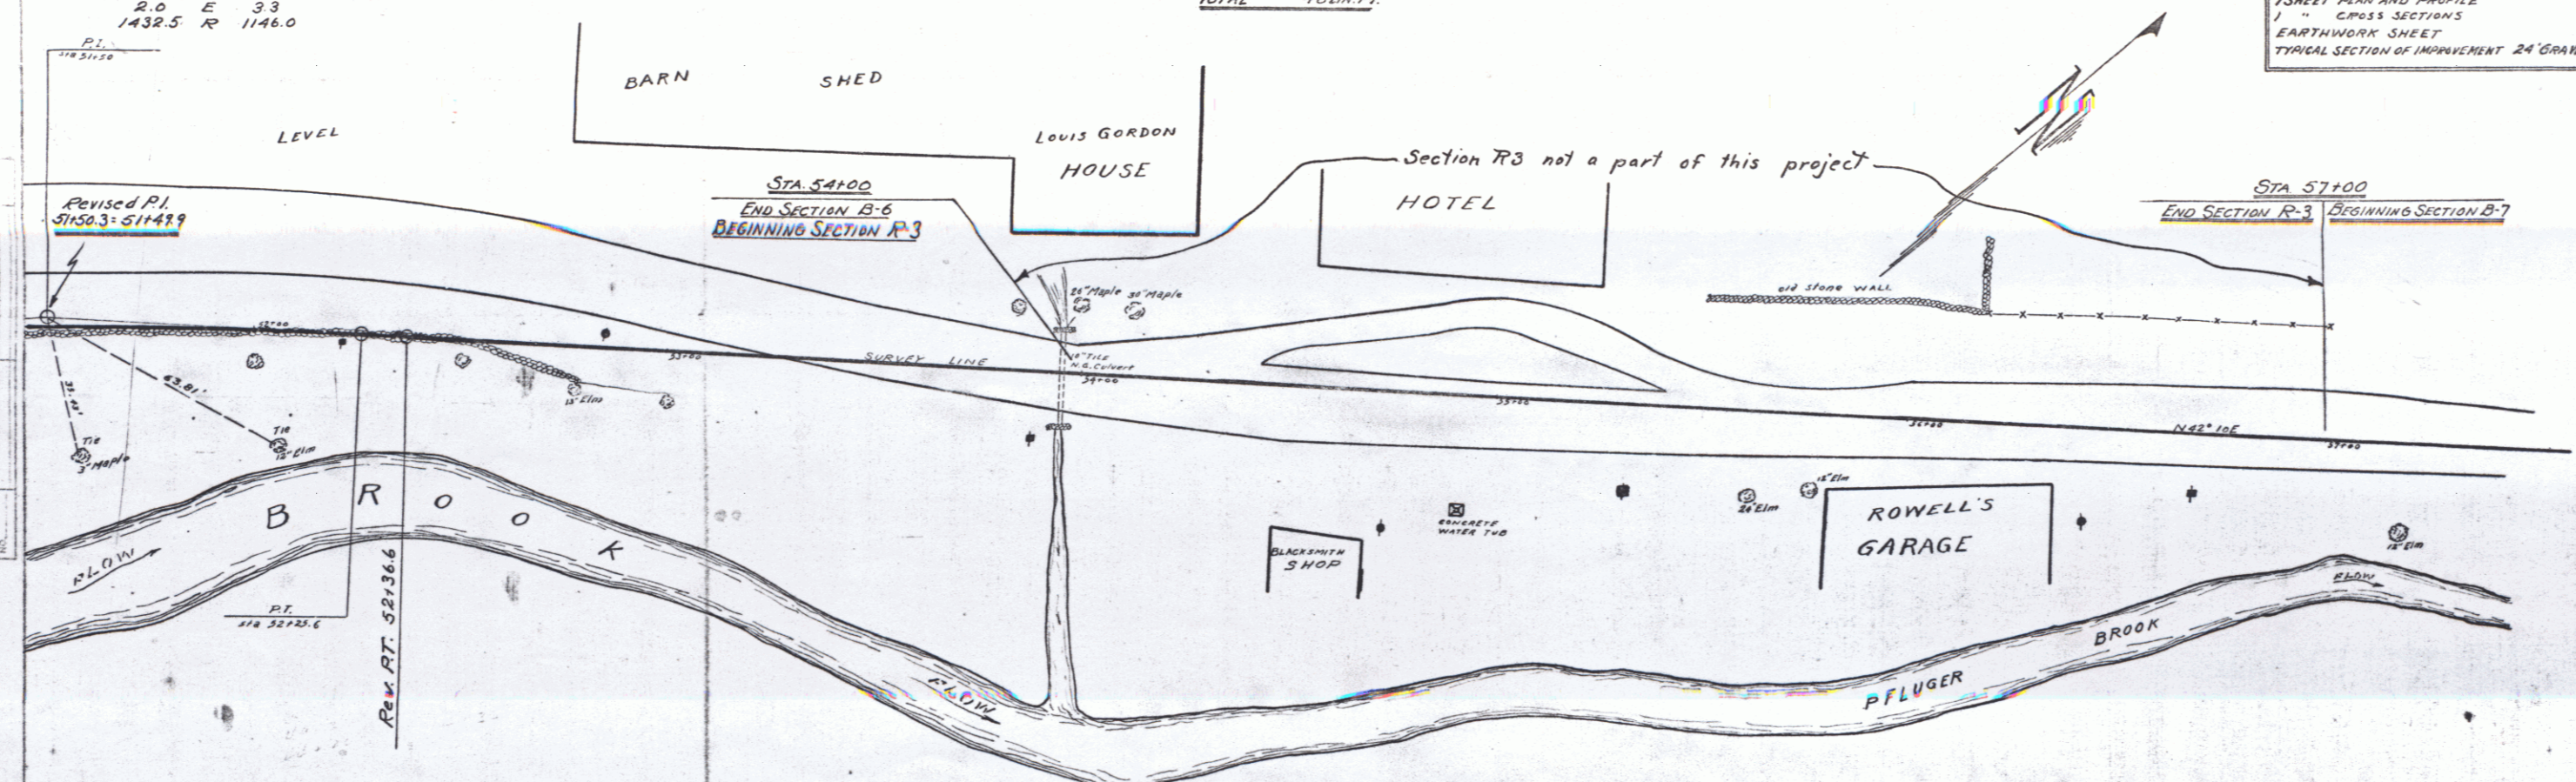

ANDOVER, VT.
PFLUGER BROOK
DISTRICT NO. 4
Scale 1" = 20ft.

SERIES F - No 100 C
SHEET No. 26 of 98 SHEETS

16