
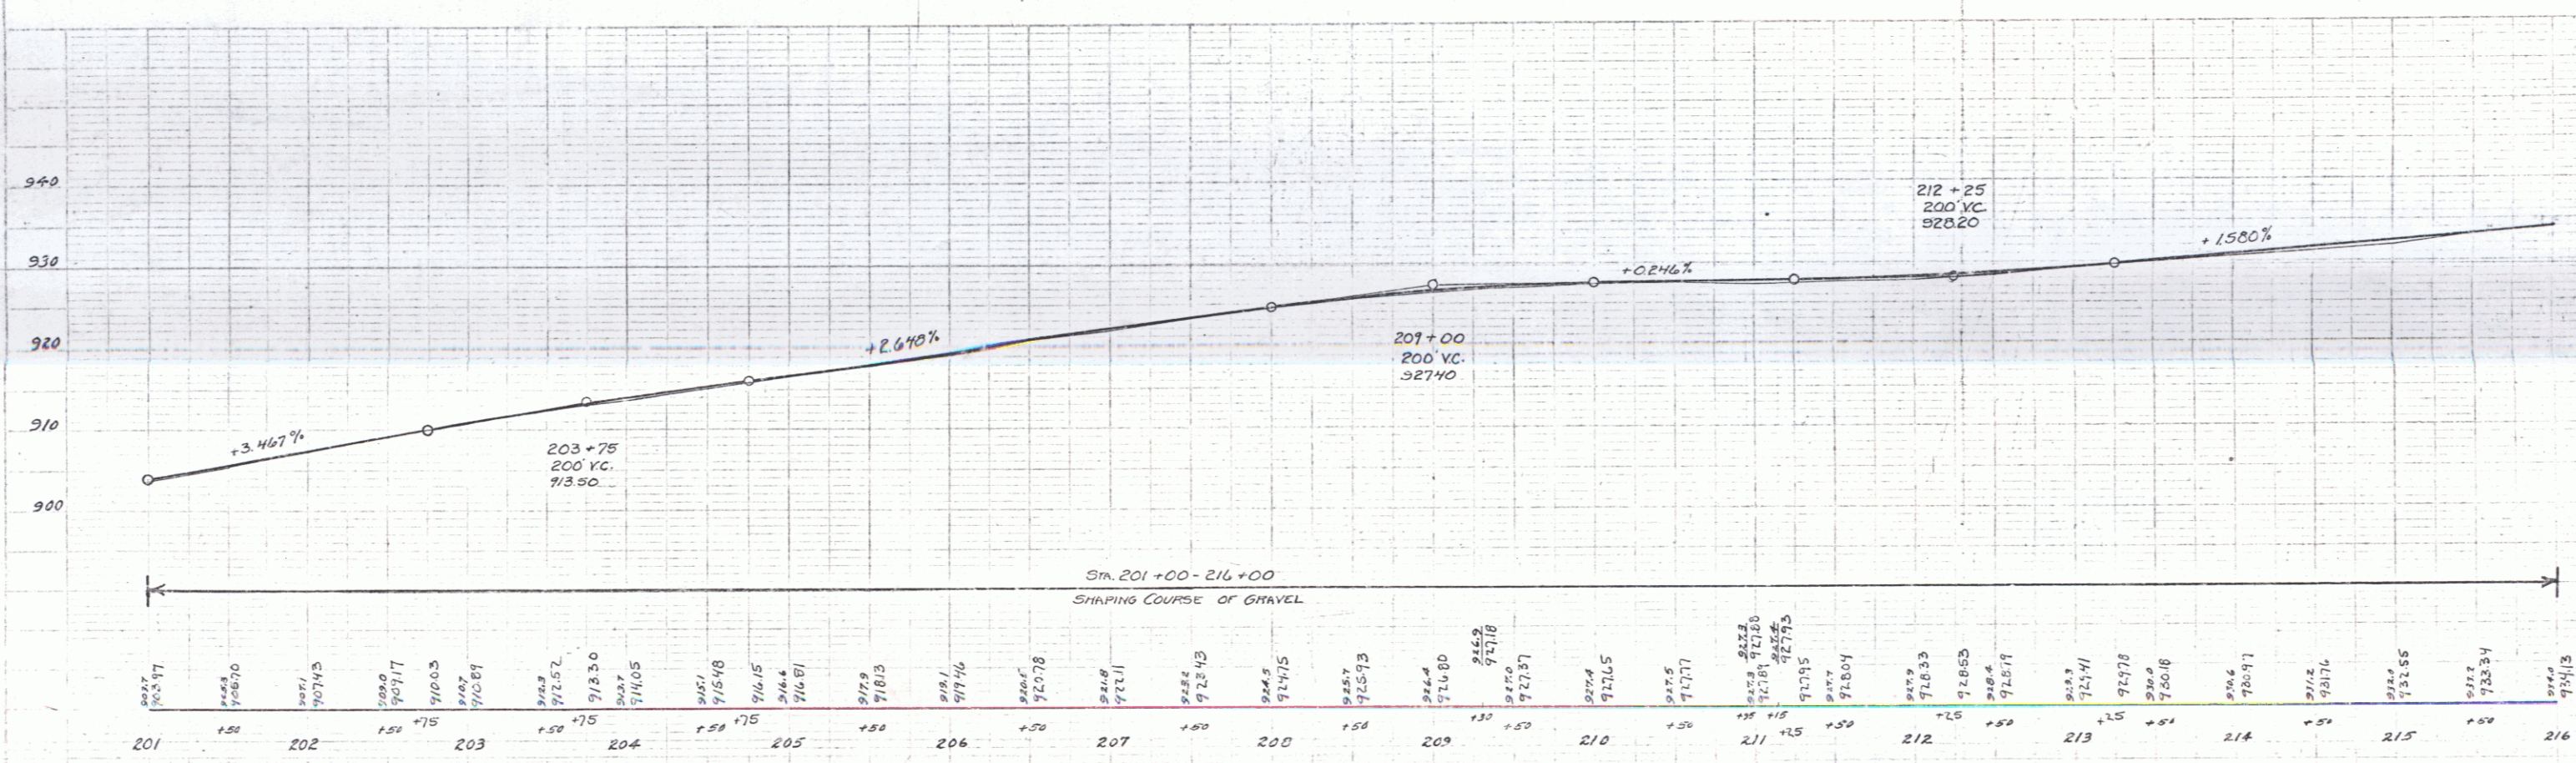


Point	Kind of Instrument	Date of Instrument	Greater	Greater	Recorded	Remarks
A	G.C.D.	12-29-34	Oscar Bemis	Stap H.	32 317	1-5-35 See 100P
A	G.C.D.	1-31-36			32 355	8-6-36

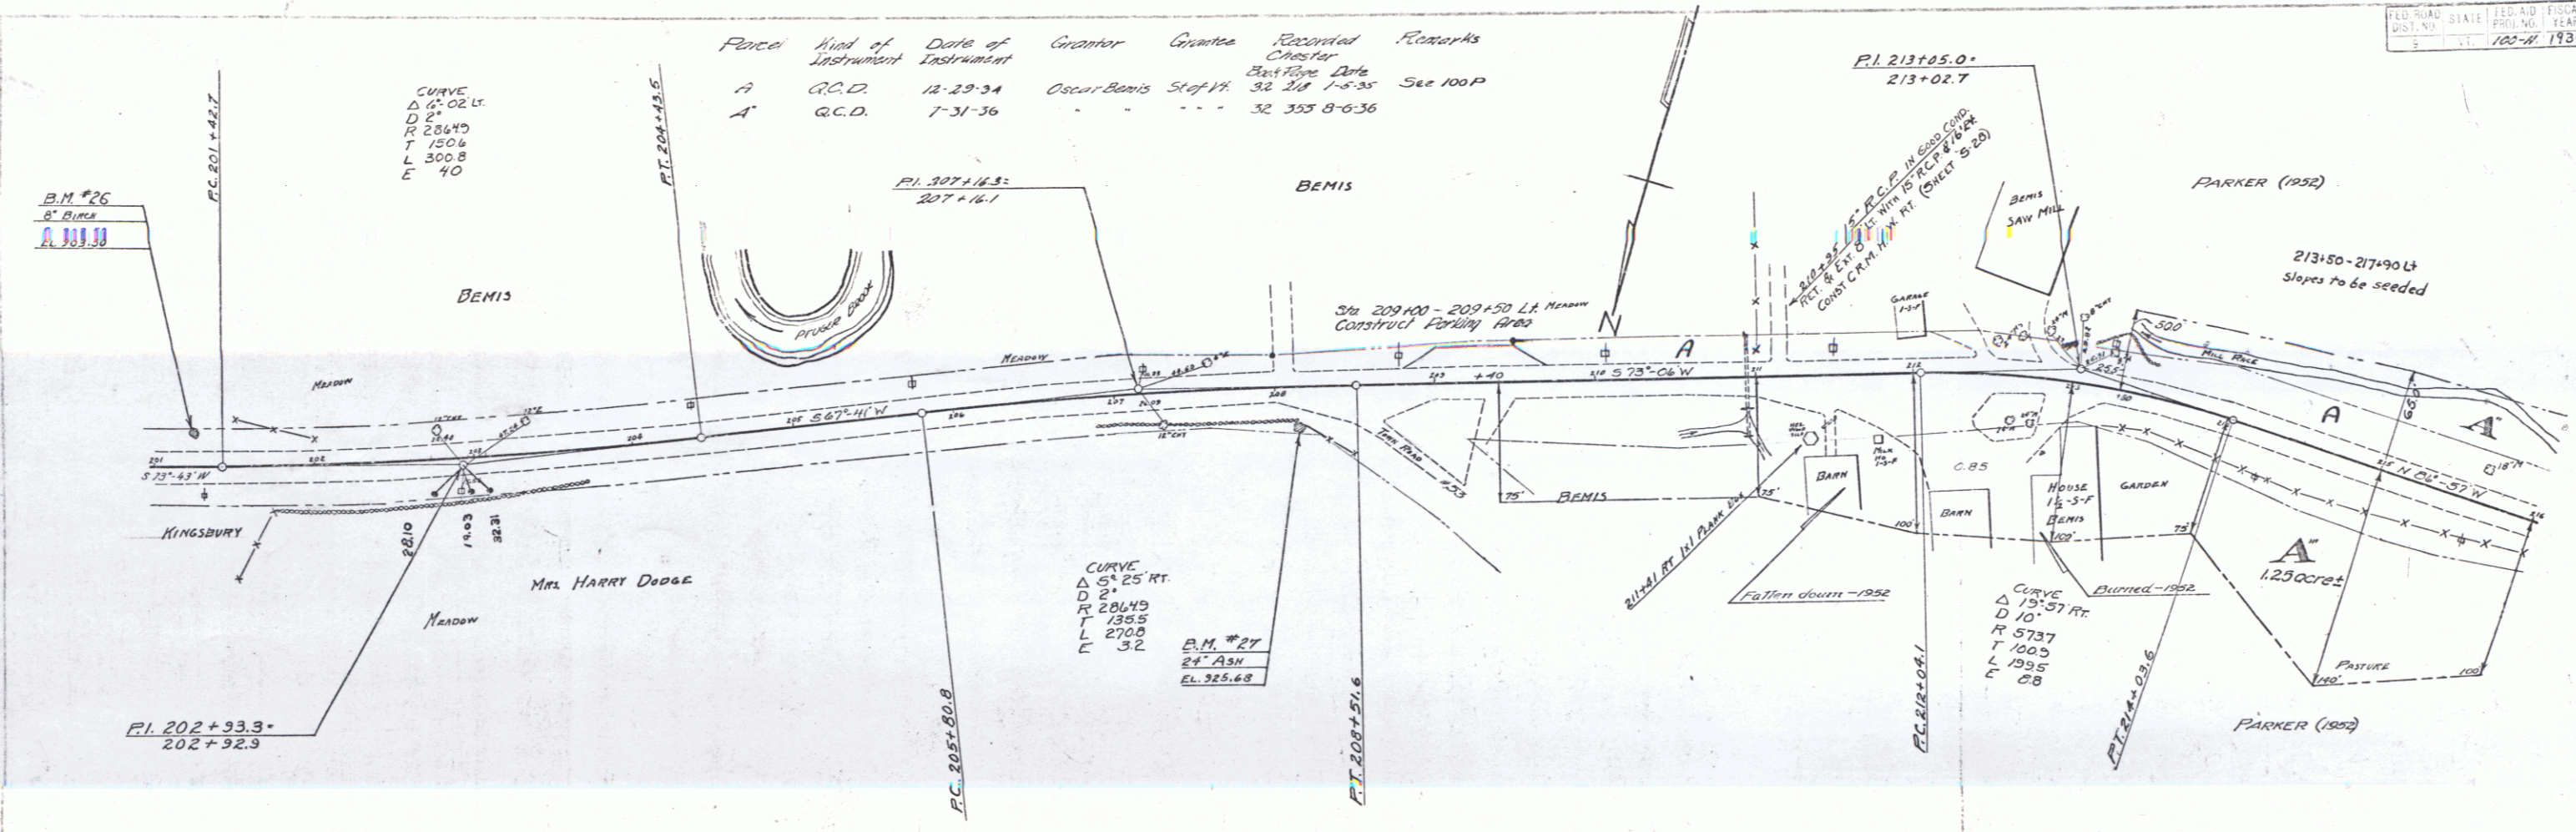

B.M. #26  
 B.M. #27