
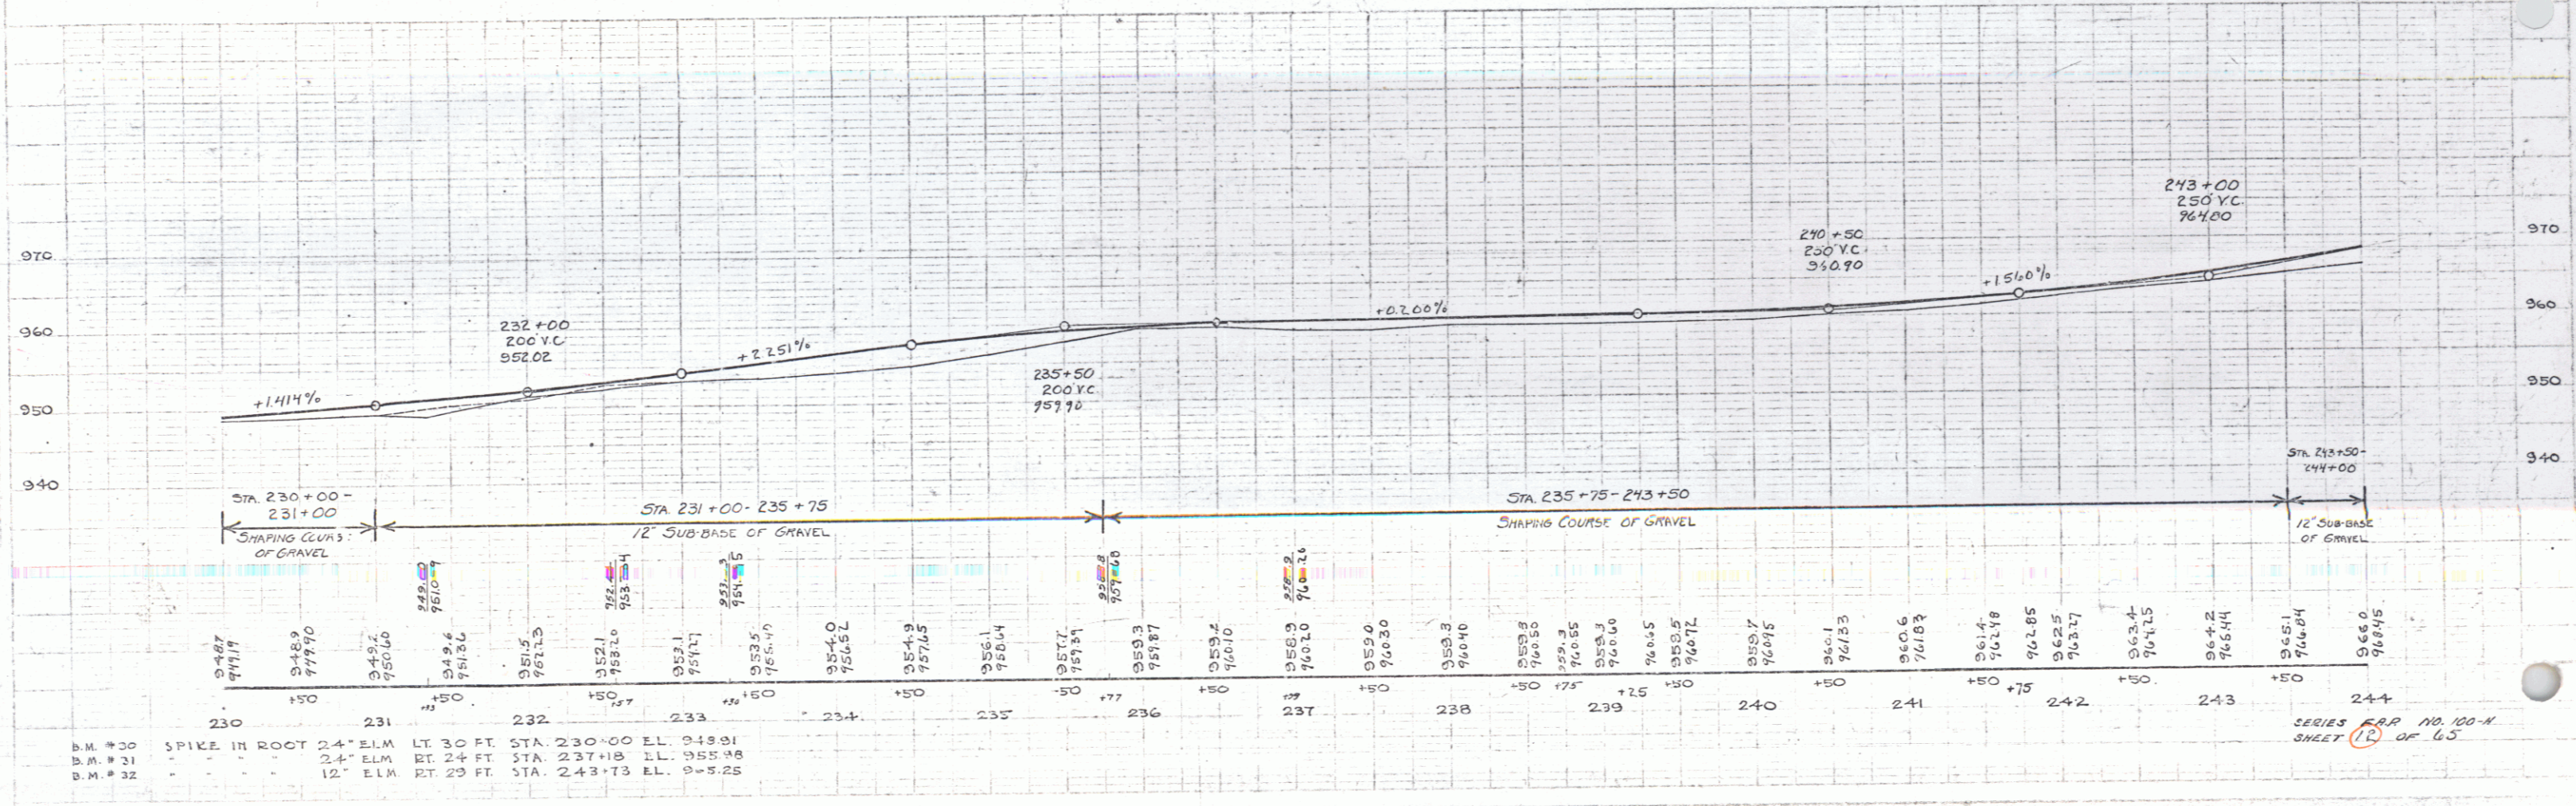


Parcel	Kind of Instrument	Date of Instrument	Grantor	Grantee	Recorded	Remarks
D	G.C.D.	12-29-34	Oscar Bemis	Sh. of H.	52 218	1-3-35

FED. ROAD DIST. NO.	STATE	FED. AID FISCAL YEAR	SHEET NO.	TOTAL SHEETS
5	VT	1954-1955	12	65

CURVE

Δ	5° 22' Lt.
D	25
R	204.9
T	13.43
L	26.83
E	31

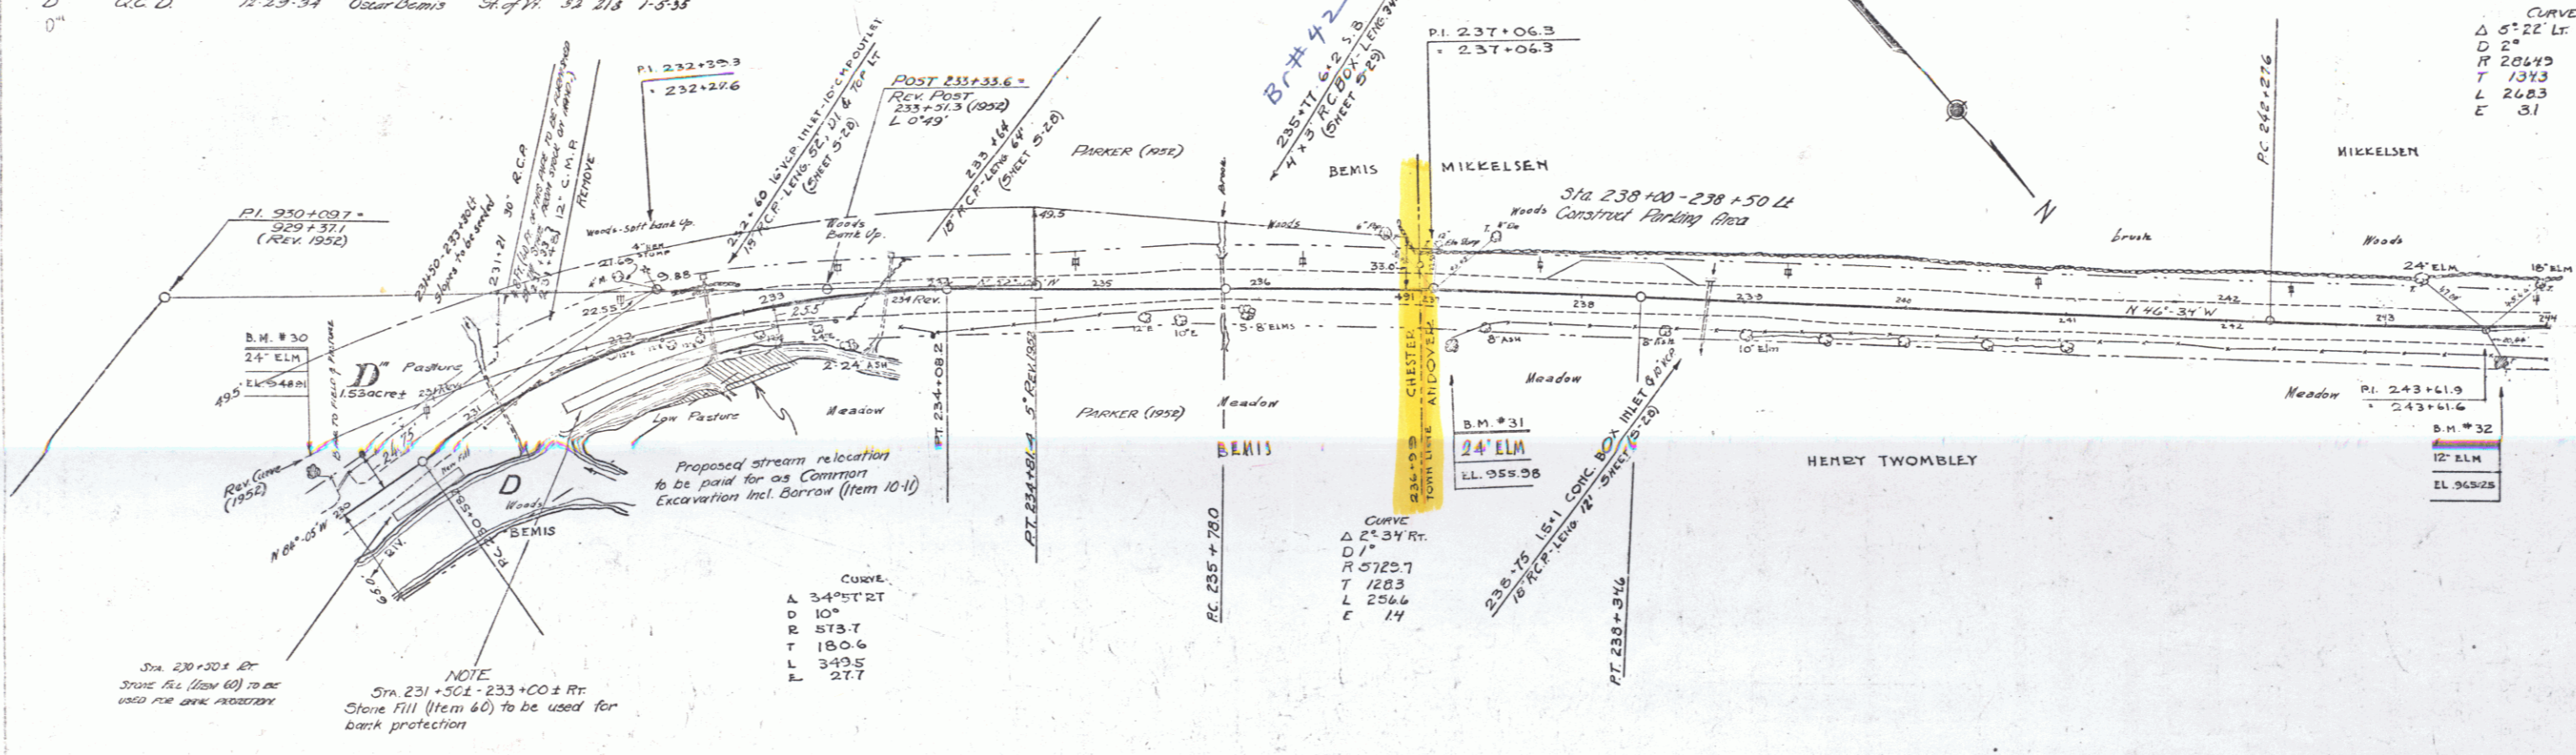

PUTNAM
D. MACCHI
TEACED
14/34

PUTNAM
D. MACCHI
14/34

SERIES R.P.R. NO. 100-N
SHEET 12 OF 65