
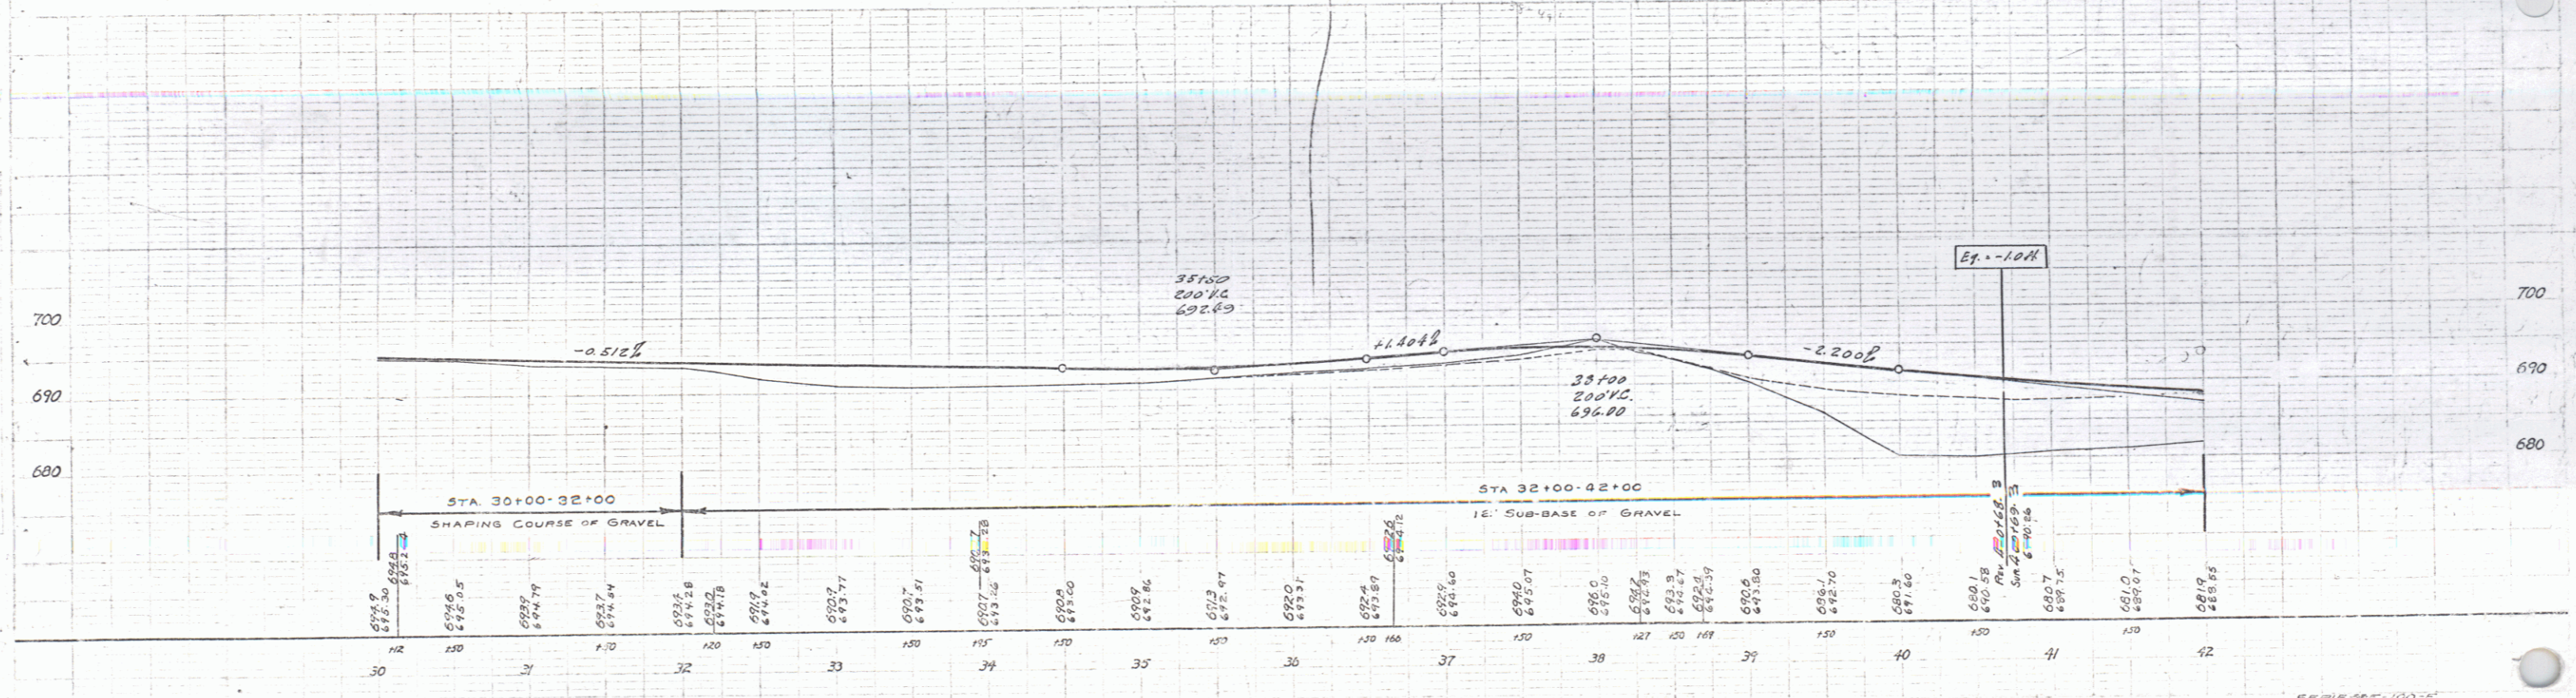


Parcel	Form of Instrument	Date of Instrument	Grantor	Grantee	Recorded Chapter	Recorded Date	Remarks
B	G.C.D.	1-11-33	Rowland L. Noyes	Staff H. 32	81	1-14-33	
A	"	1-24-33	George Foster	"	32	31-32	2-1-33
A'	"	1-26-33	Chas. Kimball	"	32	30	2-4-33

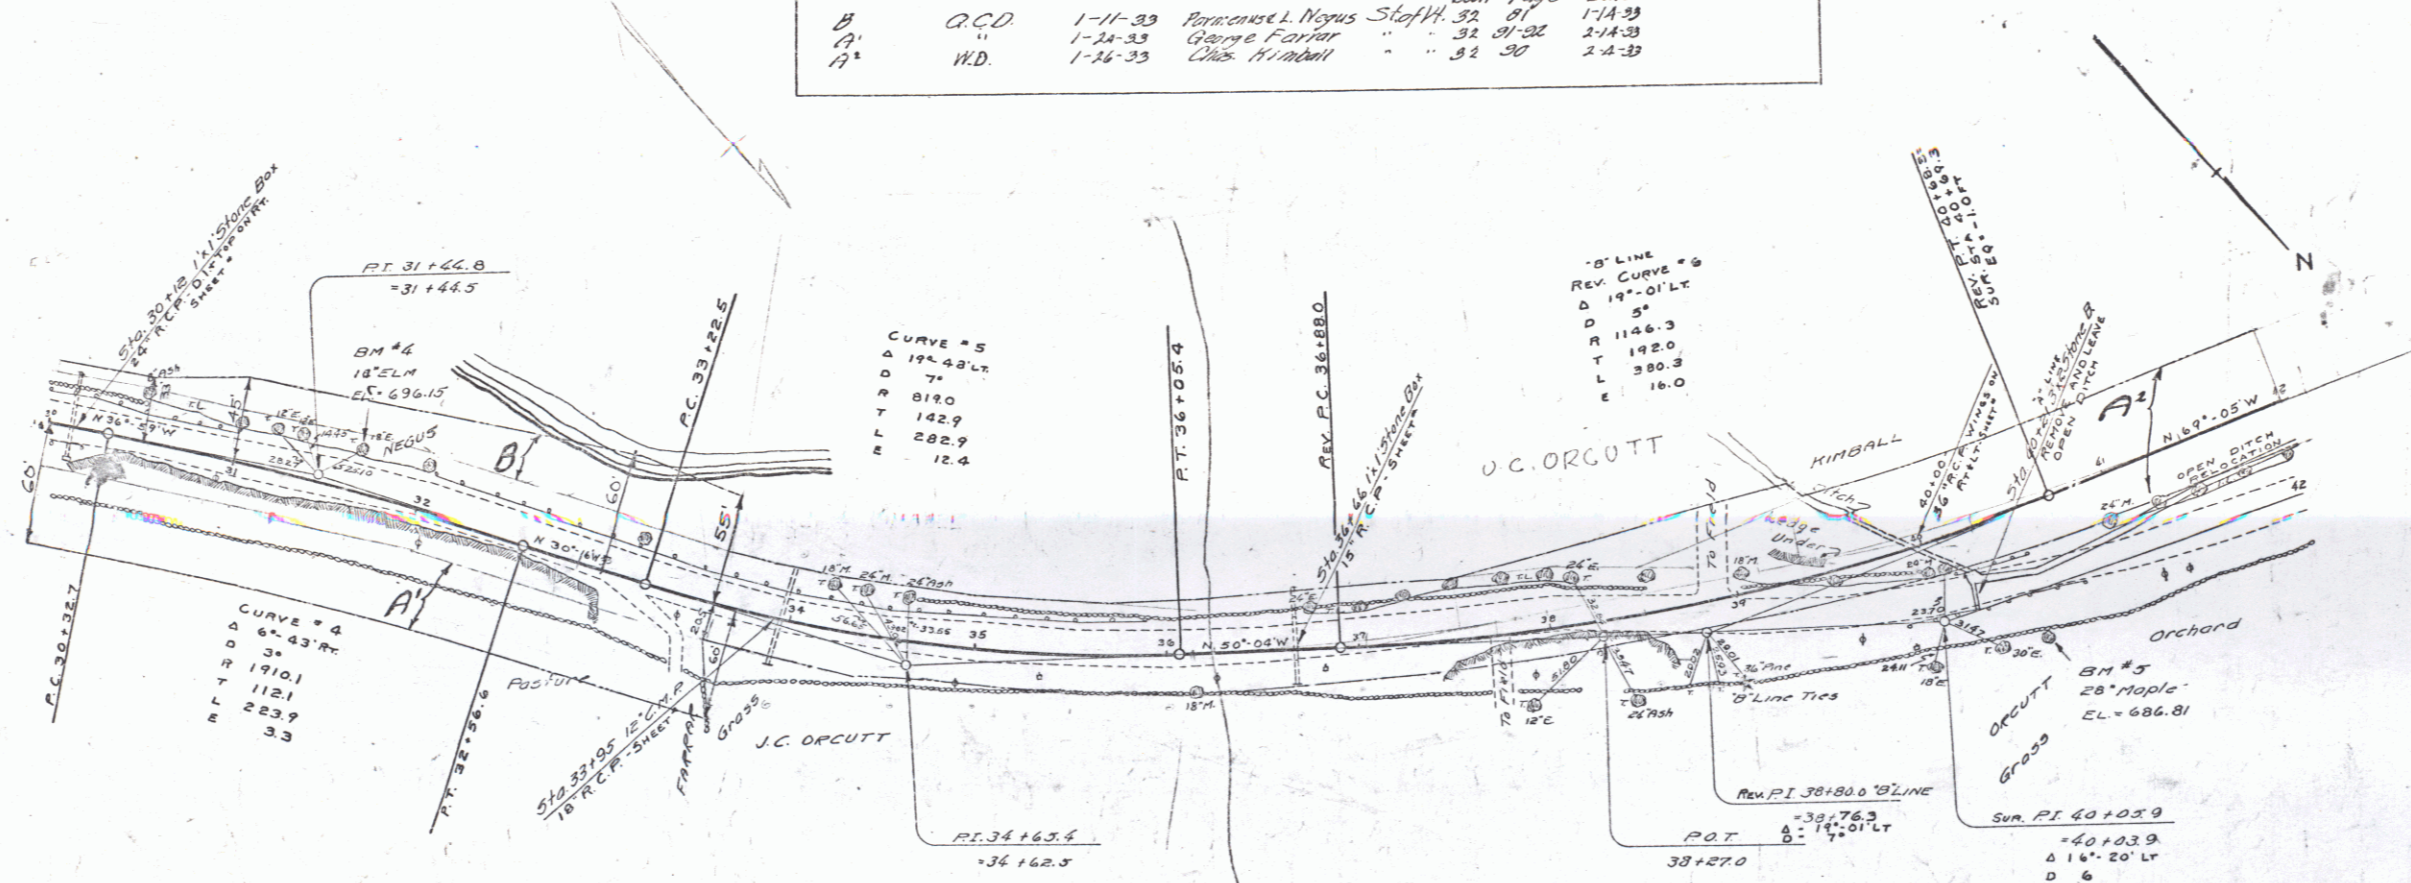

B.M. #4 SPIKE IN IRON 1 1/2 IN. ELM. STA. 31+66 ELEV. 696.15
 B.M. #5 SPIKE IN ROOT 2 1/2 IN. MAPLE STA. 40+94 ELEV. 686.81

SERIES 515-100-74
 SHEET No. 07