
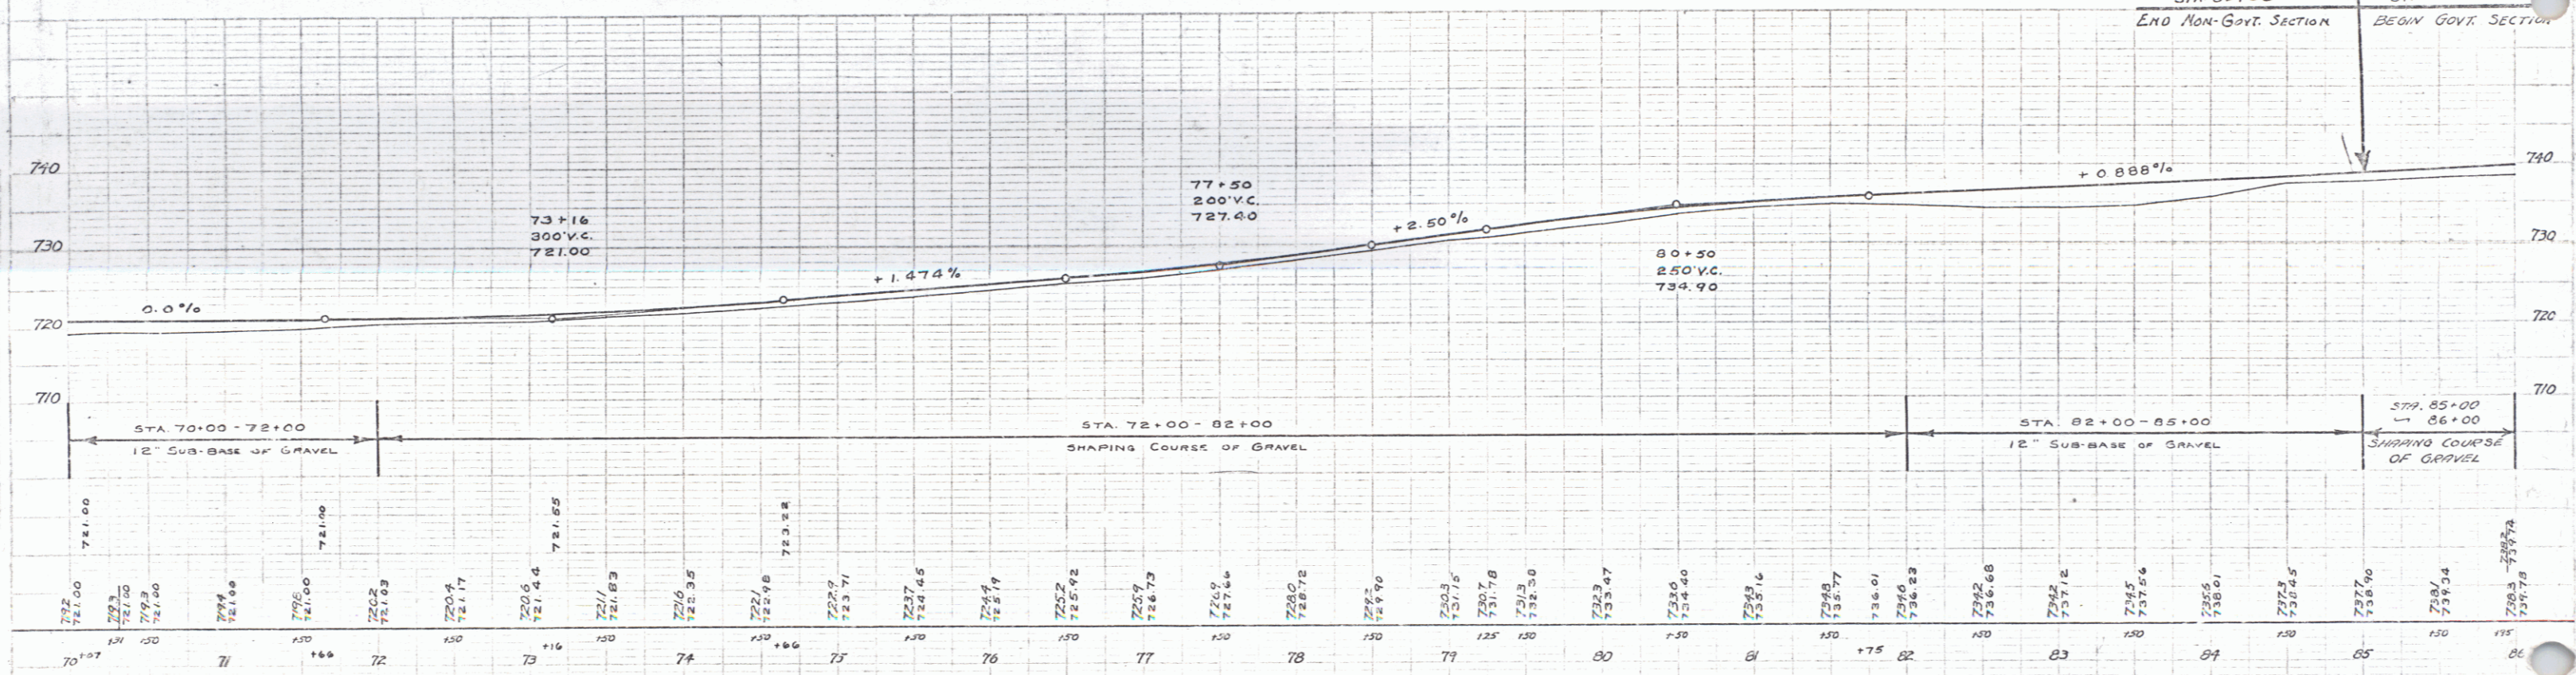


REINF.	CONG.	PIPE	CULVERTS
STA.	DIM.	LEN.	C.N.M.
84-95	18"	40'	3.5 up.
85-81			

STATE PROJECT YEAR SHEET TOTAL
 E-100P 1932 4 17

Parcel	Kind of Instrument	Date of Instrument	Grantor	Grantee	Recorded	Remarks
A	O.C.D.	1-13-33	H.S. Miner	Steffs	32 82	1-17-33

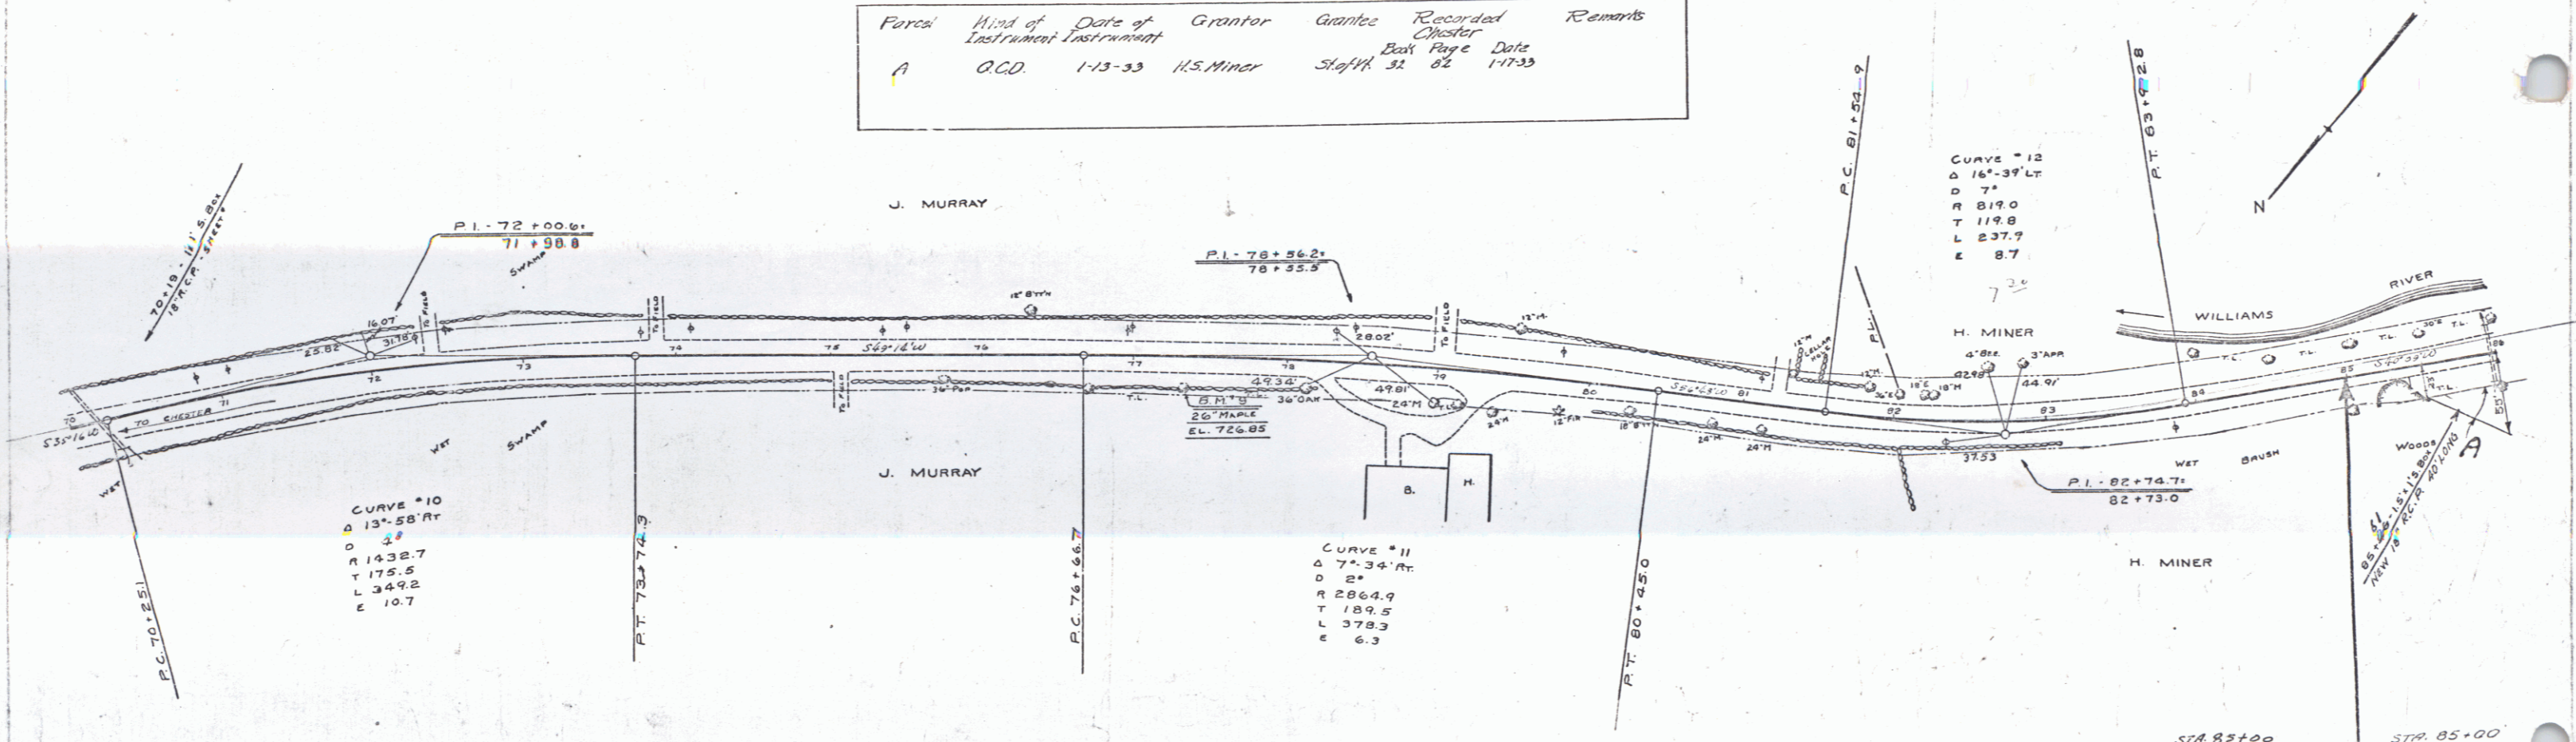

B.M. #9 SPIKE IN ROOT 26' MAPLE 19 FT. RT. STA. 77+30 EL. 726.85

SERIES No. E-100P
 SHEET 4 OF 17

9