
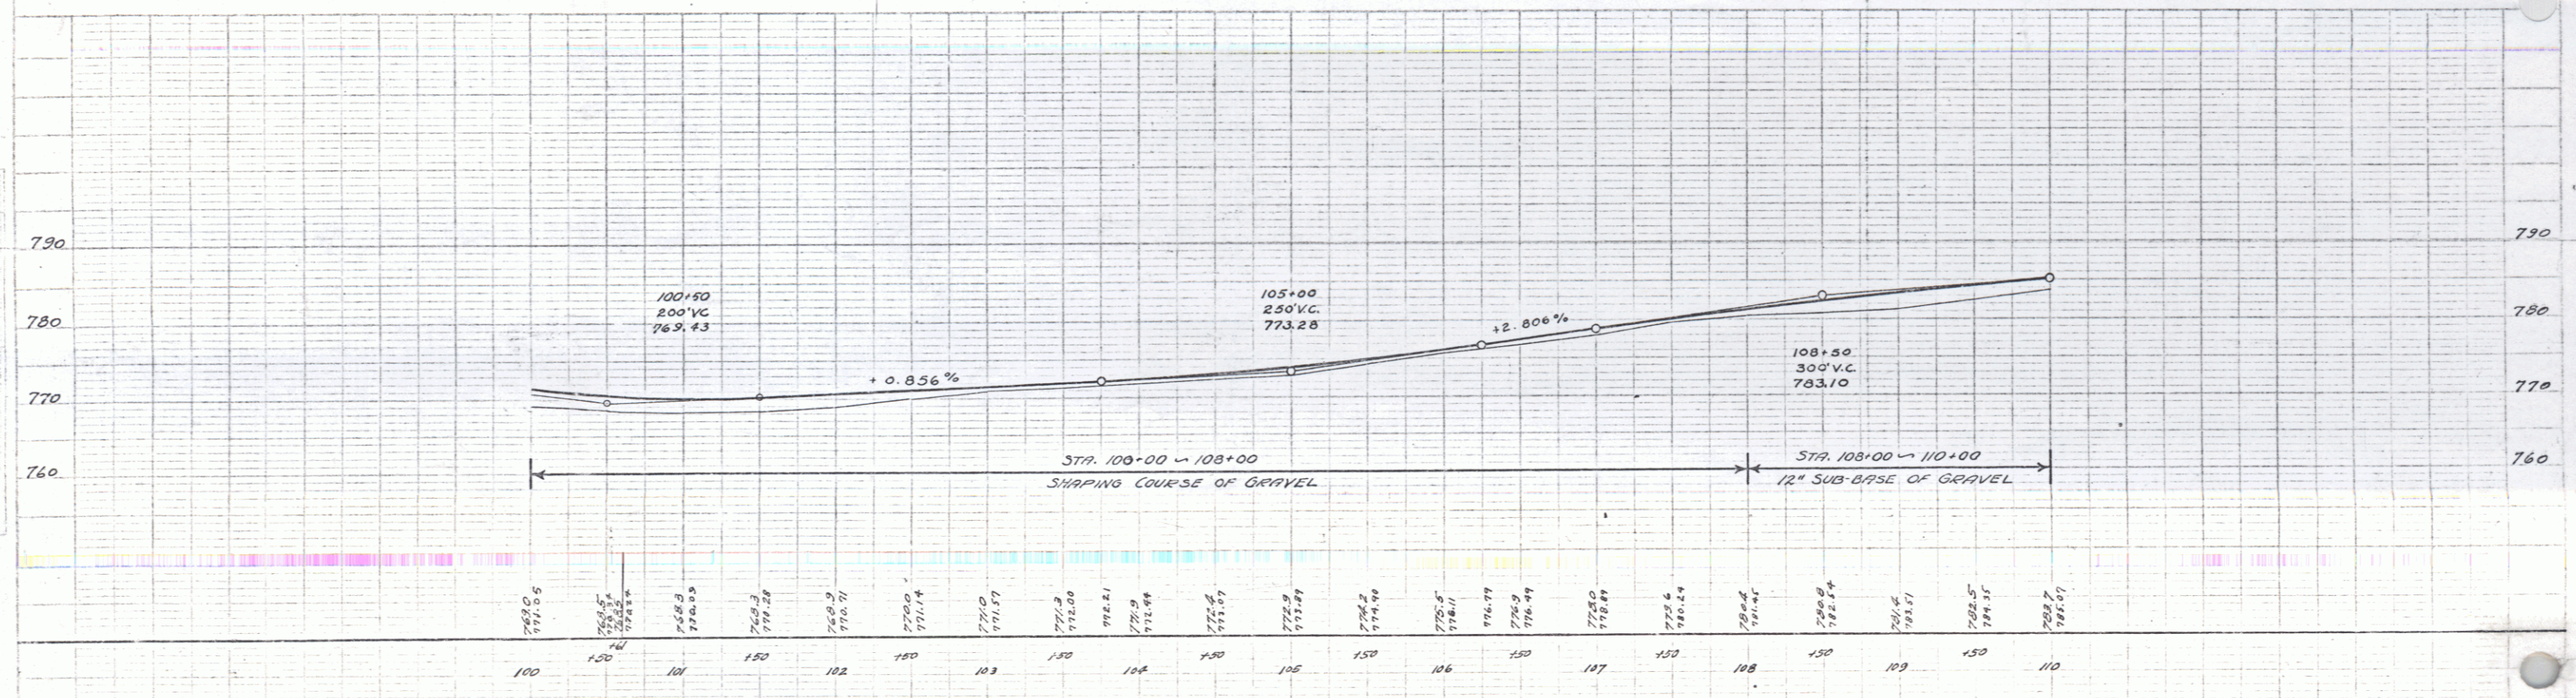


Parcel	Kind of Instrument	Date of Instrument	Grantor	Grantee	Recorded	Remarks
D	Q.C.D.	1-15-33	H.S. Minor	Staff	32 82	1-17-33
A	"	12-17-33	Ed. Day, W.A. McGuire	"	32 185	7-26-34

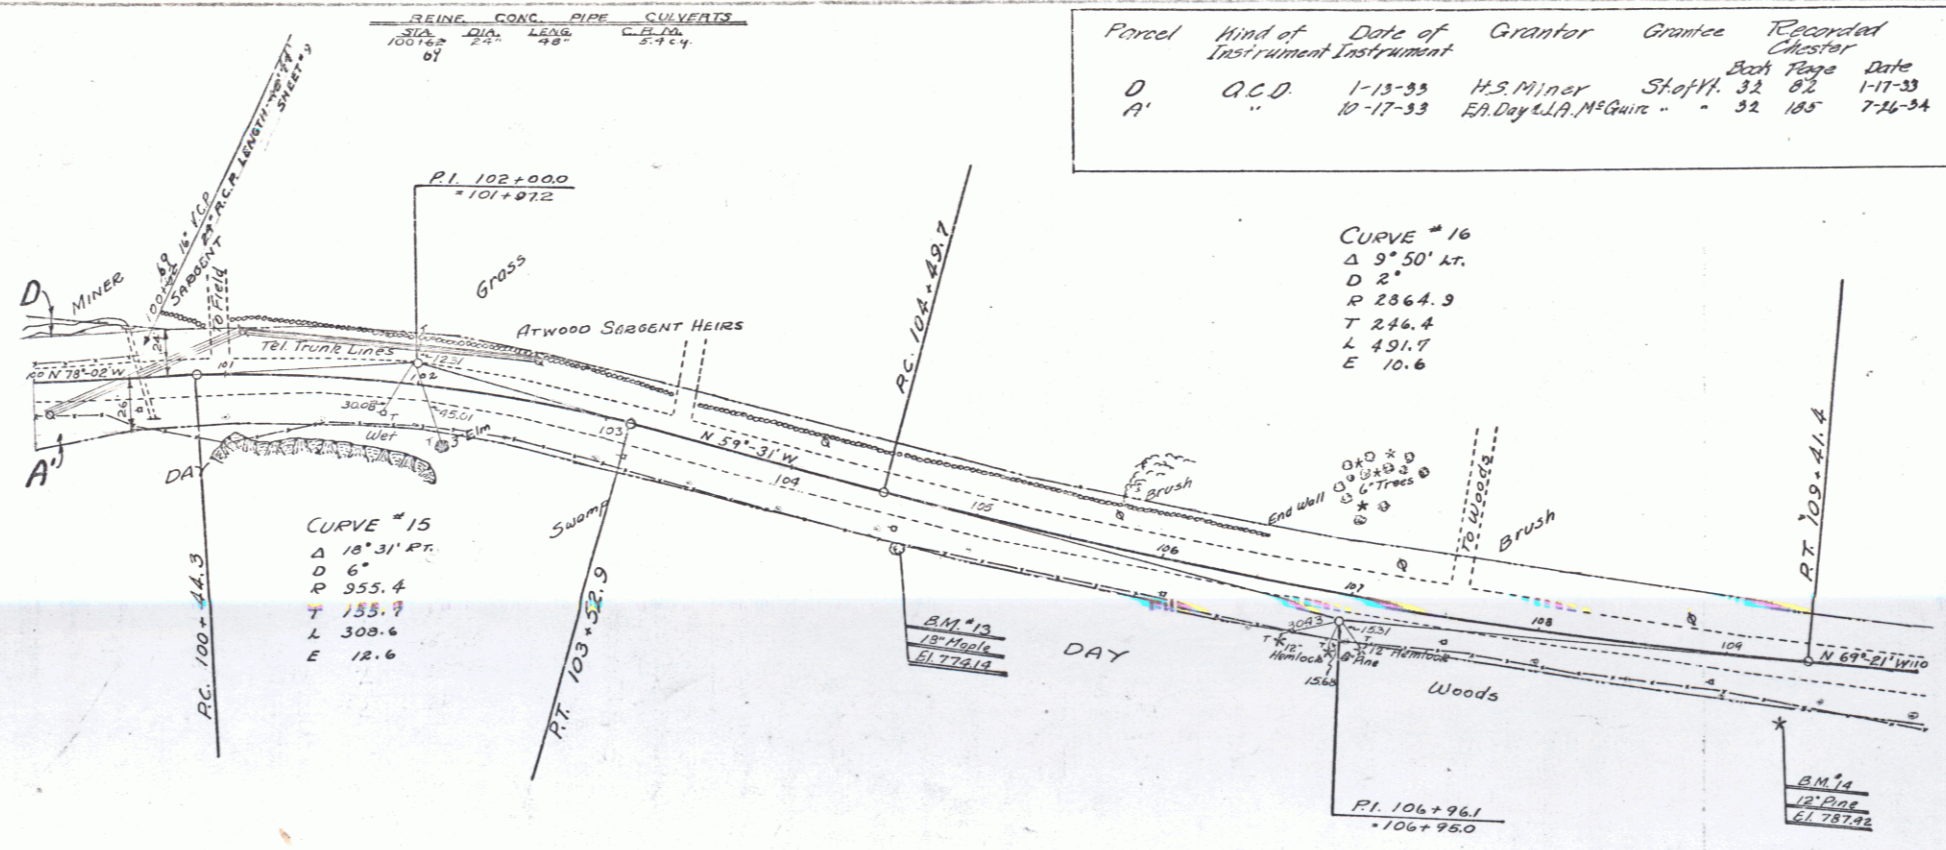

BM #13 SPIKE IN ROOT 16" MAPLE STA. 104+62 ELEV. 774.14
 BM #14 SPIKE IN ROOT 12" PINE STA. 109+34 ELEV. 751.92

Handwritten initials and number: J.E. 11