



POOR ORIGINAL COPY

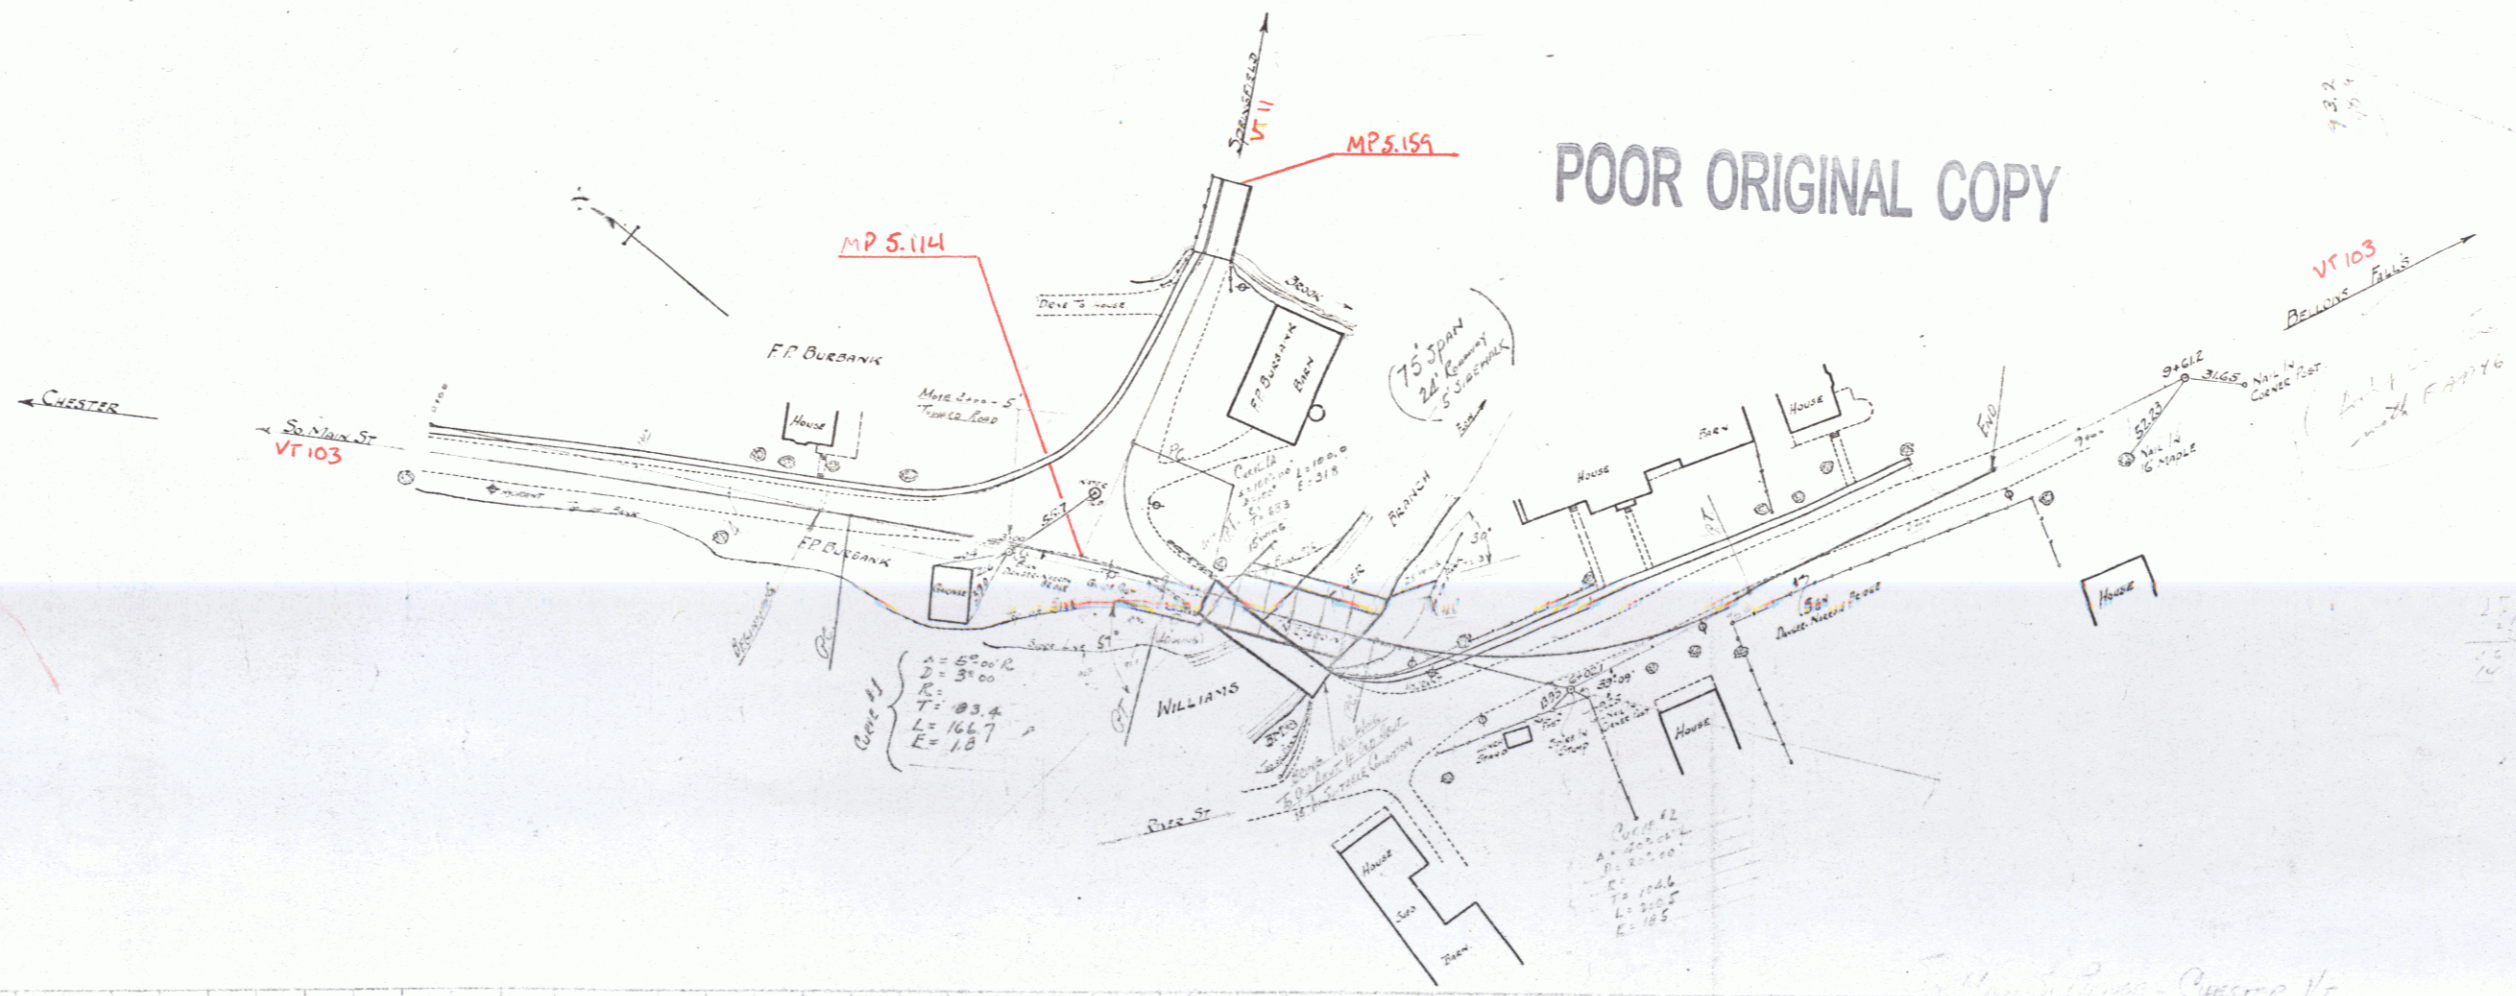

(Worreny Concrete Area Below (2 Hrs. Upstream) = 570 sq. ft.
 Worreny Area Below (75' from Area E.
 (at R.O. to Area) = 608 sq. ft.

Five of New Apartments - 411 and 416

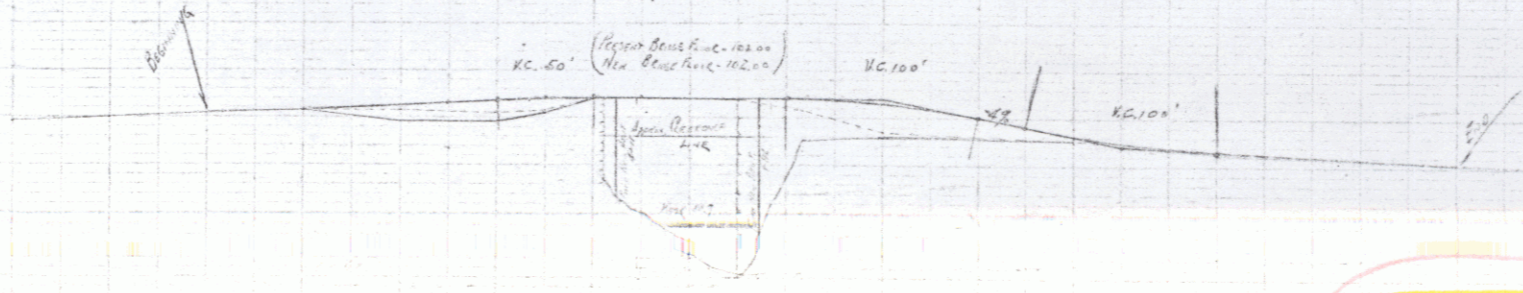

Town of Chester

1/11930?

Project No. Chester Village
 Pin# 99R878
VTR 11