


POOR ORIGINAL COPY

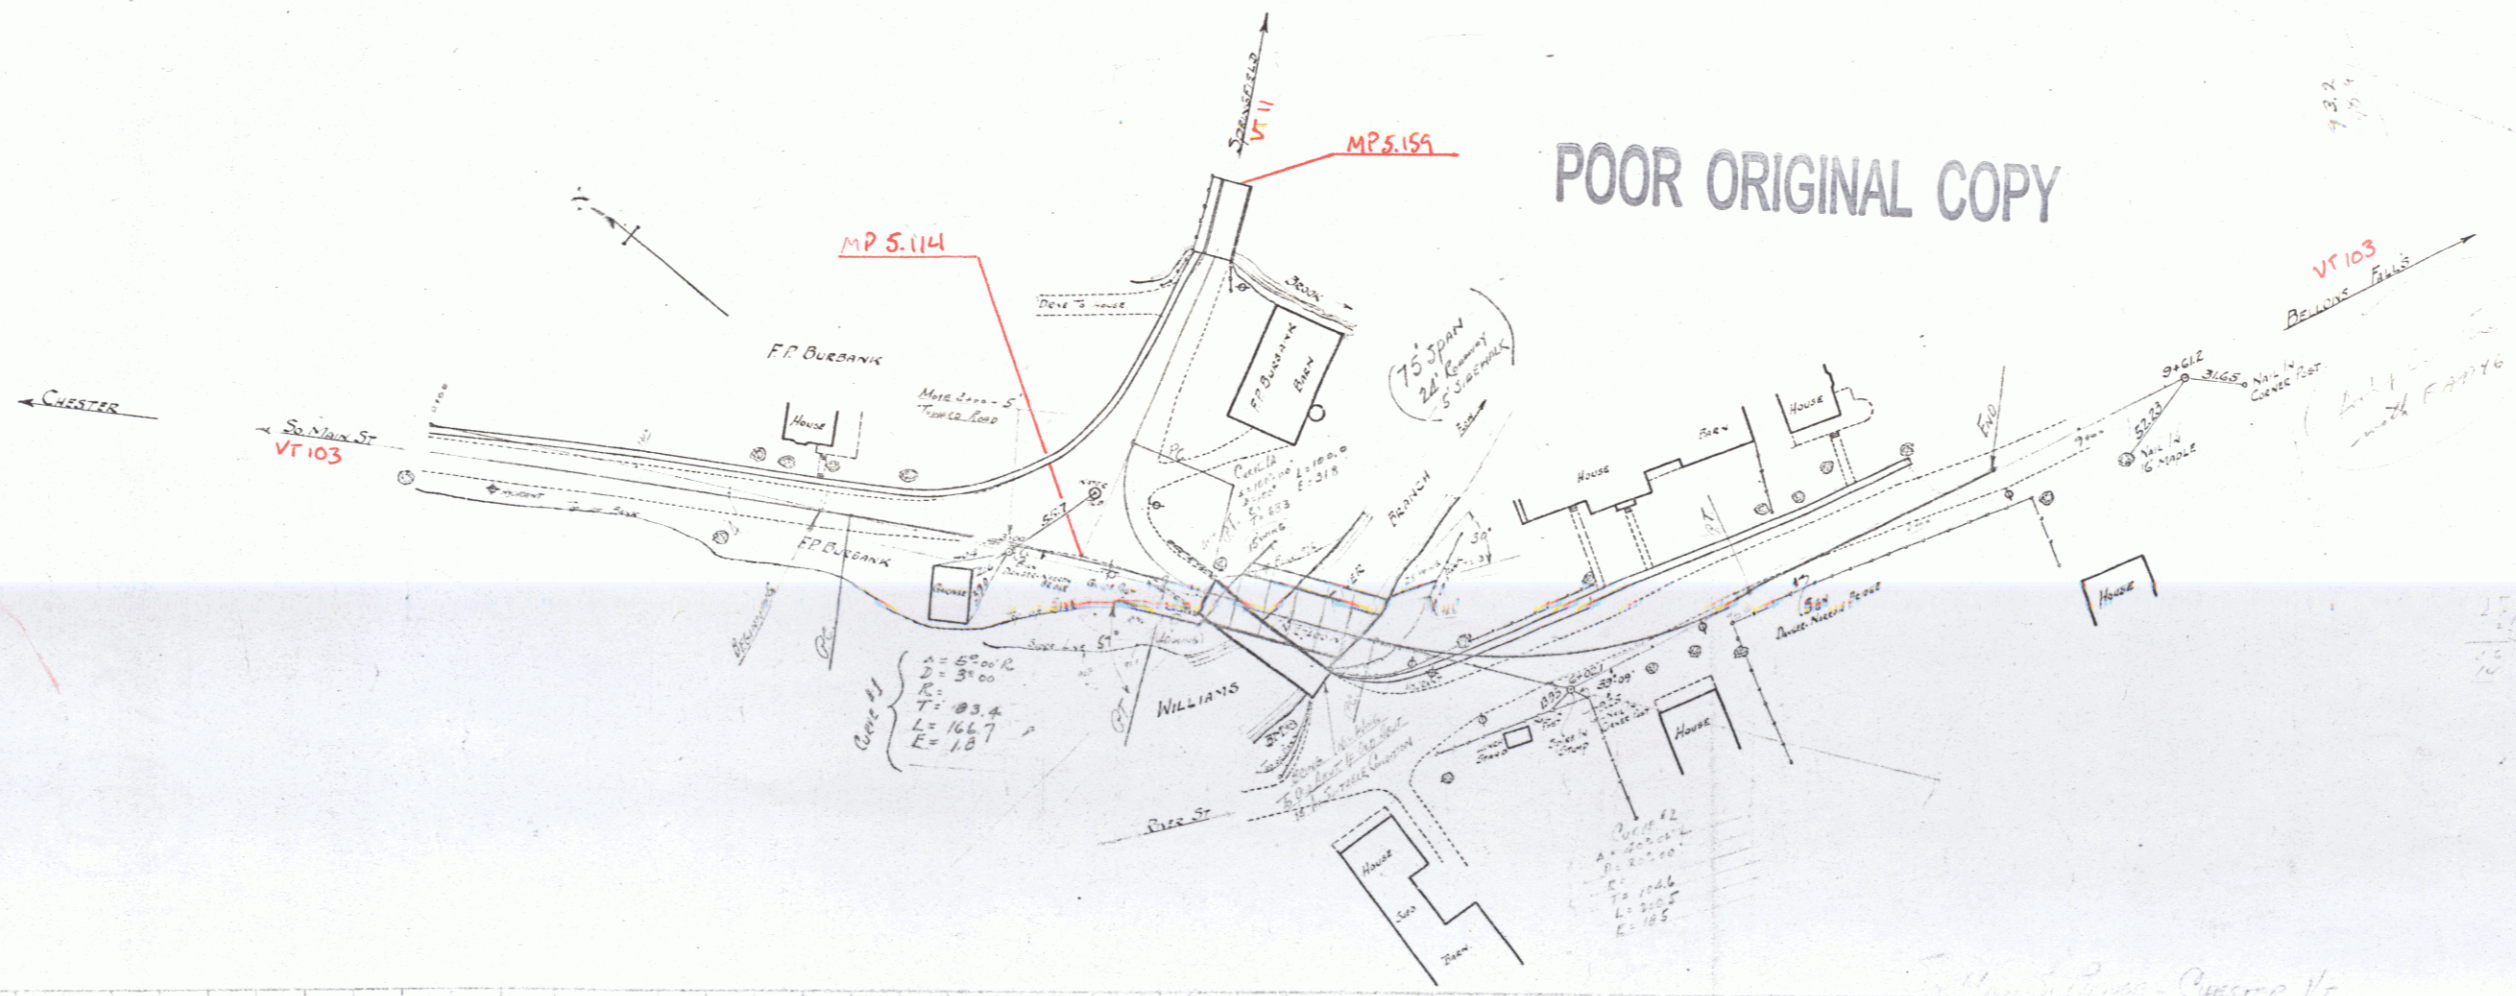

MP 5.114

MP 5.159


VT 103

VT 103

Curve 1/2  
 Δ = 5° 40' 12"  
 R = 31' 00"  
 T = 103.4'  
 L = 166.7'  
 E = 1.8'

(Worreny Concrete Area Below (2 Hrs Upstream) = 570 sq ft.  
 Worreny Area Below (75' span Area E.  
 (24' at R.O. to Area) = 608 sq ft.)

Five of New Movements - 4-11 and 4-86

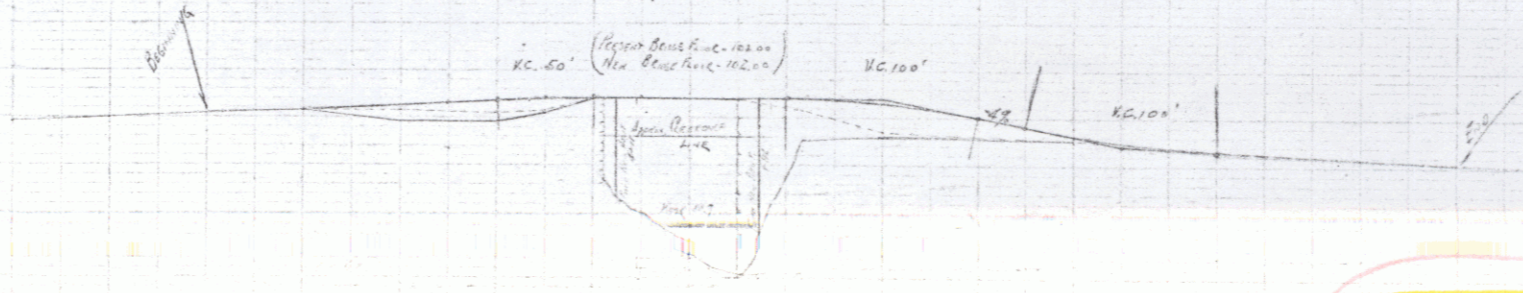

Town of Chester

1/1/1930?

Project No. Chester Village

Pin# 99R878

VT Rte 11