



PANEL	INSTRUMENT	DATE	GRANTOR	GRANTEE	RECORDED	CHESTER	REMARKS
A	W.D.O.E. AGREEMENT	1-8-47	ADEN FOSTER	STOF VT.	35	38	1-14-47
B	W.D.O.E.	7-28-47	WM.H. & LOTTIE A. HOSKINS	" "	35	43	1-14-47
A'	" " " "	7-28-47	ADEN E. FOSTER	" "	36	189	8-9-47
	" " " "	7-28-47	WM.H. & LOTTIE A. HOSKINS	" "	36	172	8-9-47

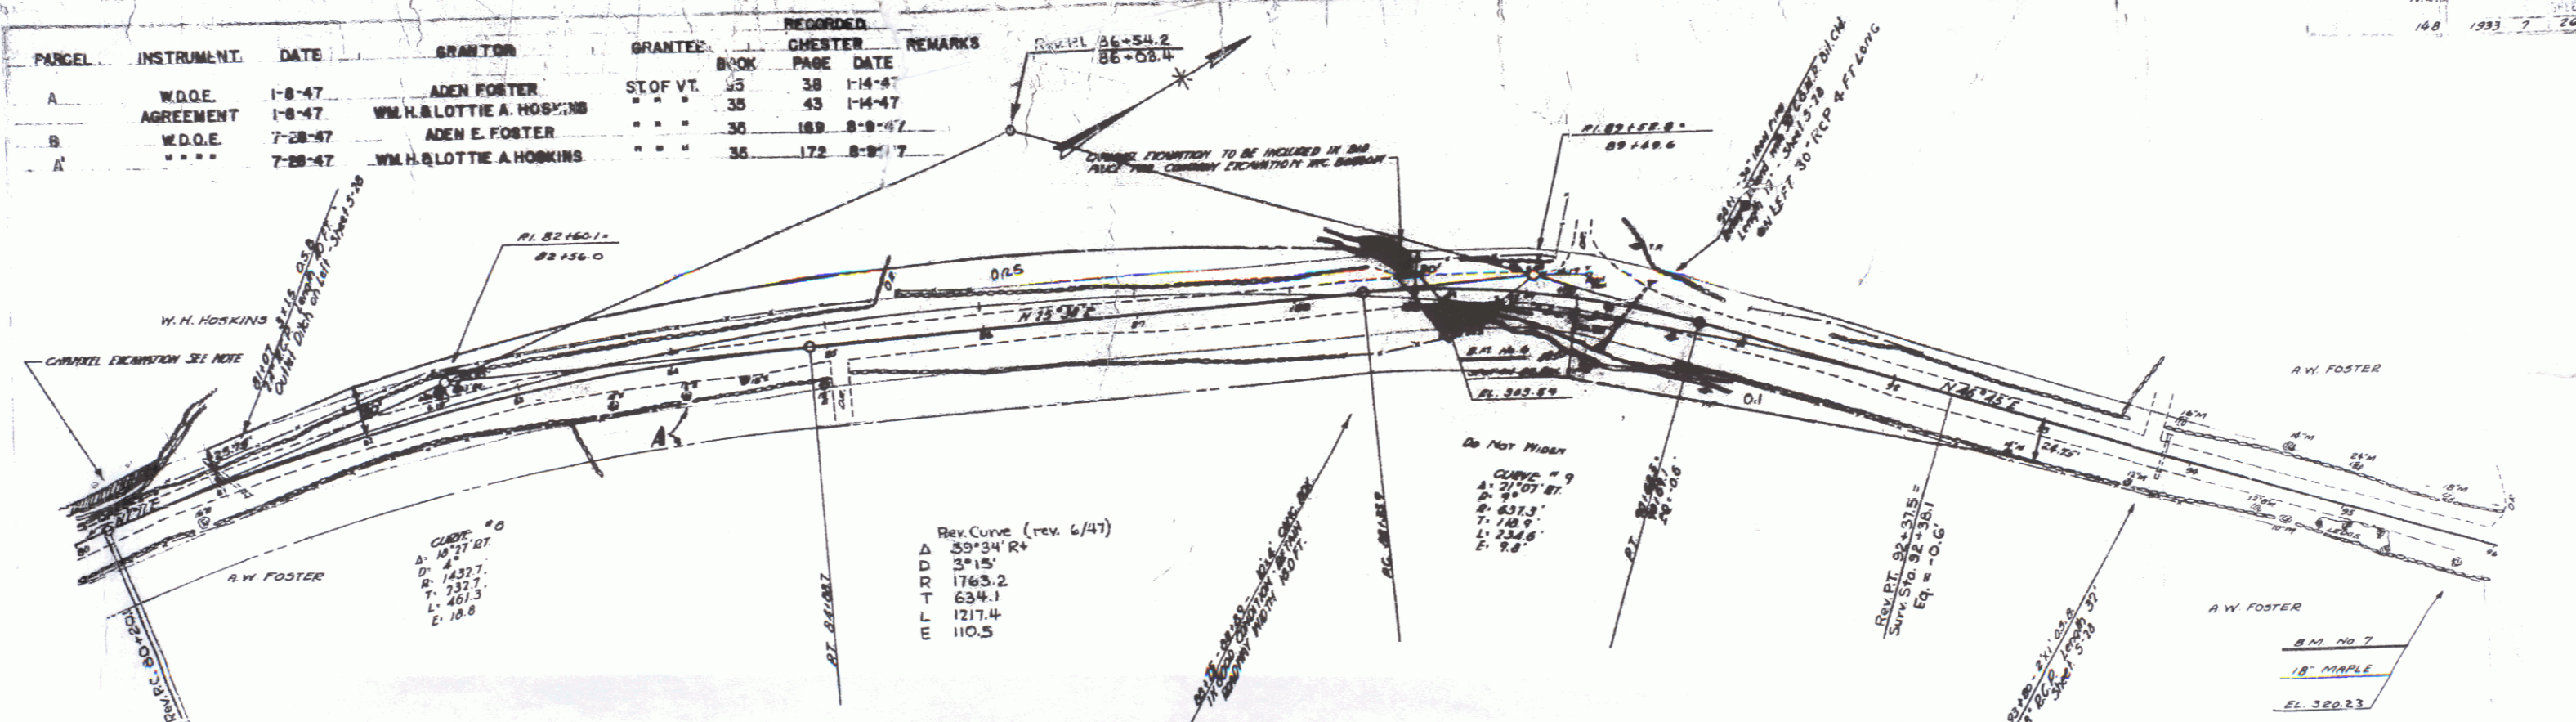

POOR ORIGINAL COPY

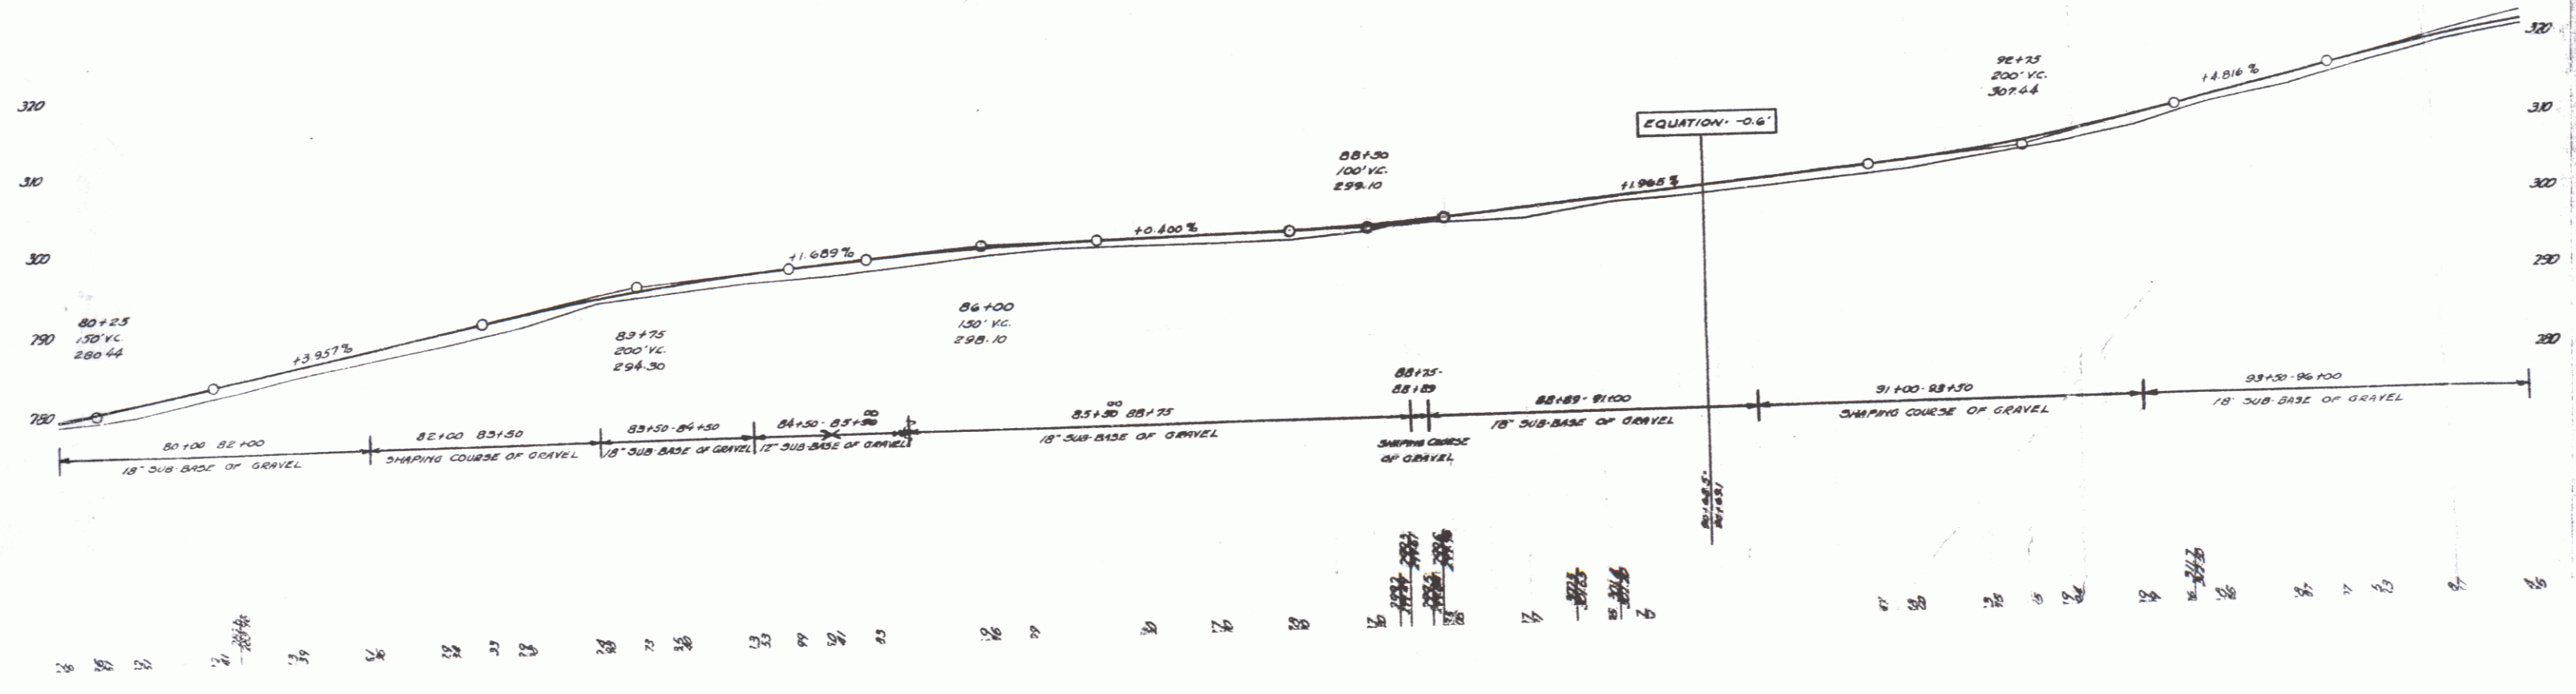

②
5