
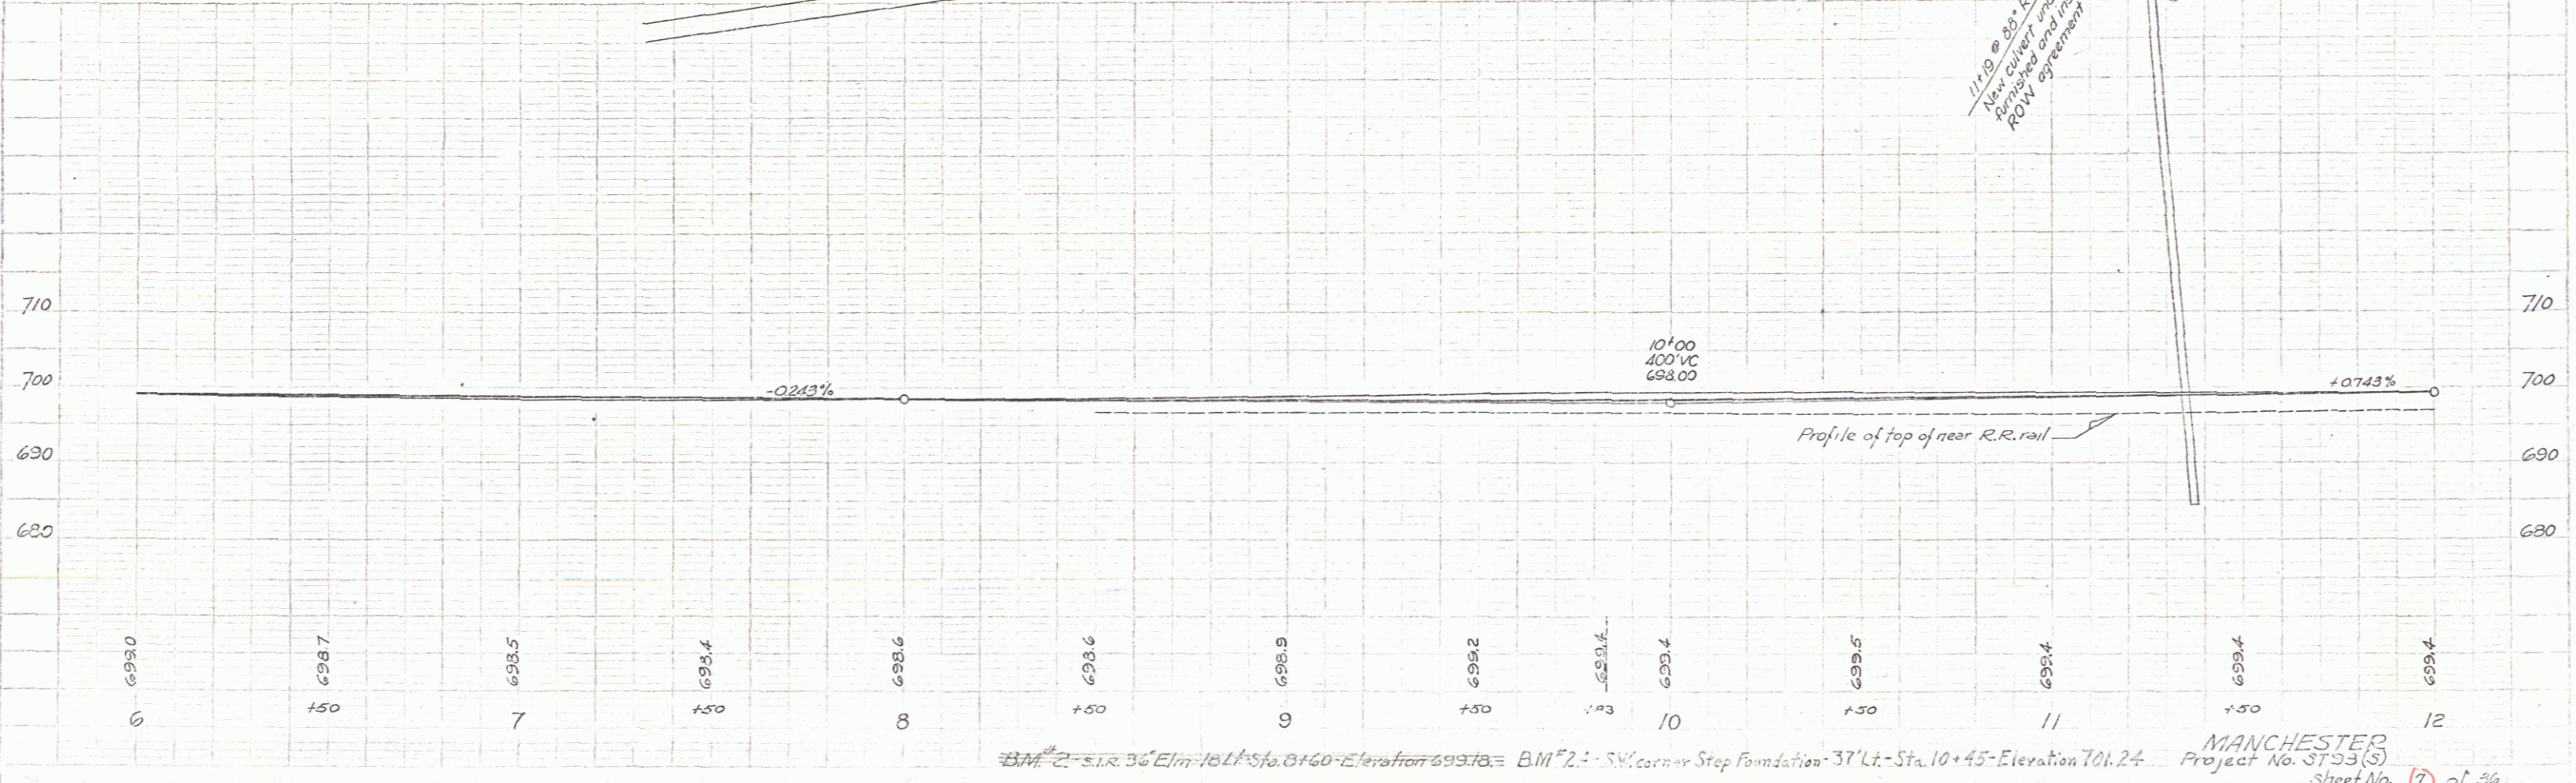


Cutting & Removing Trees
from 110
6+17 Lt 30° E
8+76 Lt 36° E
8+80 Lt 36° E
8+90 Lt 24° M
9+66 Lt 30° E
10+60 Lt 24° M
11+83 Lt 24° E.
BROWN & HITCHCOCK

Construct Drives
6+18 Lt 7+54 Lt
8+42 Lt
9+31 Lt
9+67 Lt
11+32 Lt
Construct Approach
9+80 Lt

Seeding Item 611
Fertilizer Item 615
Top Soil Item 621
6+00-6+03 Lt
6+130-7+140 Lt
7+70-8+30 Lt
8+50-9+20 Lt
9+30-9+70 Lt
10+06-9+80-11+44 Lt
11+50-12+00 Lt

Concrete Gravity Curb
Concrete Class B Item 401B
6+00-6+03 Lt
6+130-7+140 Lt
7+150-8+30 Lt
8+50-9+20 Lt
9+30-9+70 Lt
10+06-9+80-11+44 Lt
11+50-12+00 Lt

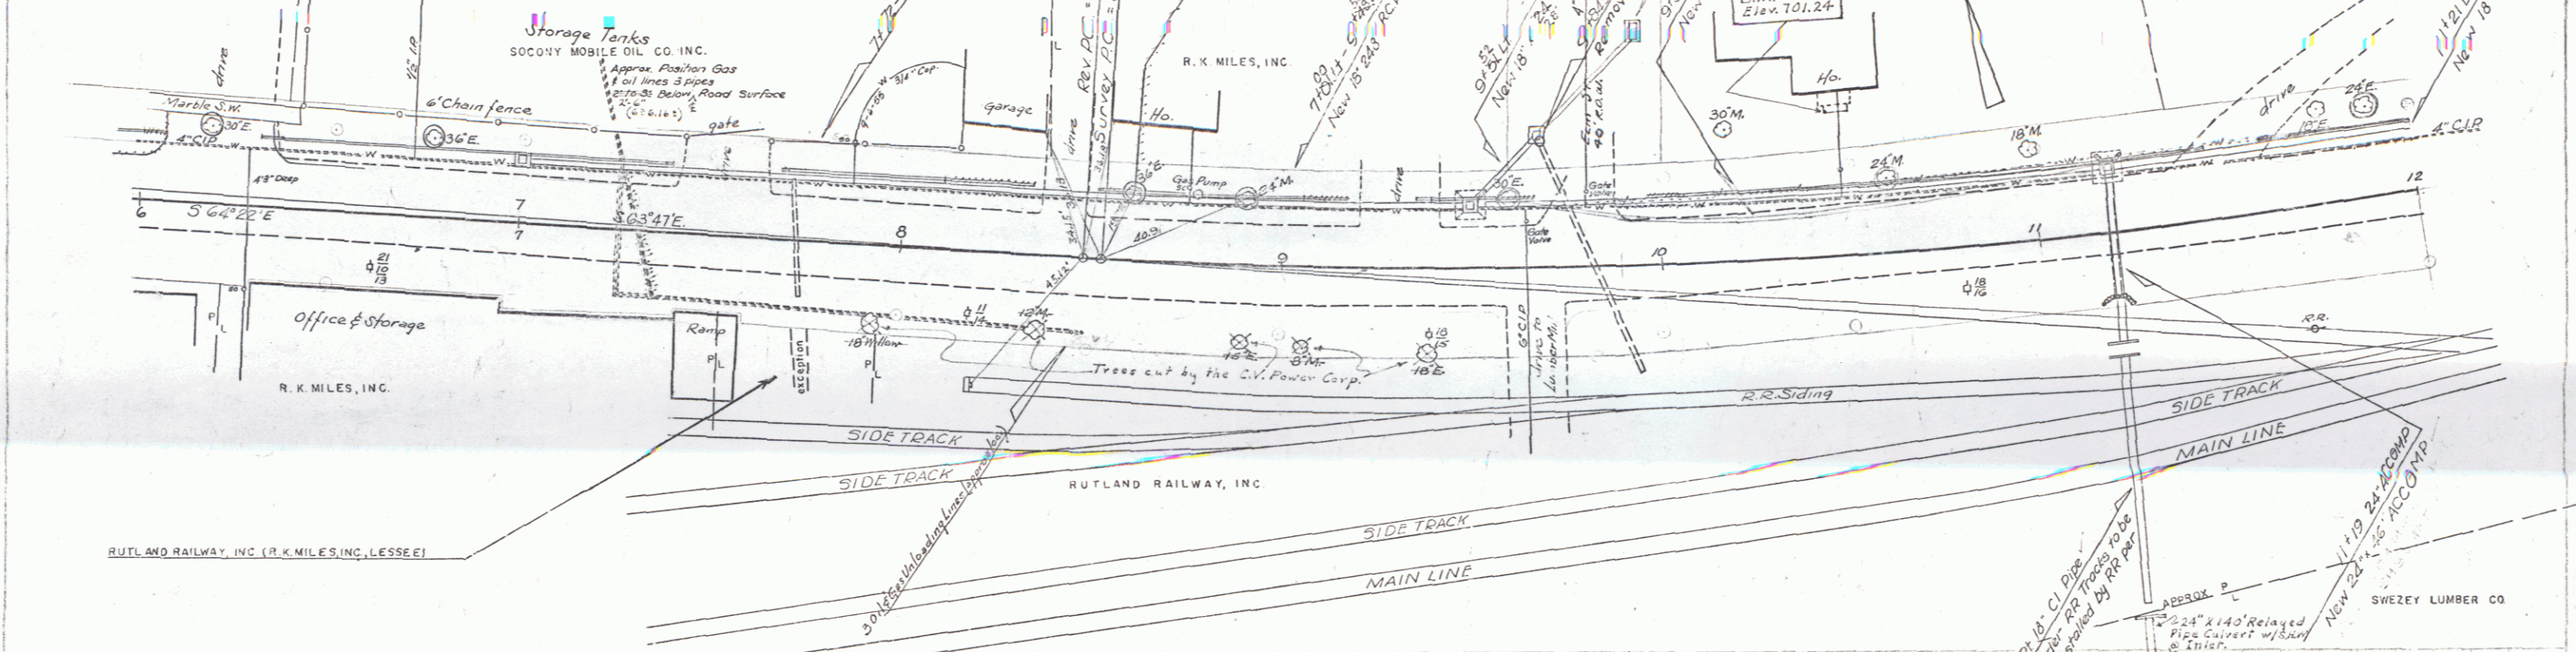

B.M. #2 - S.W. corner Step Foundation - 37' Lt. Sta. 10+45 - Elevation 701.24
 MANCHESTER Project No. 3755(S) Sheet No. 17 of 36