

Cutting & Removing Trees  
 Item 110  
 12+79.5 Lt 24'M  
 12+92.5 Lt 36'E  
 13+20 Rt 30'E  
 14+03 Lt 30'E  
 15+28 Rt 18'E  
 16+04 Rt 21'E  
 12+48 Lt 18'M



Rev Curve  
 $\Delta 28^{\circ} 58'$   
 $D 3^{\circ} 33' 47''$   
 $R 1608.1$   
 $T 415.4$   
 $L 213 @ 81+0$   
 $E 52.0$   
 Bank 1/4" per ft

Construct Drive  
 14+18 Lt

Concrete Gravity Curb  
 Concrete Class B Item 4018  
 12+00 - 14+18 Lt  
 14+28 - 17+00 Lt  
 31

Seeding Item 61/  
 Fertilizer Item 62/  
 Top Soil Item 62/  
 12+00 - 14+18 Lt  
 14+28 - 17+00 Lt  
 51

Three Cable Guard Rail/Steel Posts  
 17+70 - 22+50 Rt

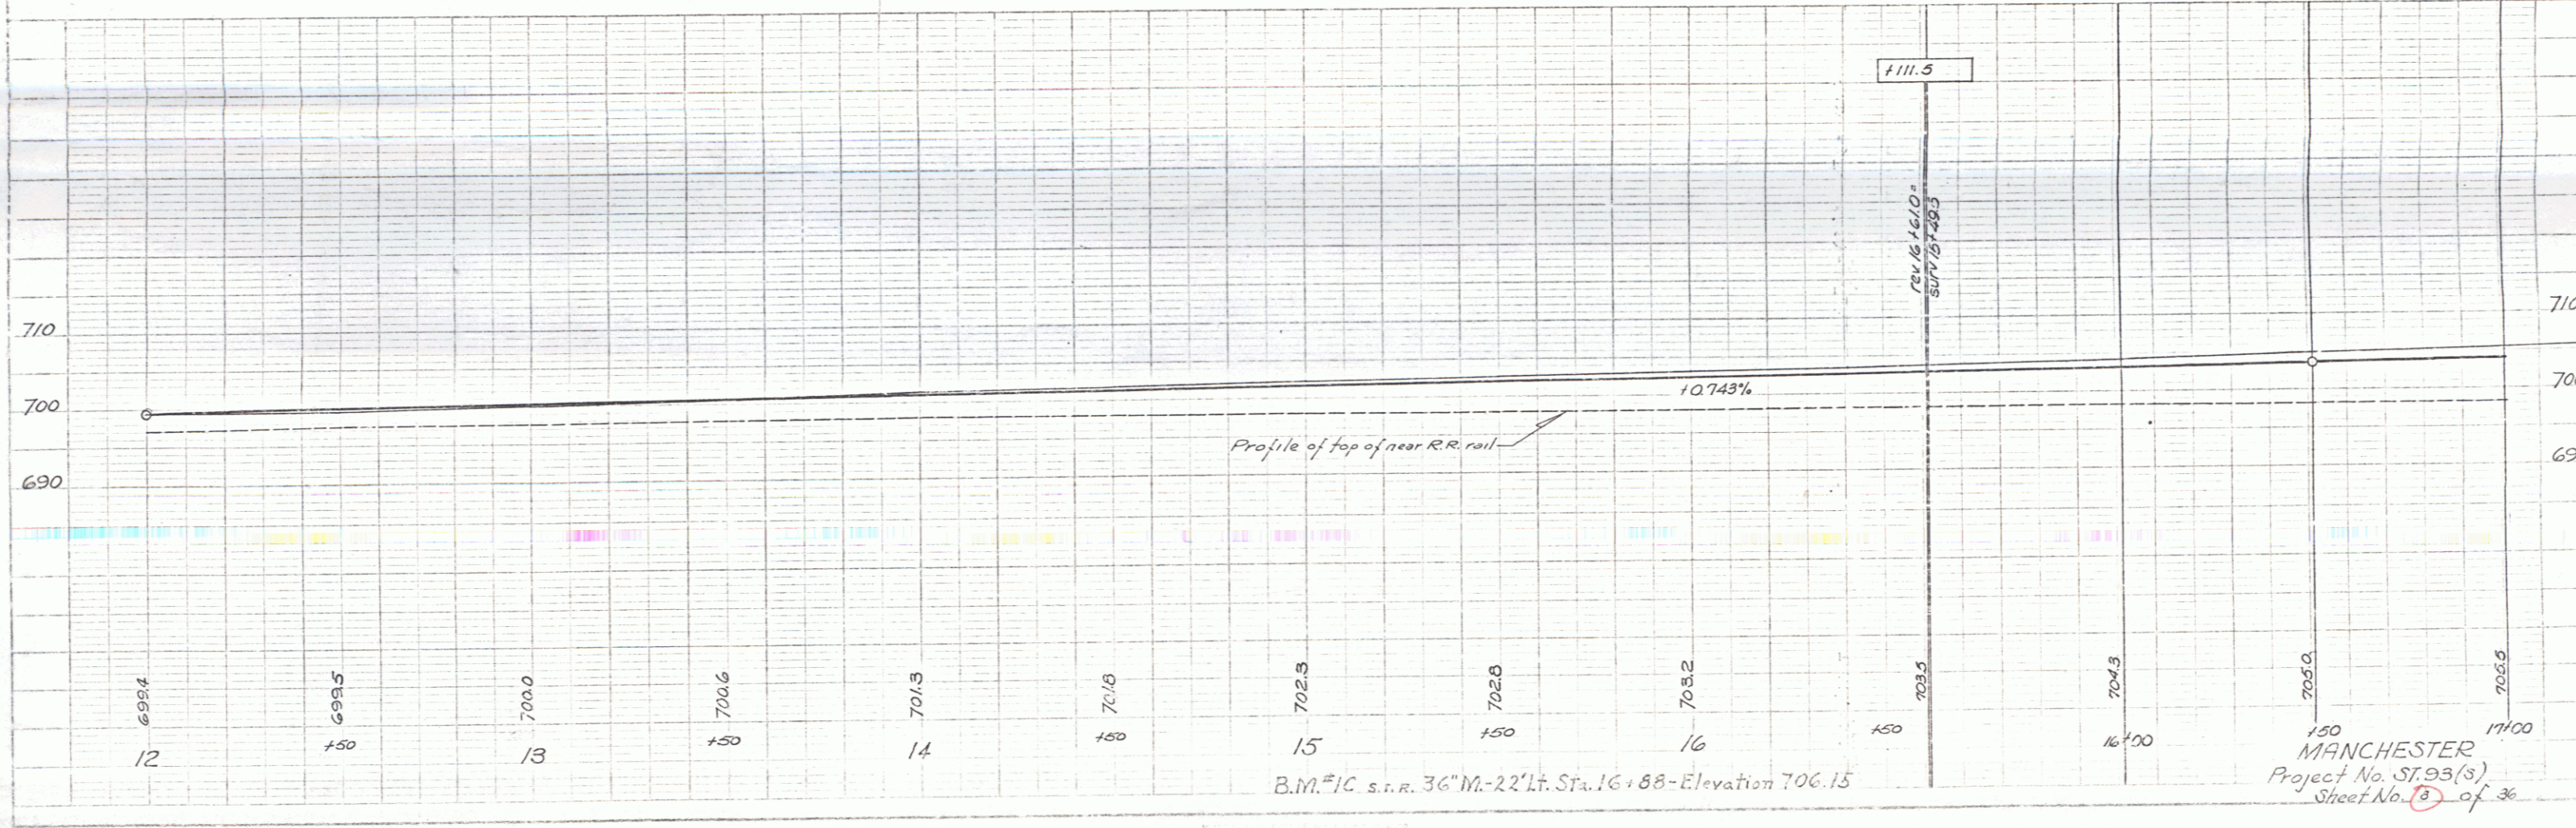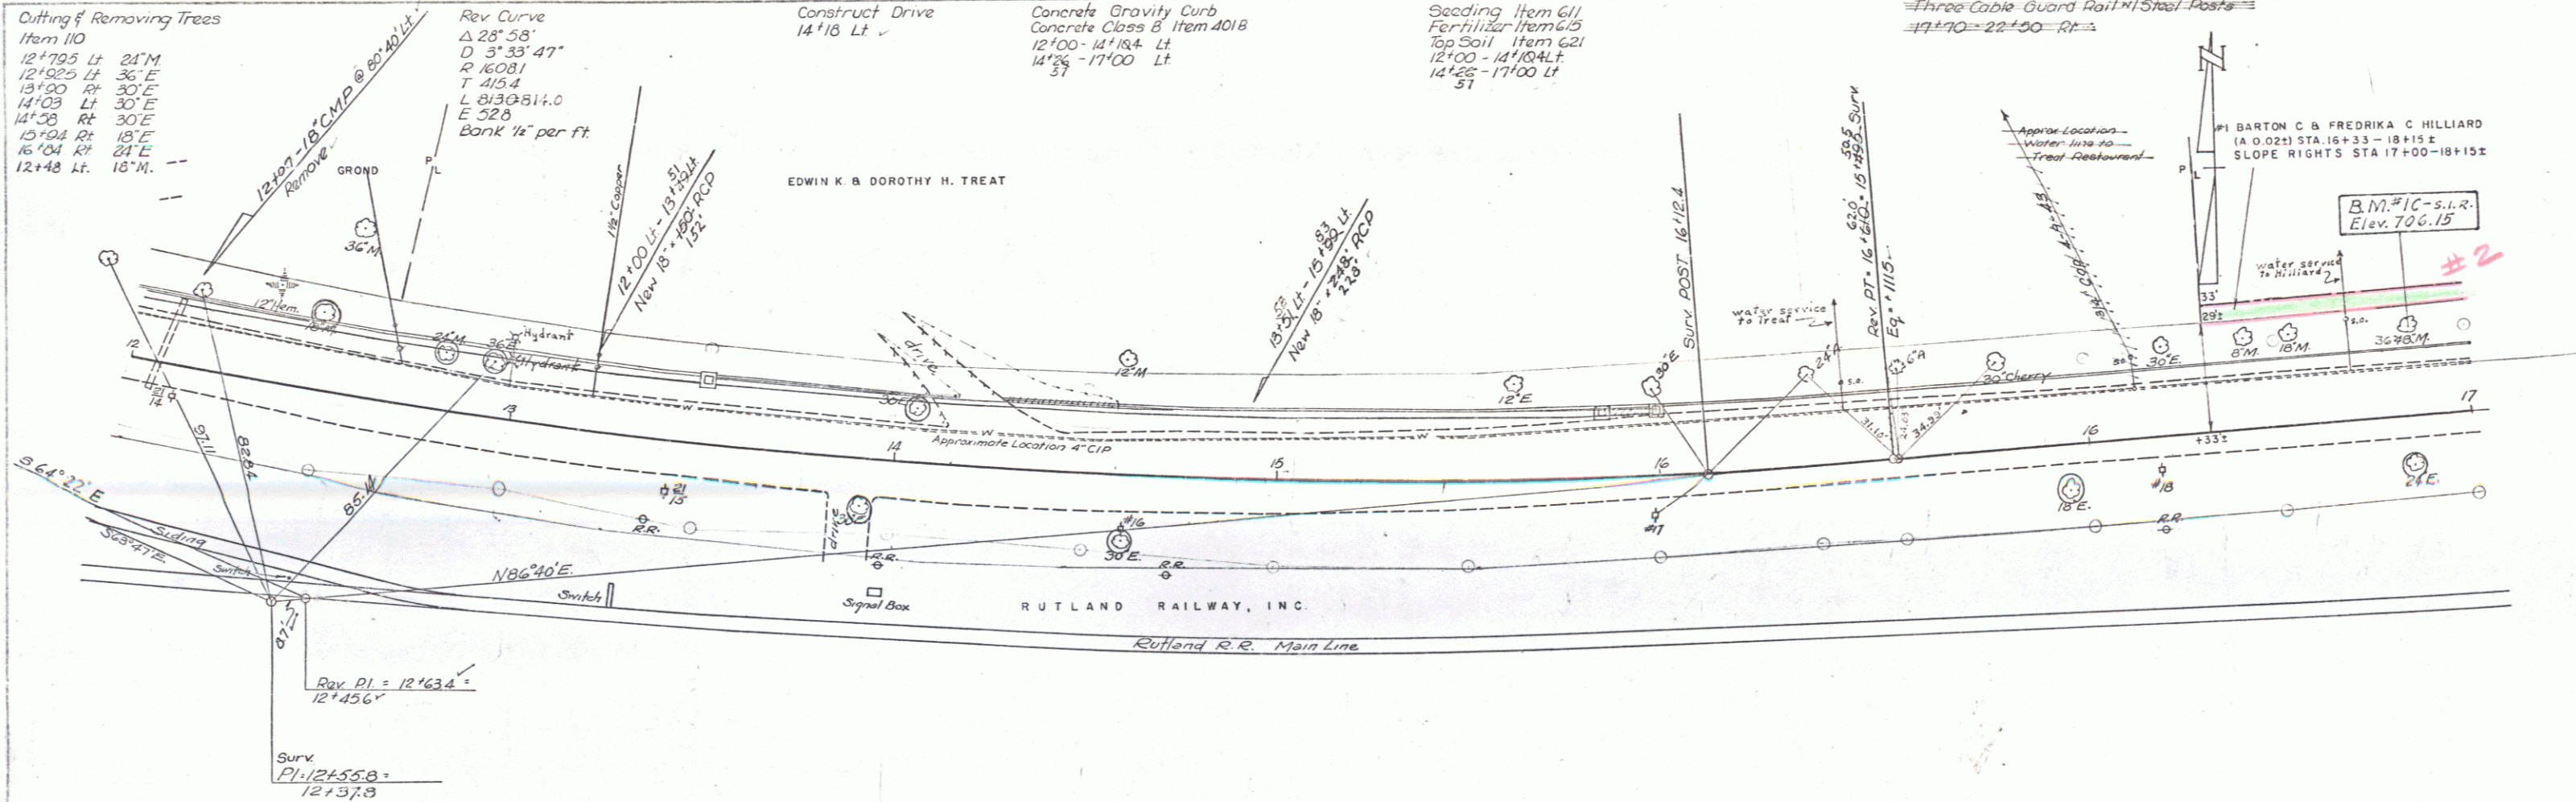

3/17/10  
 1/10/10

1/10/10