

Seeding Item 611
Fertilizer Item 615
Top Soil Item 621

Cutting & Removing Trees
From 110
3" 19 RT - Stump



Note: UTILITIES LEGEND
— w — water pipe
— s — sanitary sewer
Locations of sanitary sewer and water systems are approximate
Gradient of sanitary sewer is approx. -0.5% westerly

Construct Drives
0+38 Lt 0+21 Lt
0+99 Lt
2+34 Lt
3+18 Lt
3+65 Rt
3+97 Lt
4+49 Lt
5+25 Rt
5+25 Lt

LEGEND
○ Remove Tree
X Tree cut by the C.V. Power Corp.

Concrete Gravity Curb
Concrete Class 8 Item 401B
0+72-0+90 Lt 4+61-5+50 Lt
1+14-1+07- 2+262 Lt
2+44 2+42- 3+02 Lt
3+33 3+33- 3+82 Lt
4+12- 4+30 Lt
5+75 5+75- 6+00 Lt

Rev. Curve
Δ 1' 17' Lt
R 11,459.2
T 128.3
L 256.7
E 0.7
Do not bank

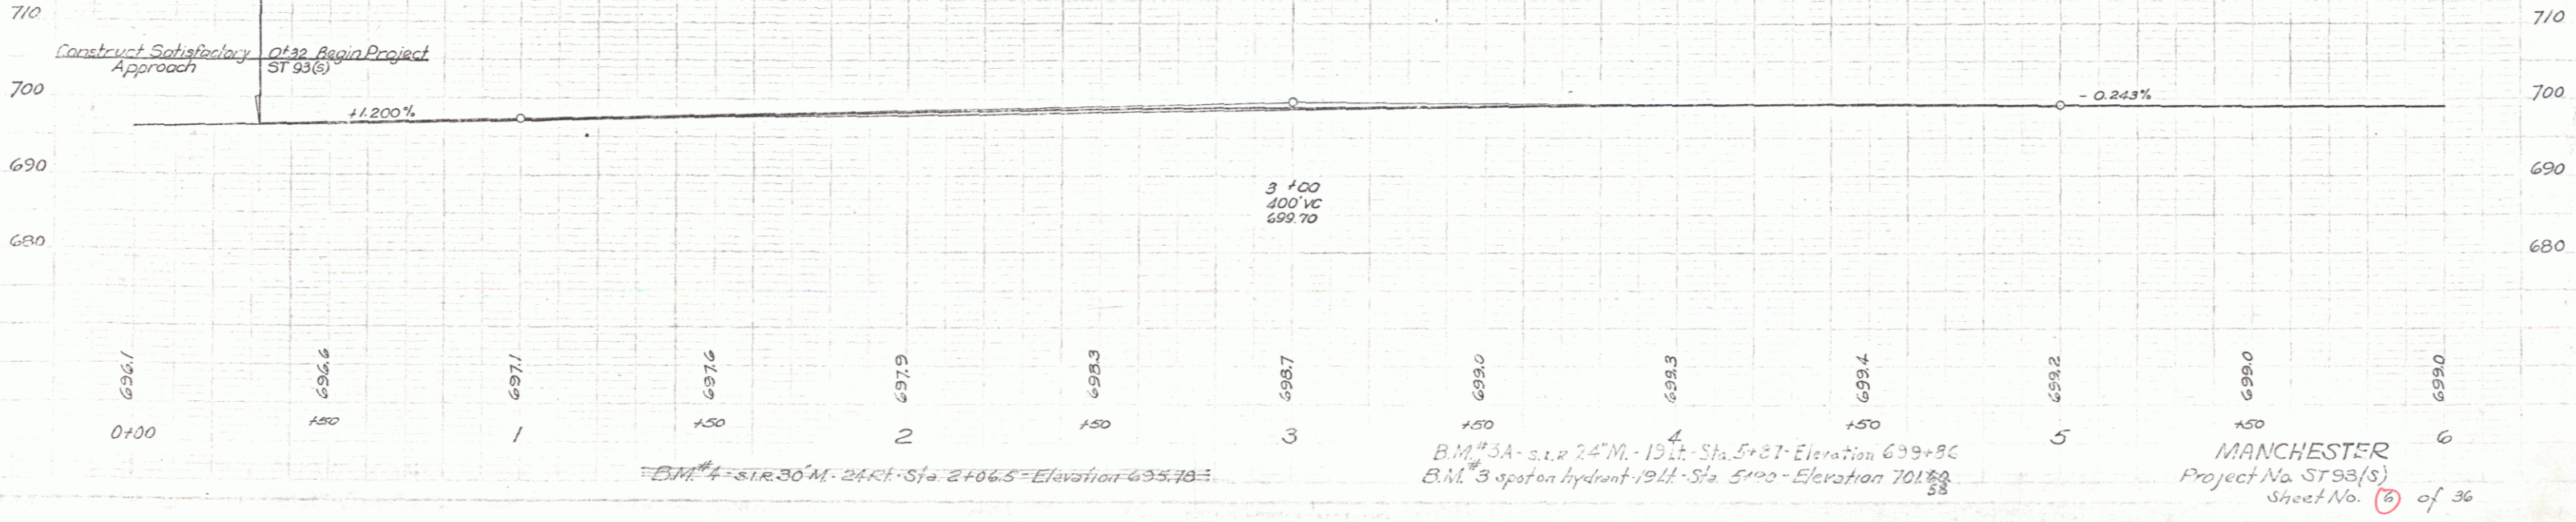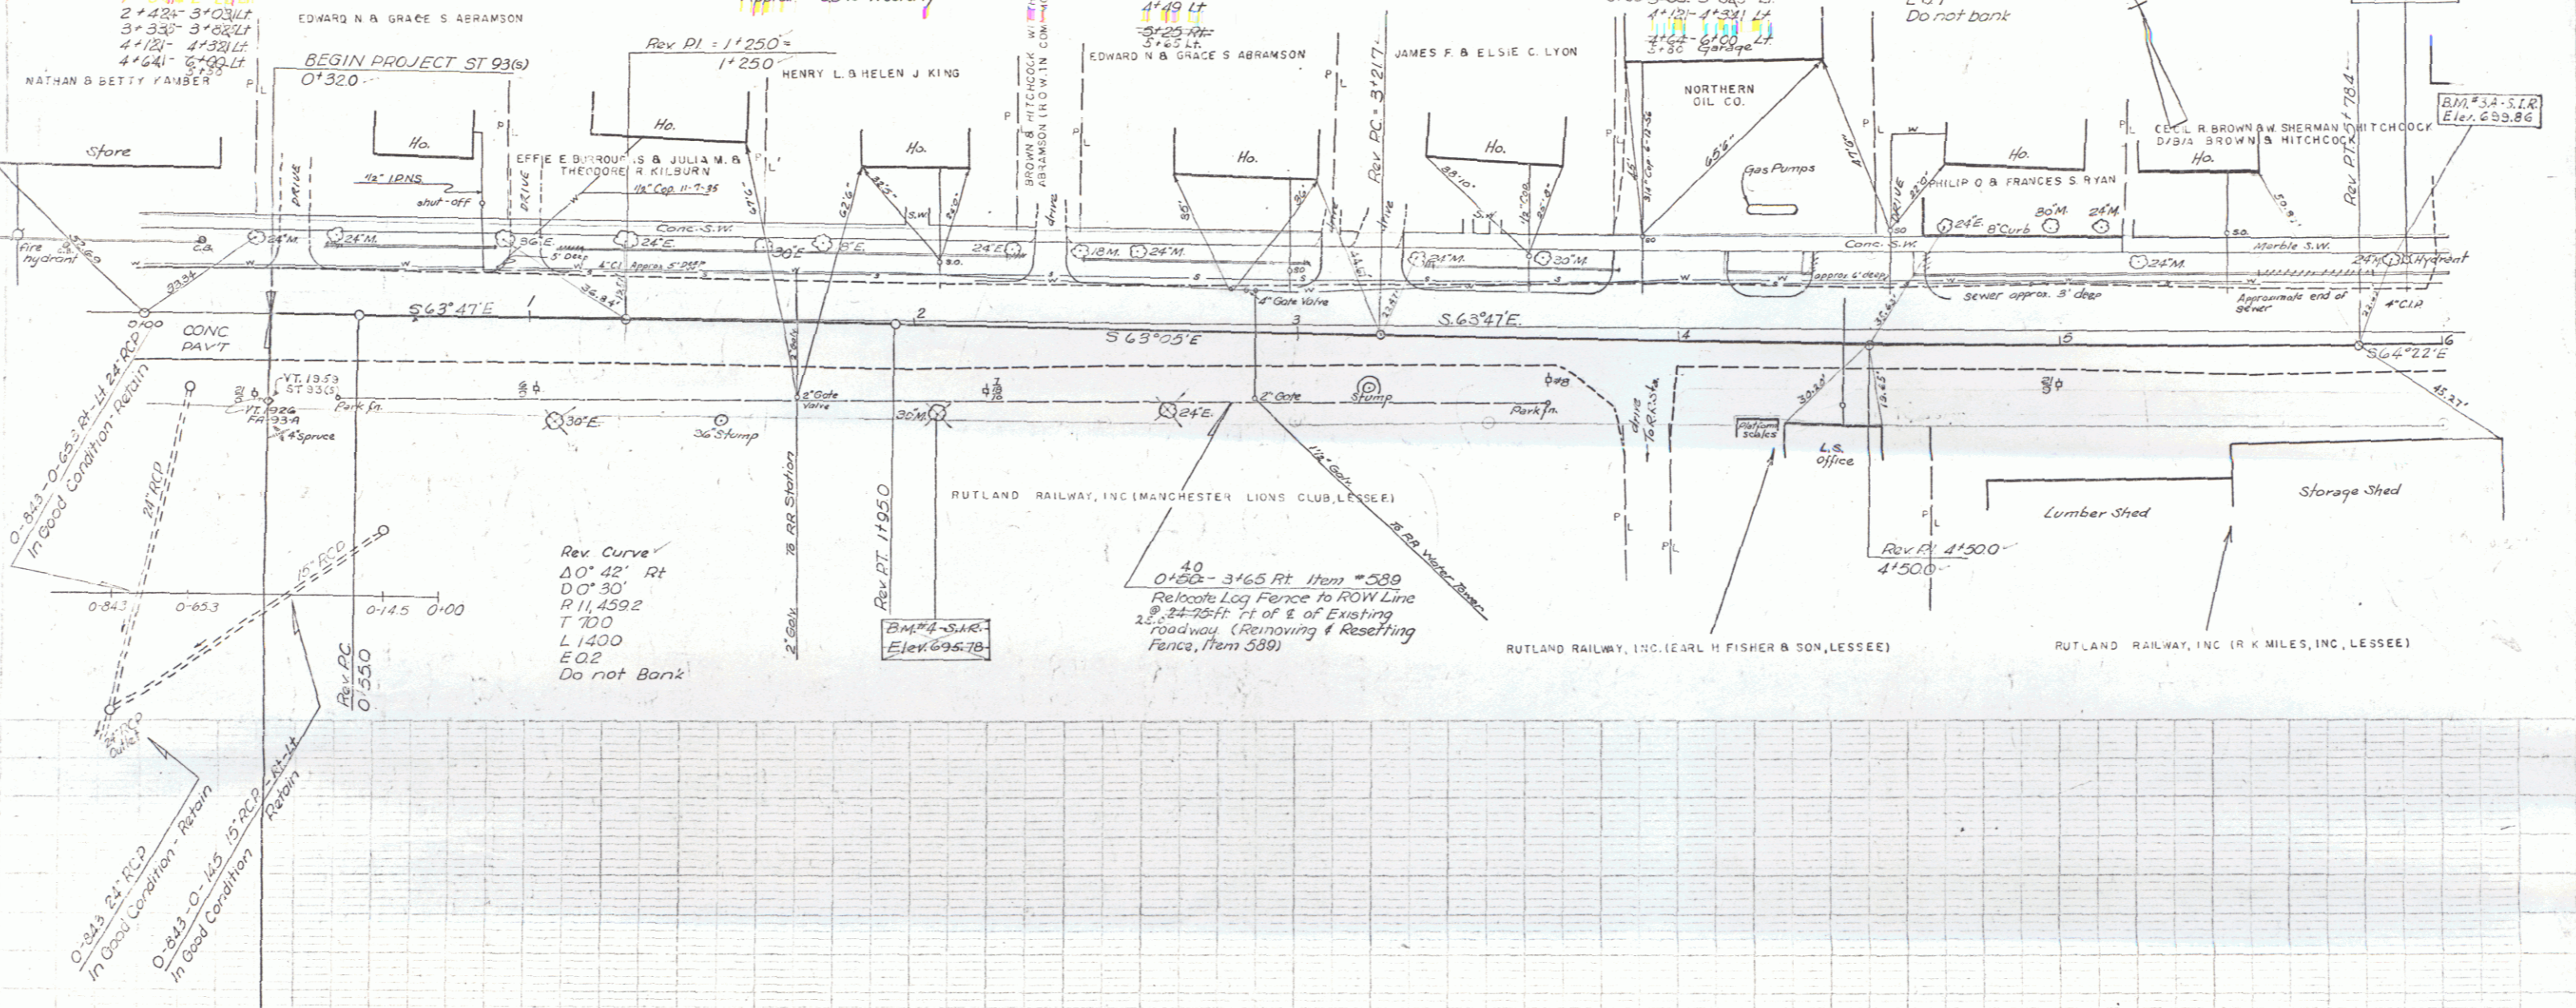



MANCHESTER
Project No. ST93(s)
Sheet No. 16 of 36

Cutting & Removing Trees
from 110
6+17 Lt 30° E
8+76 Lt 36° E
8+80 Lt 36° E
8+90 Lt 24° M
9+66 Lt 30° E
10+60 Lt 24° M
11+83 Lt 24° E.
BROWN & HITCHCOCK

Construct Drives
6+18 Lt 7+54 Lt
8+42 Lt
9+31 Lt
9+67 Lt
11+32 Lt
Construct Approach
9+80 Lt

Seeding Item 611
Fertilizer Item 615
Top Soil Item 621
6+00-6+03 Lt
6+130-7+140 Lt
7+70-8+30 Lt
8+100-9+120 Lt
9+130-9+140 Lt
10+06-9+180-11+44 Lt
11+50-12+00 Lt



Concrete Gravity Curb
Concrete Class B Item 401B
6+00-6+03 Lt
6+130-7+140 Lt
7+150-8+30 Lt
8+100-9+120 Lt
9+130-9+140 Lt
10+06-9+180-11+44 Lt
11+50-12+00 Lt

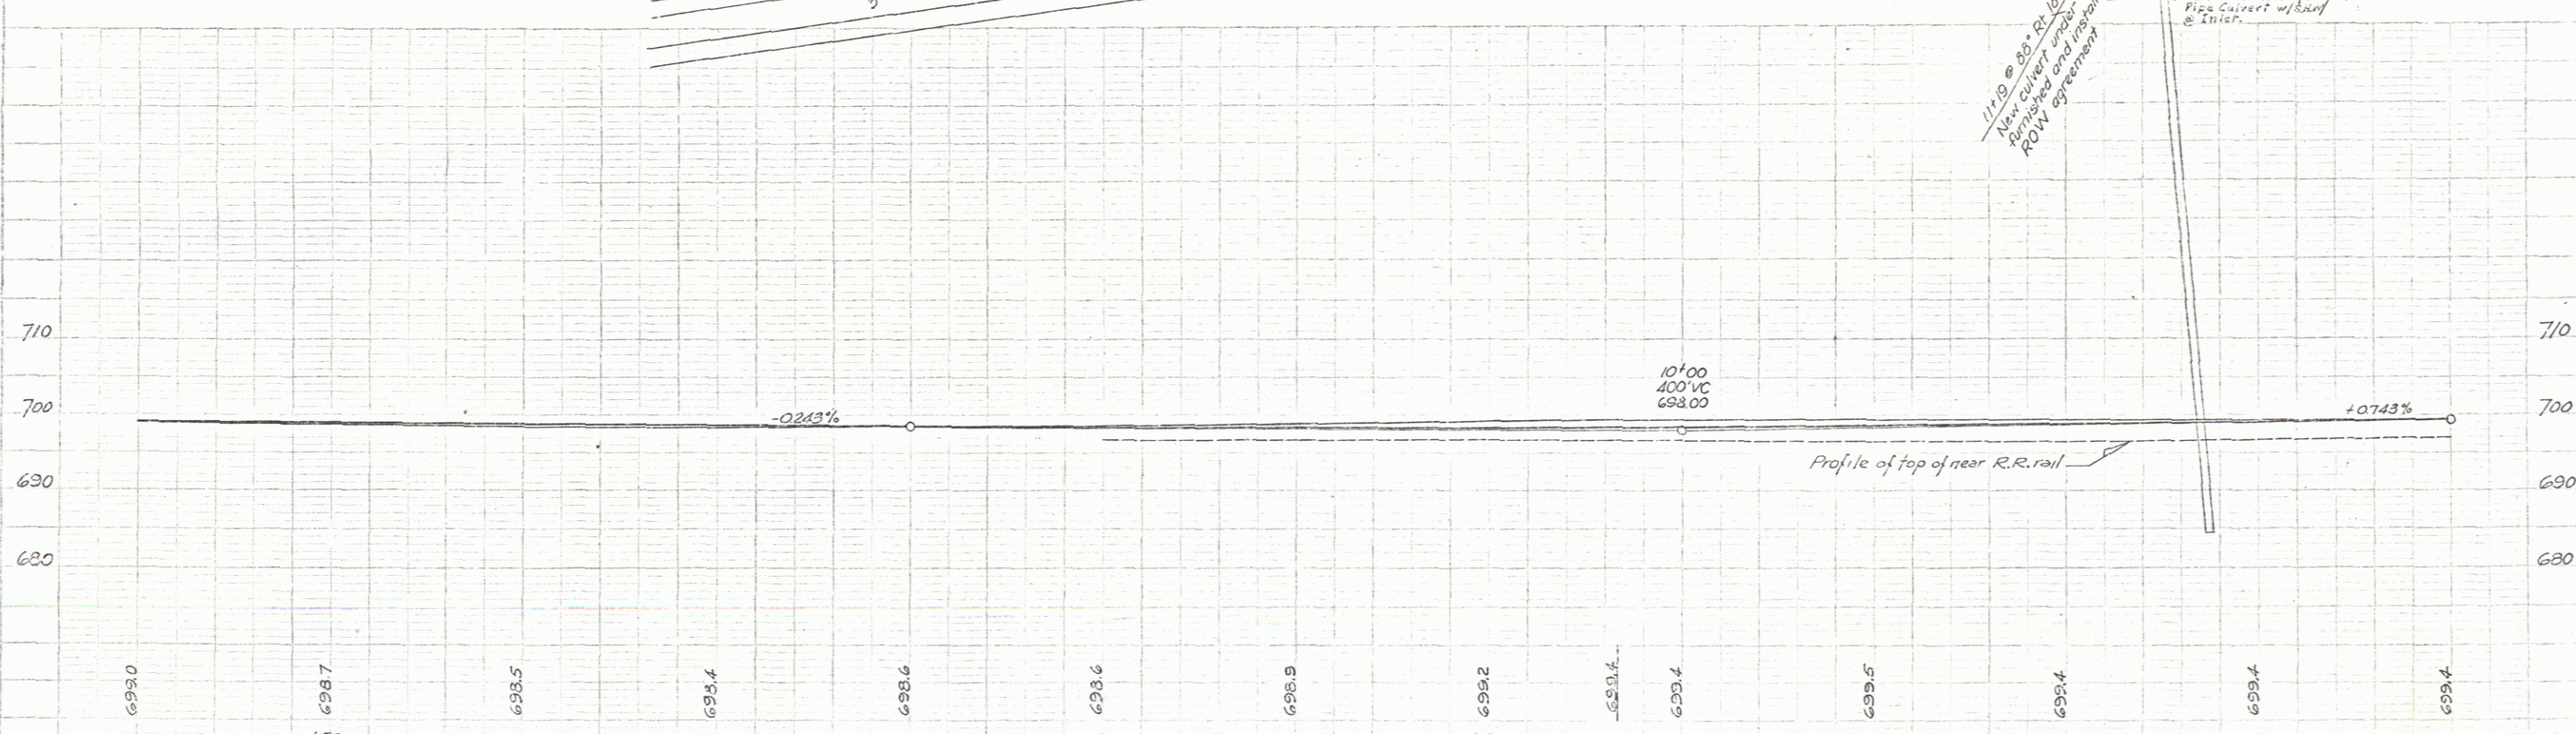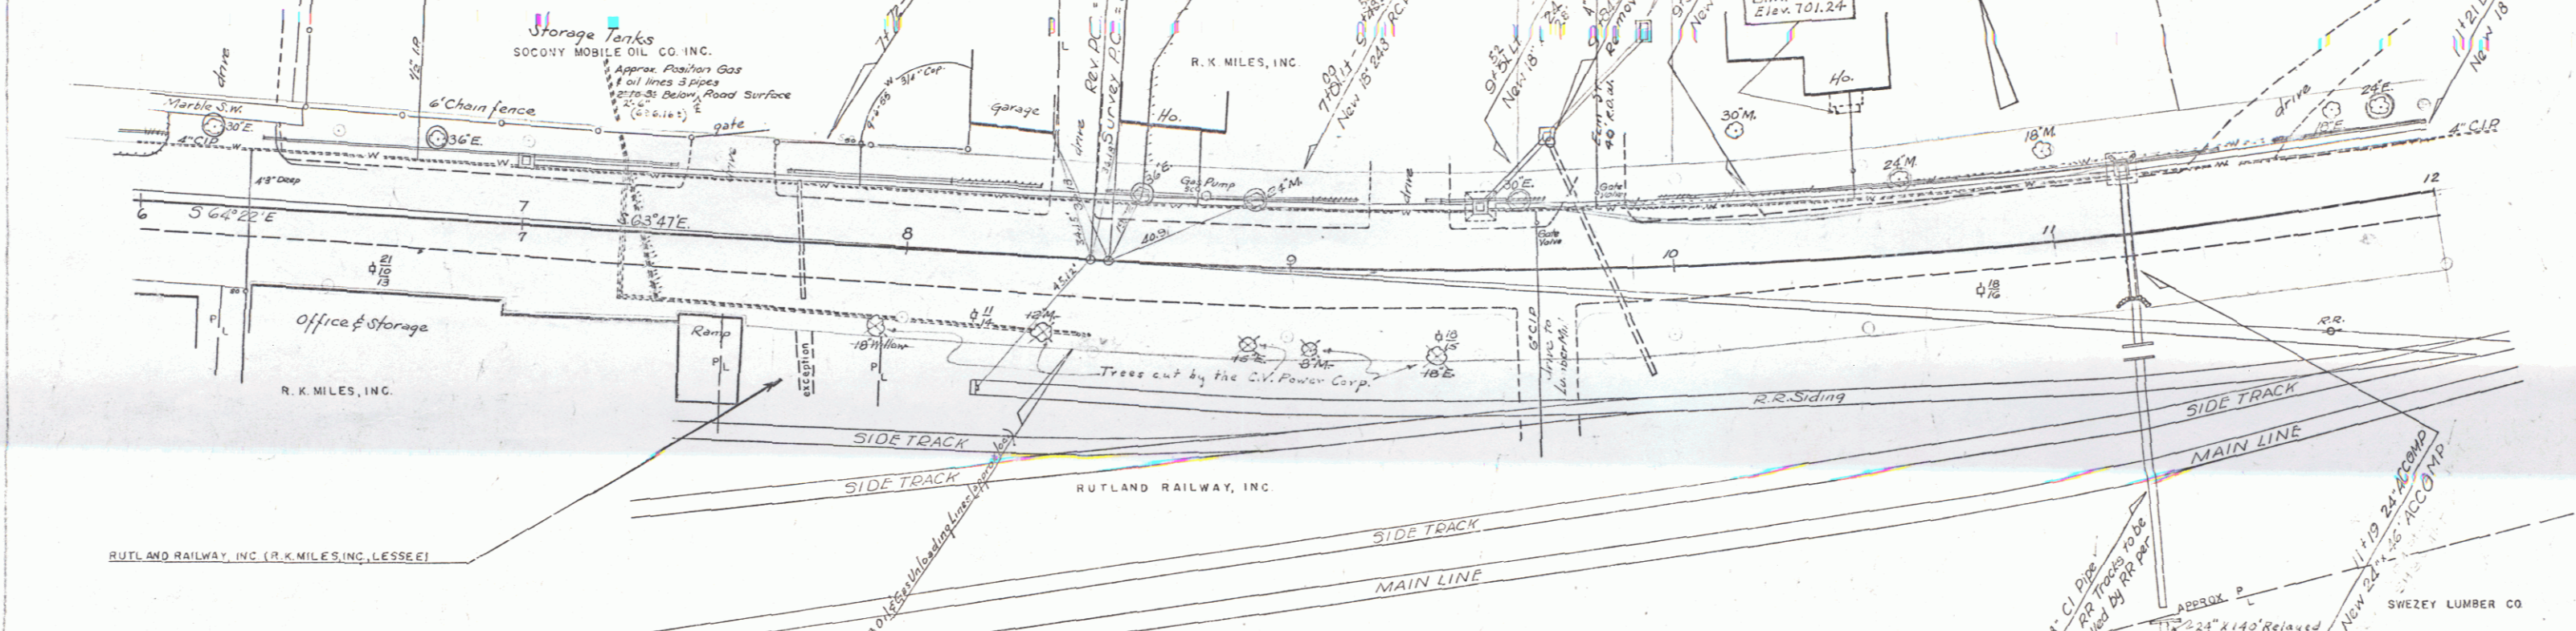

8/27 10/8

Ernell 1/70

B.M. #2 - S.W. corner Step Foundation - 37' Lt. Sta. 10+45 - Elevation 701.24
 MANCHESTER Project No. 3755(S) Sheet No. 17 of 36

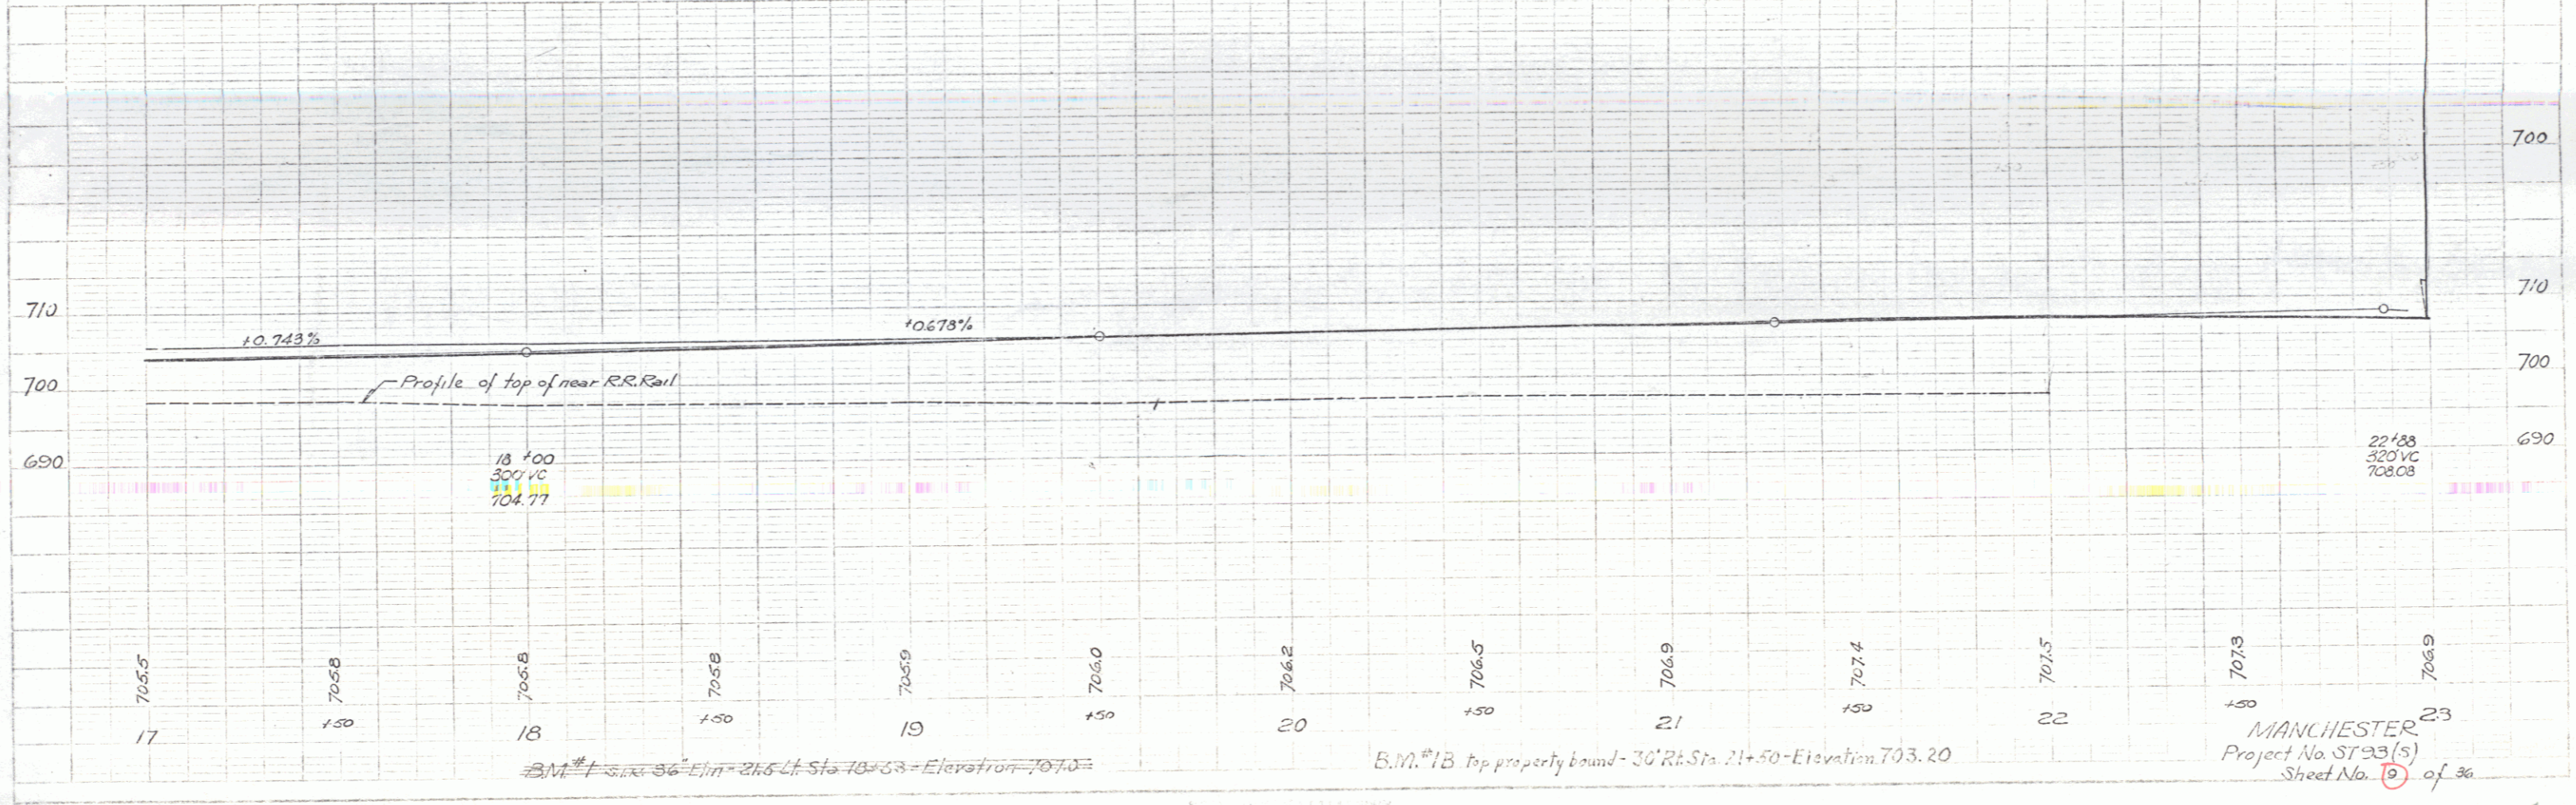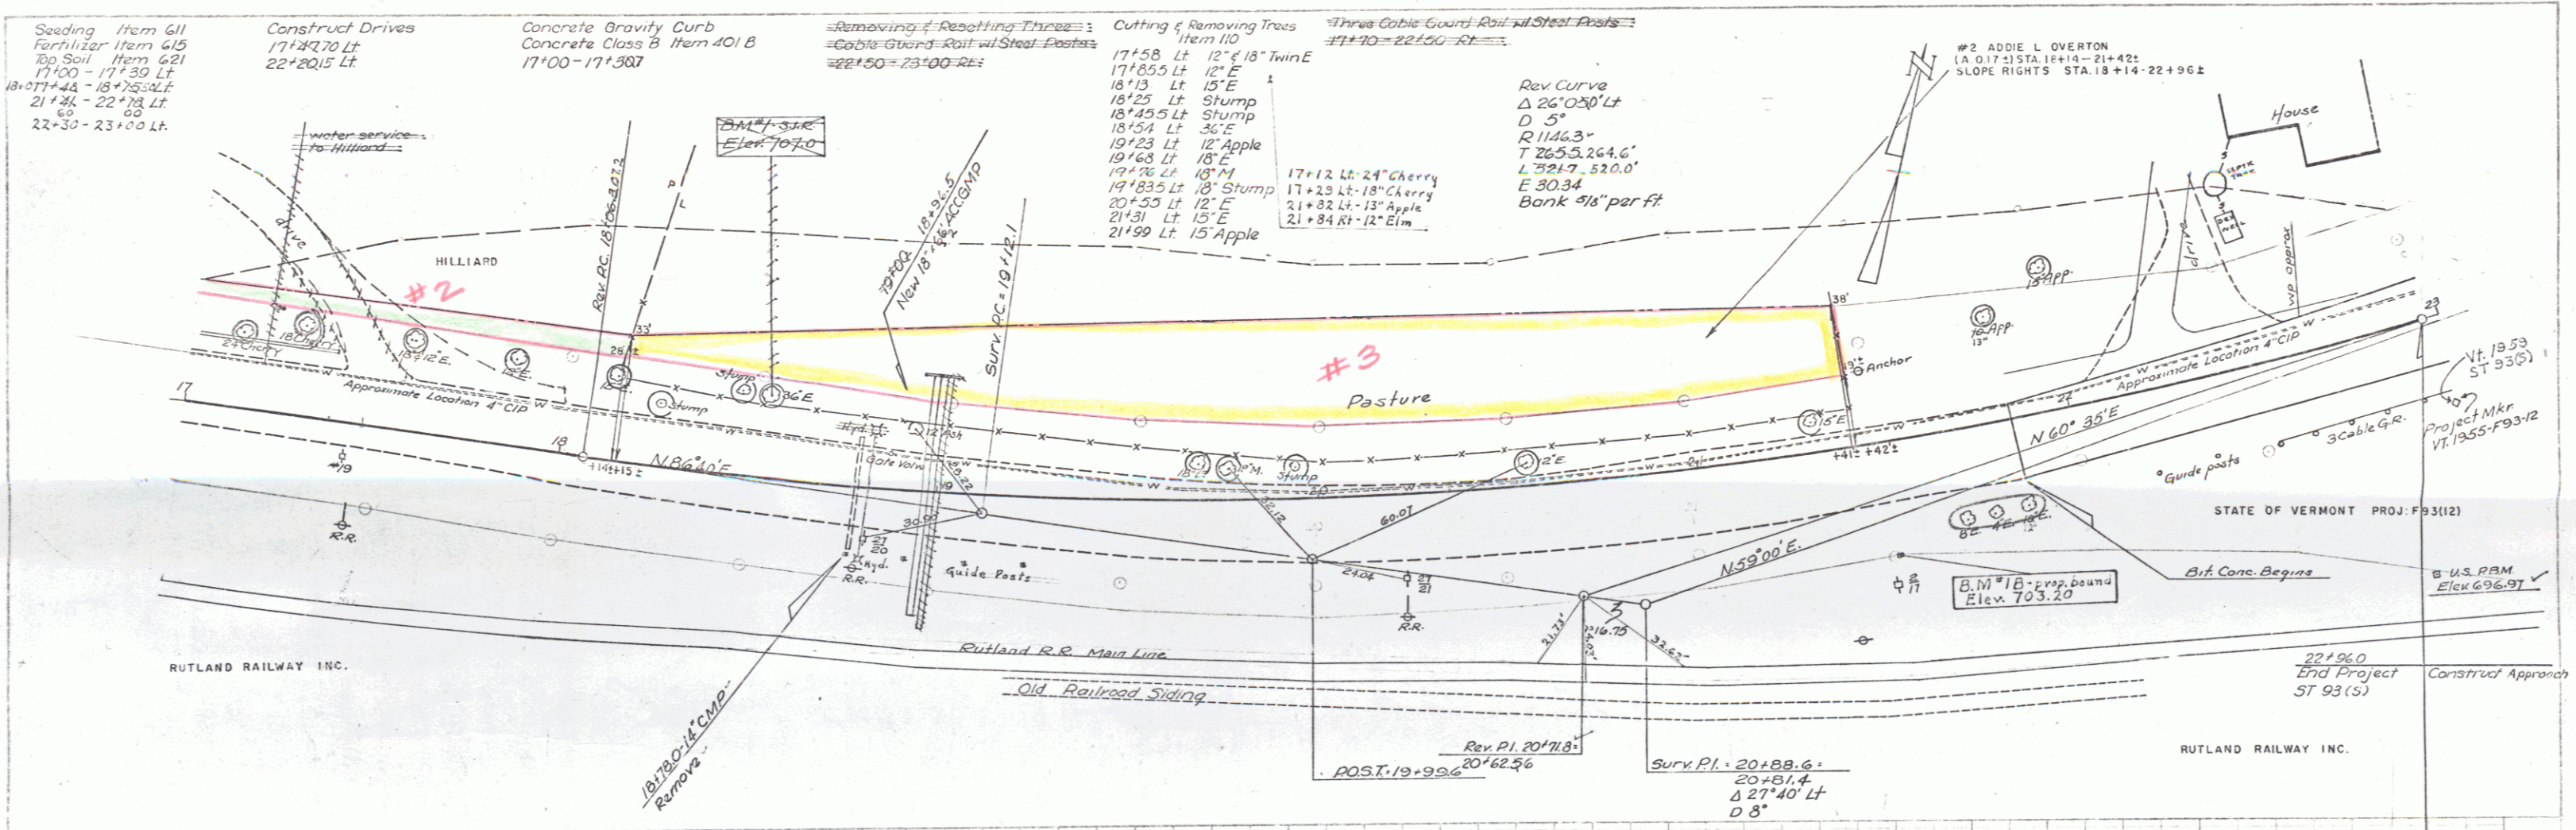

Seeding Item 611
Fertilizer Item 615
Top Soil Item 621
17+00 - 17+30 Lt
18+17+44 - 18+25.32 Lt
21+34 - 22+78 Lt
22+30 - 23+00 Lt

Construct Drives
17+32.70 Lt
22+20.15 Lt

Concrete Gravity Curb
Concrete Class B Item 401 B
17+00 - 17+387

Removing & Re-setting Three
Cable Guard Rail w/ Steel Posts
22+50 - 23+00-Rt

Cutting & Removing Trees
Item 110
17+58 Lt 12" x 18" Twin E
17+55 Lt 12" E
18+13 Lt 15" E
18+25 Lt Stump
18+45 Lt Stump
18+54 Lt 36" E
19+23 Lt 12" Apple
19+68 Lt 18" E
19+76 Lt 18" M
19+83 Lt 18" Stump
20+55 Lt 12" E
21+31 Lt 15" E
21+99 Lt 15" Apple

Three Cable Guard Rail w/ Steel Posts
17+30 - 22+50-Rt

Rev. Curve
Δ 26° 03' 0" Lt
D 5°
R 1146.3'
T 265.52646'
L 321.7 - 520.0'
E 30.34
Bank 9/8" per ft.

#2 ADDIE L. OVERTON
(A.O.I.T) STA. 18+14 - 21+42
SLOPE RIGHTS STA. 18+14 - 22+96



1/2" = 100'
1/4" = 50'
1/8" = 25'
1/16" = 12.5'

1/2" = 100'
1/4" = 50'
1/8" = 25'
1/16" = 12.5'

17 17+50 18 18+50 19 19+50 20 20+50 21 21+50 22 22+50 23

B.M. #18 top property bound - 30' Rt. Sta. 21+50 - Elevation 703.20

MANCHESTER
Project No. ST 93(S)
Sheet No. 19 of 36

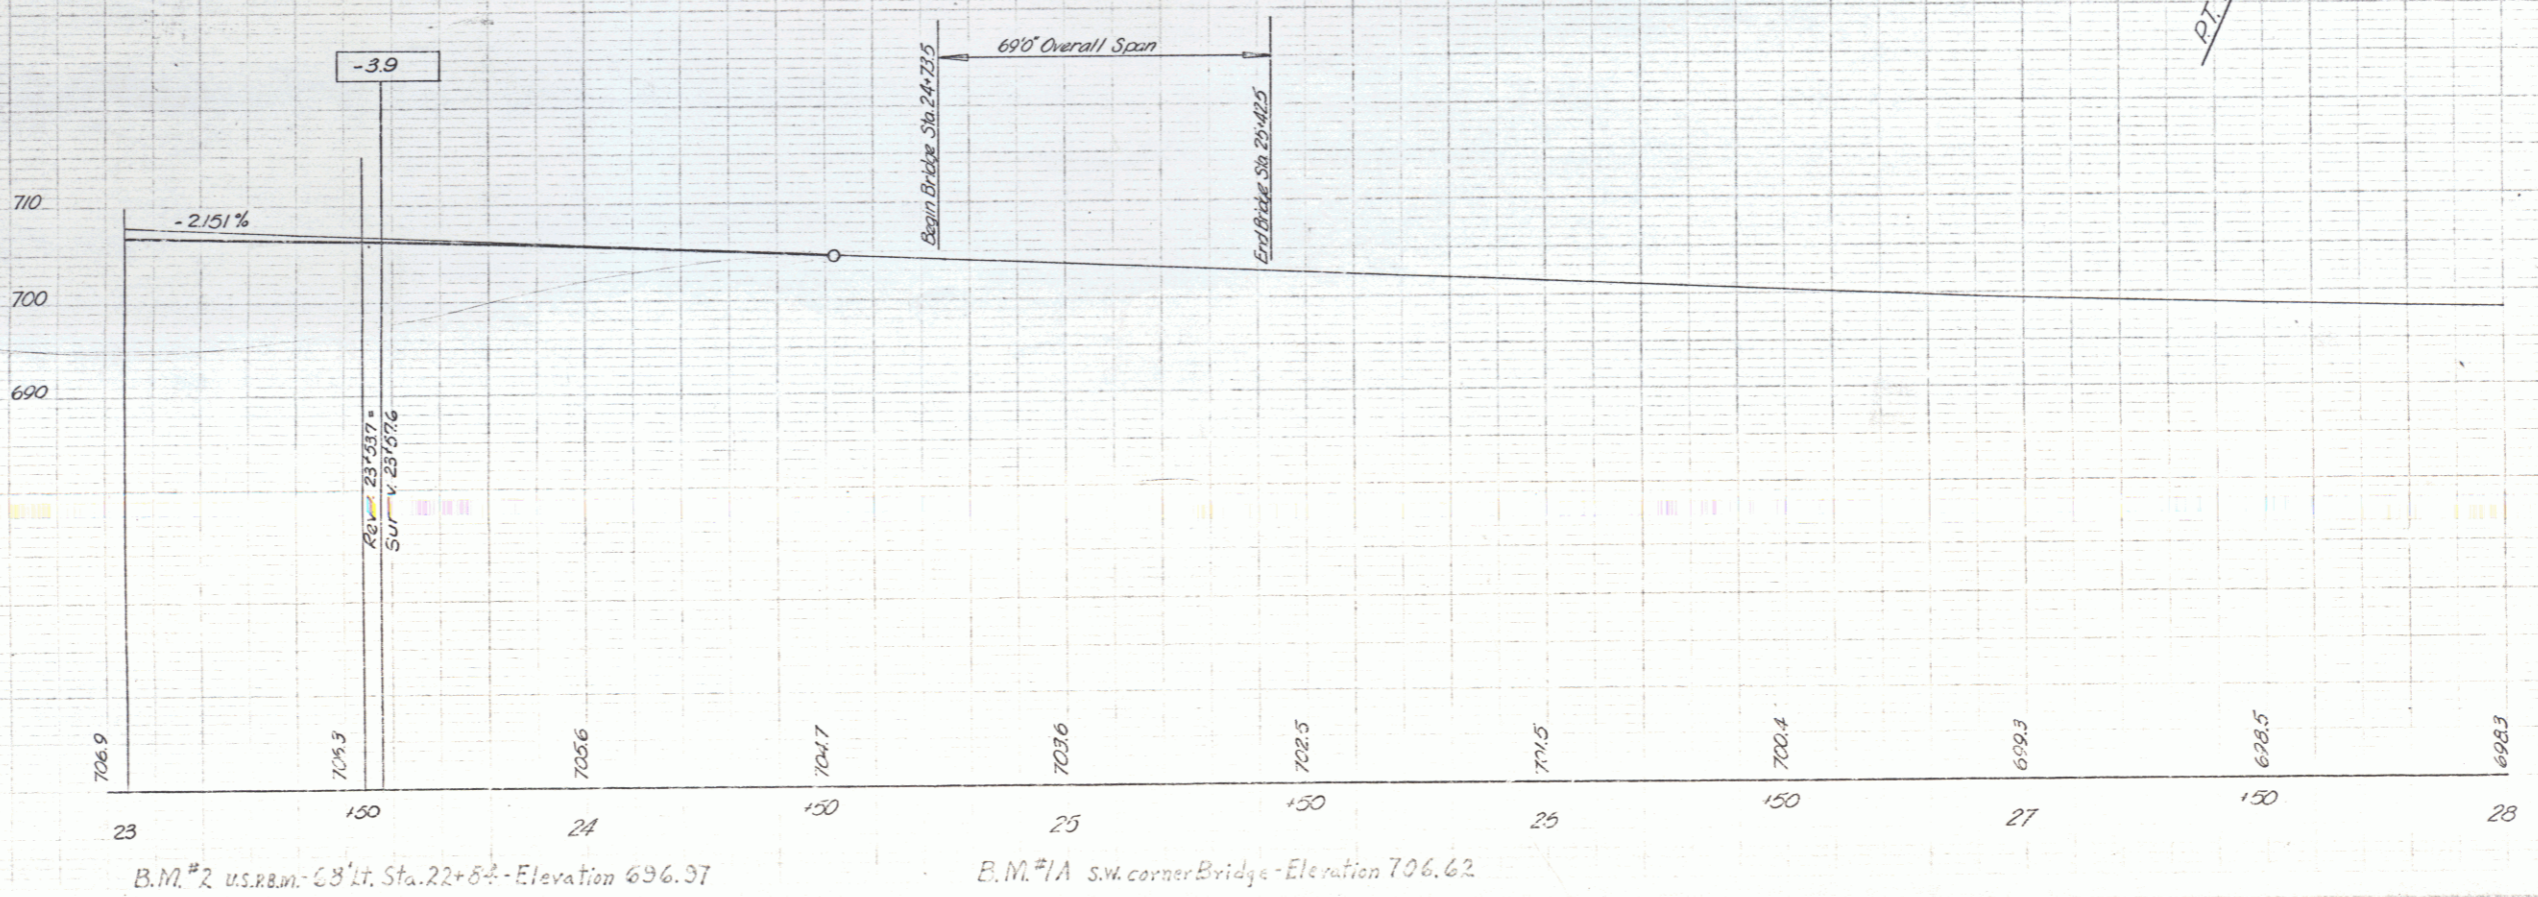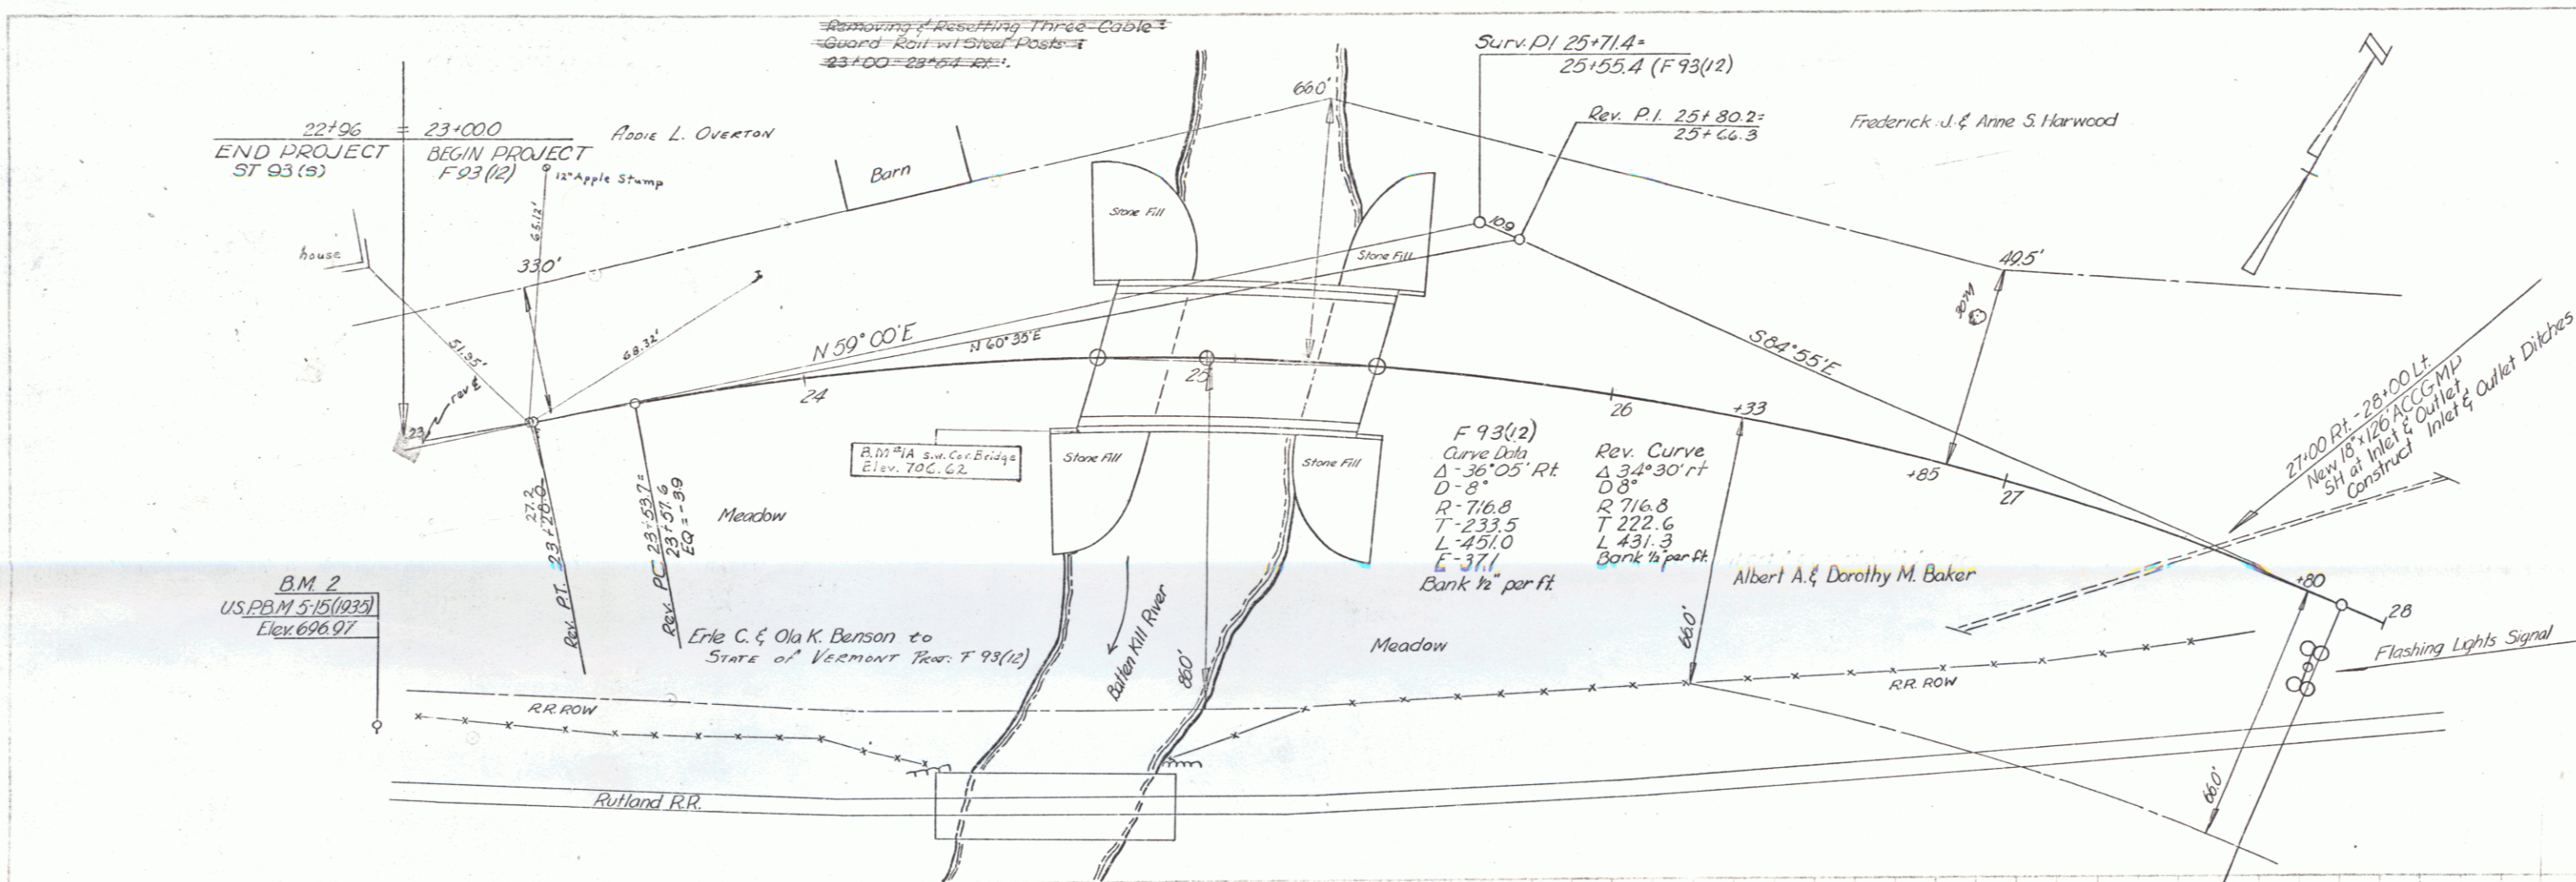

MANCHESTER
ST 93 (S)
Sheet No. 10 of 36