
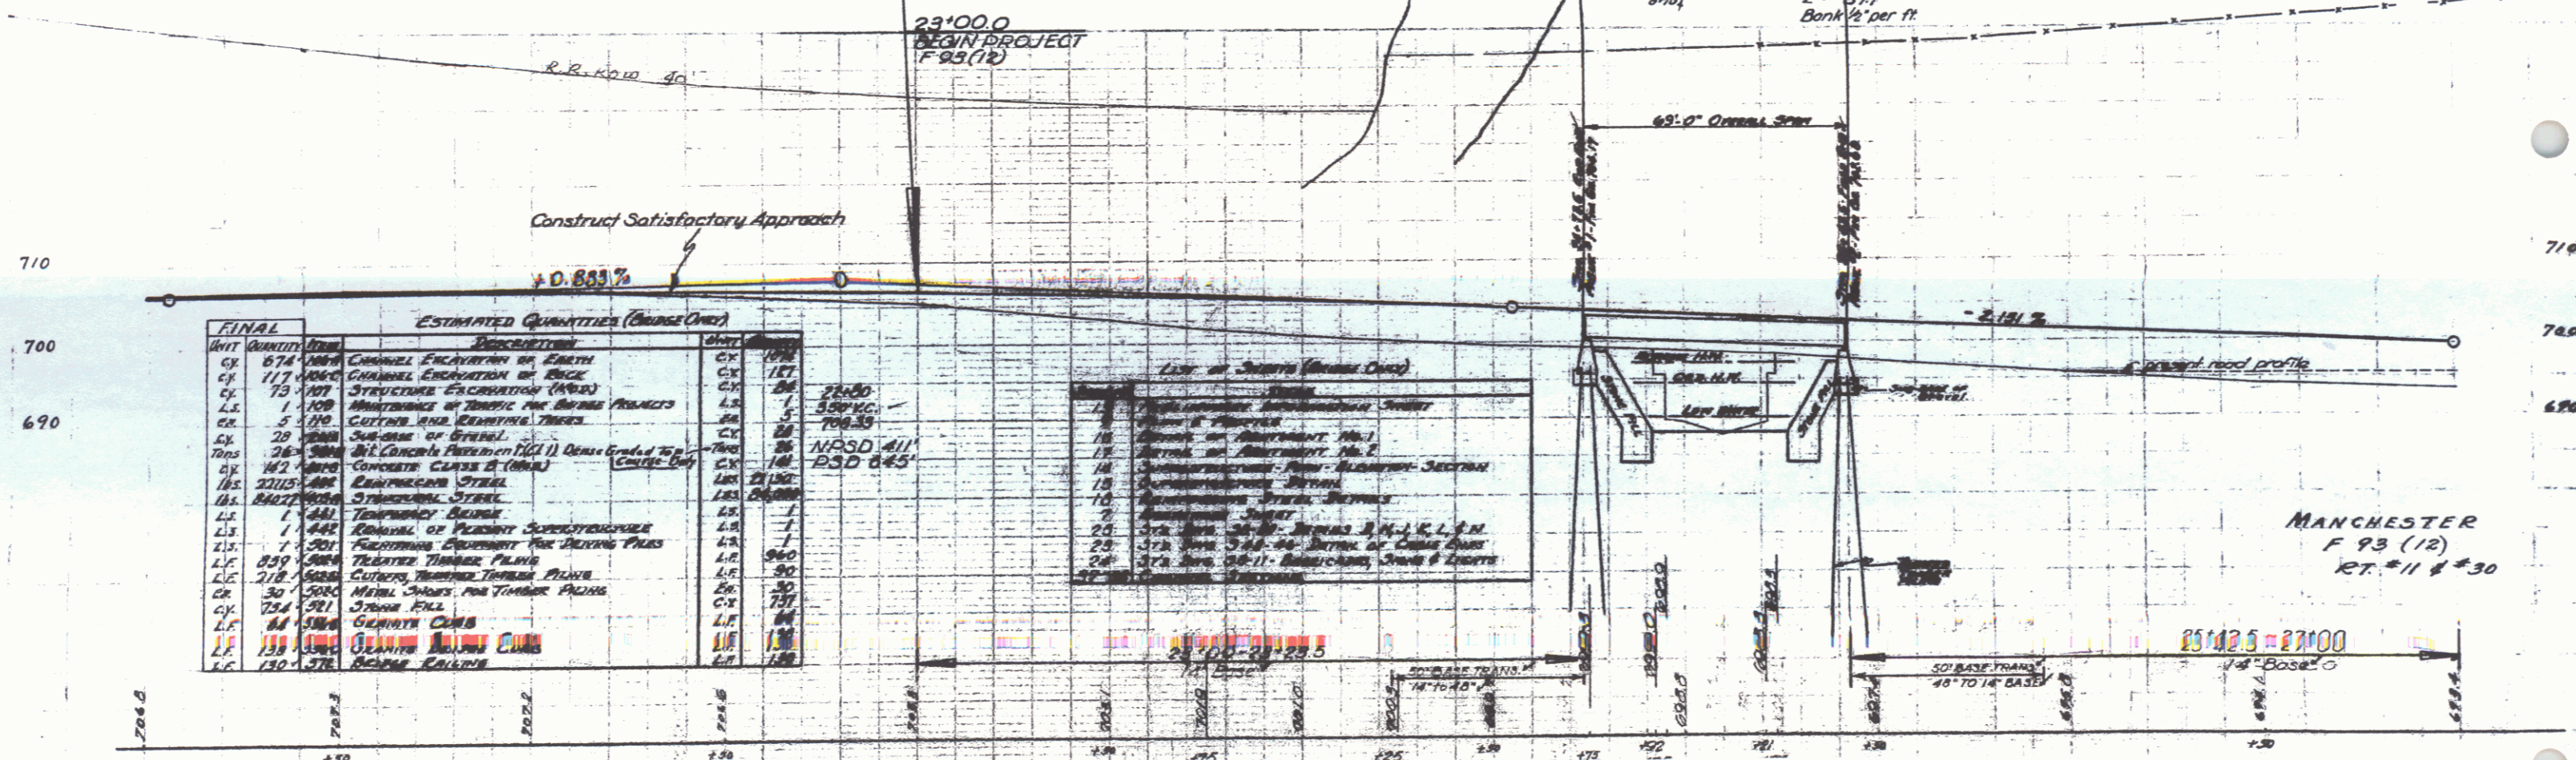


POOR ORIGINAL COPY

REMOVAL & DISPOSAL OF  
PRESENT GUARD RAIL  
24+05 to 24+92 E.T.  
24+92 to 24+99 L.T.  
25+00 to 25+10 L.T.  
25+10 to 25+104 E.T.  
24+00 to 24+80 R.T.

CONSTRUCT DRIVE  
22+50 L.V.  
23+75 L.V.

THREE CABLE GUARD RAIL  
WITH STEEL POSTS  
L.V.  
22+05-24+75 22+97-24+63  
24+54-27+00 25+49-26+55  
23+96-24+76 23+55-24+63  
25+51-27+11 23+43-26+55

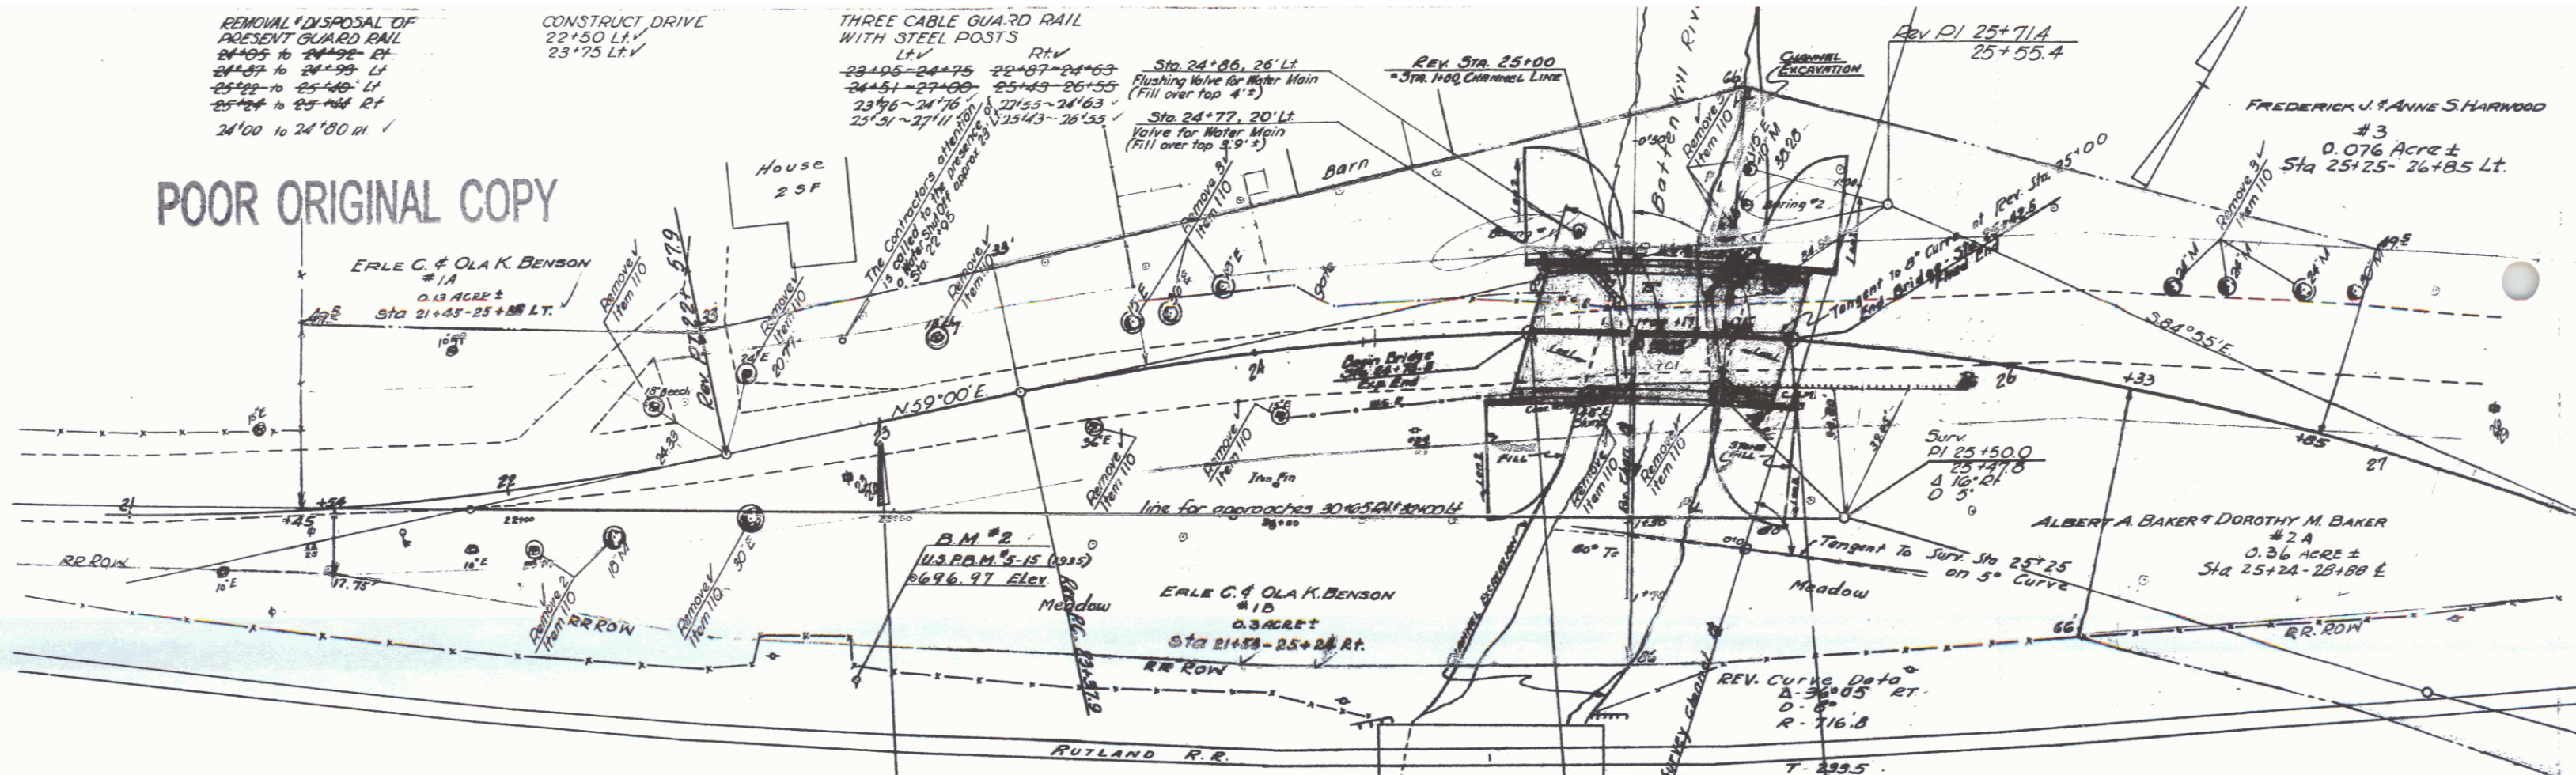

ESTIMATED QUANTITIES (Base Unit)

UNIT	QUANTITY	DESCRIPTION	UNIT	QUANTITY
EX	874	CONCRETE ENCASING ON EARTH	CY	157
EX	117	CONCRETE ENCASING ON ROCK	CY	26
EX	73	STRUCTURE ENCASING (MASS)	CY	4.5
EX	1	MAINTENANCE OF TYPING FOR BRIDGE FRAMES	HR	100.35
EX	5	CUTTING AND REMOVING TREES	CY	22
EX	29	SECTION OF BRIDGE	CY	22
TRCP	245	2 1/2" CONCRETE PAVEMENT (100%) OVER GRAVEL TOP	MSD	411
EX	142	CONCRETE CLASS B (MASS)	CY	142
MS	2215	REINFORCED CONCRETE	MSD	645
MS	2407	STRUCTURAL STEEL	MSD	645
L.F.	1	TEMPORARY BRIDGE	MSD	1
L.F.	1	REMOVAL OF EXISTING SUPERSTRUCTURE	MSD	1
L.F.	1	REMOVAL OF EXISTING SUPERSTRUCTURE	MSD	1
L.F.	7	REMOVING EXISTING PAVEMENT PLANS	MSD	1
L.F.	839	TRUCKS THROUGH PILING	L.F.	960
L.F.	218	CUTTING THROUGH PILING	L.F.	90
CR	30	METAL SHOPS FOR TIMBER PILING	CR	30
EX	224	SHOPS FOR	EX	224
L.F.	84	SHOPS FOR	L.F.	84
L.F.	133	SHOPS FOR	L.F.	133
L.F.	130	SHOPS FOR	L.F.	130

LIST OF SUPPLIES (Base Unit)

1	1/2" CONCRETE PAVEMENT (100%) OVER GRAVEL TOP	MSD	411
1	CONCRETE CLASS B (MASS)	CY	142
1	STRUCTURAL STEEL	MSD	645
1	TEMPORARY BRIDGE	MSD	1
1	REMOVAL OF EXISTING SUPERSTRUCTURE	MSD	1
1	REMOVING EXISTING PAVEMENT PLANS	MSD	1
1	TRUCKS THROUGH PILING	L.F.	960
1	CUTTING THROUGH PILING	L.F.	90
1	METAL SHOPS FOR TIMBER PILING	CR	30
1	SHOPS FOR	EX	224
1	SHOPS FOR	L.F.	84
1	SHOPS FOR	L.F.	133
1	SHOPS FOR	L.F.	130

MANCHESTER  
F 93 (12)  
RT. #11 & #30