

INDEX OF SHEETS

SHEET NO. 1	TITLE PAGE
2-3	TYPICAL CROSS-SECTION OF IMPROVEMENT
4	BANKING AND WIDENING TABLES
5-10	PLAN AND PROFILE
11	STANDARD STRUCTURE SH. 5-28 - PIPE CULVERTS
12	5-30 - GUARD RAIL
12A	5-30A - STD. UNDERDRAIN, FED. AID MARKERS
13	5-31 - DROP INLETS
14	5-40 - BARRICADES, SIGNS & LIGHTS
15	5-41 - ROUNDING OF SLOPES
16-40	CROSS SECTIONS

STANDARD STRUCTURE SHEETS
 APPROVED BY THE CHIEF ENGINEER
 5-28 - JULY 11, 1933
 5-30 - AUG. 15, 1934
 5-31 - JULY 25, 1934

STATE OF VERMONT
 STATE HIGHWAY DEPARTMENT

PLAN AND PROFILE OF PROPOSED
 STATE HIGHWAY

FEDERAL AID PROJECT

TOWN OF MANCHESTER


Pin # 99R889

MANCHESTER-PERU ROAD

BEGINNING AT A POINT 375 FT. WEST OF THE
 MANCHESTER-WINHALL TOWN LINE AND EXTENDING
 SOUTH-WESTERLY 1.325 MI.

LENGTH OF PROJECT = 7000.0 FT. = 1.325 MILES


FED. ROAD DIST. NO.	STATE	FED. AID PROJ. NO.	SPECIAL PROJ. NO.	TOTAL SHEETS
9	VT.	99R889	1	27

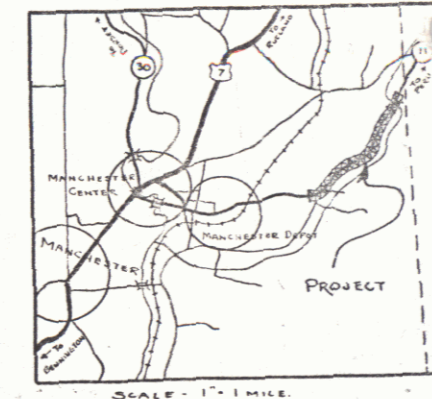

(To Be Returned To R.O.W. Division)
 TOWN OF
 PERU
 MANCHESTER
 HIGHWAY DEPARTMENT

RECORD PLANS
 By A.C. Birnie 5/1/44

Rt. VT 11

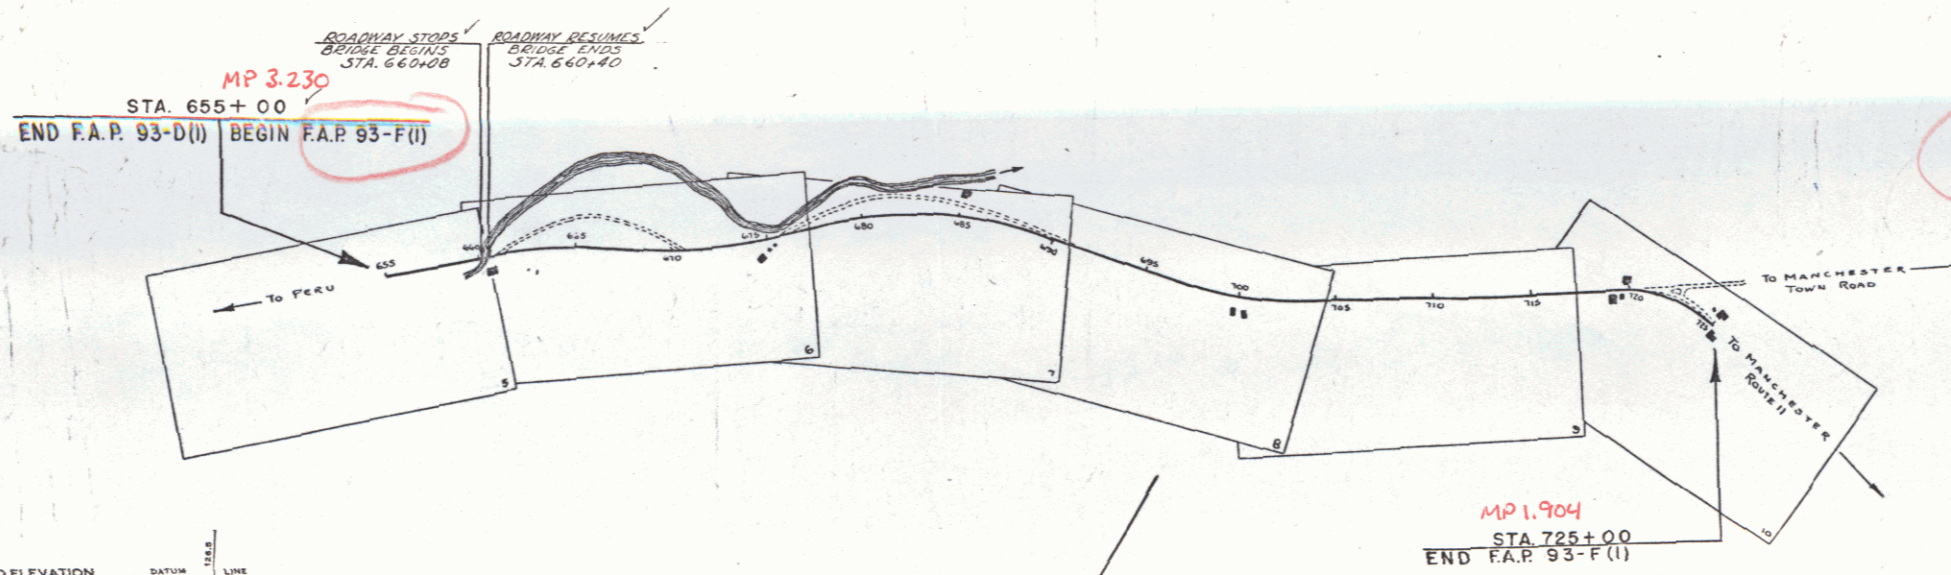

- COUNTY LINE
- TOWN LINE
- FENCE LINE
- STONE WALL
- UNFENCED PROPERTY
- GUARD RAIL
- TRAVELED WAY
- RAILROAD
- RETAINING WALL
- CENTER LINE
- SURVEY LINE
- CULVERT
- DROP INLET
- TROLLEY POLE
- POWER POLE
- TELEPHONE POLE
- TREES
- HEDGE

- GROUND ELEVATION
- GRADE ELEVATION
- CURVE DATA
- DEFLECTION ANGLE
- DEGREE OF CURVE
- RADIUS OF CURVE
- TANGENT DISTANCE
- LENGTH OF CURVE
- EXTERNAL DISTANCE
- POINT OF INTERSECTION
- POINT OF CURVE
- POINT OF TANGENT
- POINT ON TANGENT

SCALES

TITLE	1" = 500'
TYPICAL	1" = 2'
PLAN	1" = 50'
PROFILE HORIZONTAL	1" = 50'
PROFILE VERTICAL	1" = 10'
CROSS SECTIONS	1" = 5'

THESE PLANS ARE SUBJECT TO SUCH REVISIONS AS MAY BE REQUIRED BY THE PUBLIC ROADS ADMINISTRATION OR THE COMMISSIONER OF HIGHWAYS.
 CONSTRUCTION IS TO BE CARRIED ON IN ACCORDANCE WITH THE PLANS AND THE STANDARD ROAD AND BRIDGE SPECIFICATIONS OF 1936, AS APPROVED DECEMBER 29TH, 1936 BY THE PUBLIC ROADS ADMINISTRATION, INCLUDING ALL SUBSEQUENT APPROVED REVISIONS AND SUCH REVISED SPECIFICATIONS AND SPECIAL PROVISIONS AS ARE SUBMITTED WITH THE PLANS.

APPROVED: *H. J. Sargent*
 COMMISSIONER OF HIGHWAYS
 SUBMITTED BY ORDER OF THE STATE HIGHWAY BOARD

RECOMMENDED FOR APPROVAL
 DISTRICT ENGINEER
 PUBLIC ROADS ADMINISTRATION
 FEDERAL WORKS AGENCY

APPROVED
 DISTRICT ENGINEER
 PUBLIC ROADS ADMINISTRATION
 FEDERAL WORKS AGENCY

APPROVED *A. C. Birnie* ROAD ENGINEER
 APPROVED *H. J. Sargent* DISTRICT HIGHWAY COMMISSIONER
 SERIES F.A.P. NO. 99R889 FILED
 SHEET 1 OF 27

DIST. # 11 PLANS