


PARCEL INSTRUMENT	DATE	GRANTOR	GRANTEE	RECORDED	REMARKS
A	W.D. 10-31-39	HUGH SMITH	ST. OF VT.	BOOK 103 PAGE 114-39	2 CULV.
A'	W.D. 10-31-39	FRED E. L. HERVIE HILL	ST. OF VT.	40 176 11-14-39	
B	W.D. 8-30-39	THOMAS E. L. BURTRICE & SMITH	ST. OF VT.	40 115 9-28-39	1 CULV.

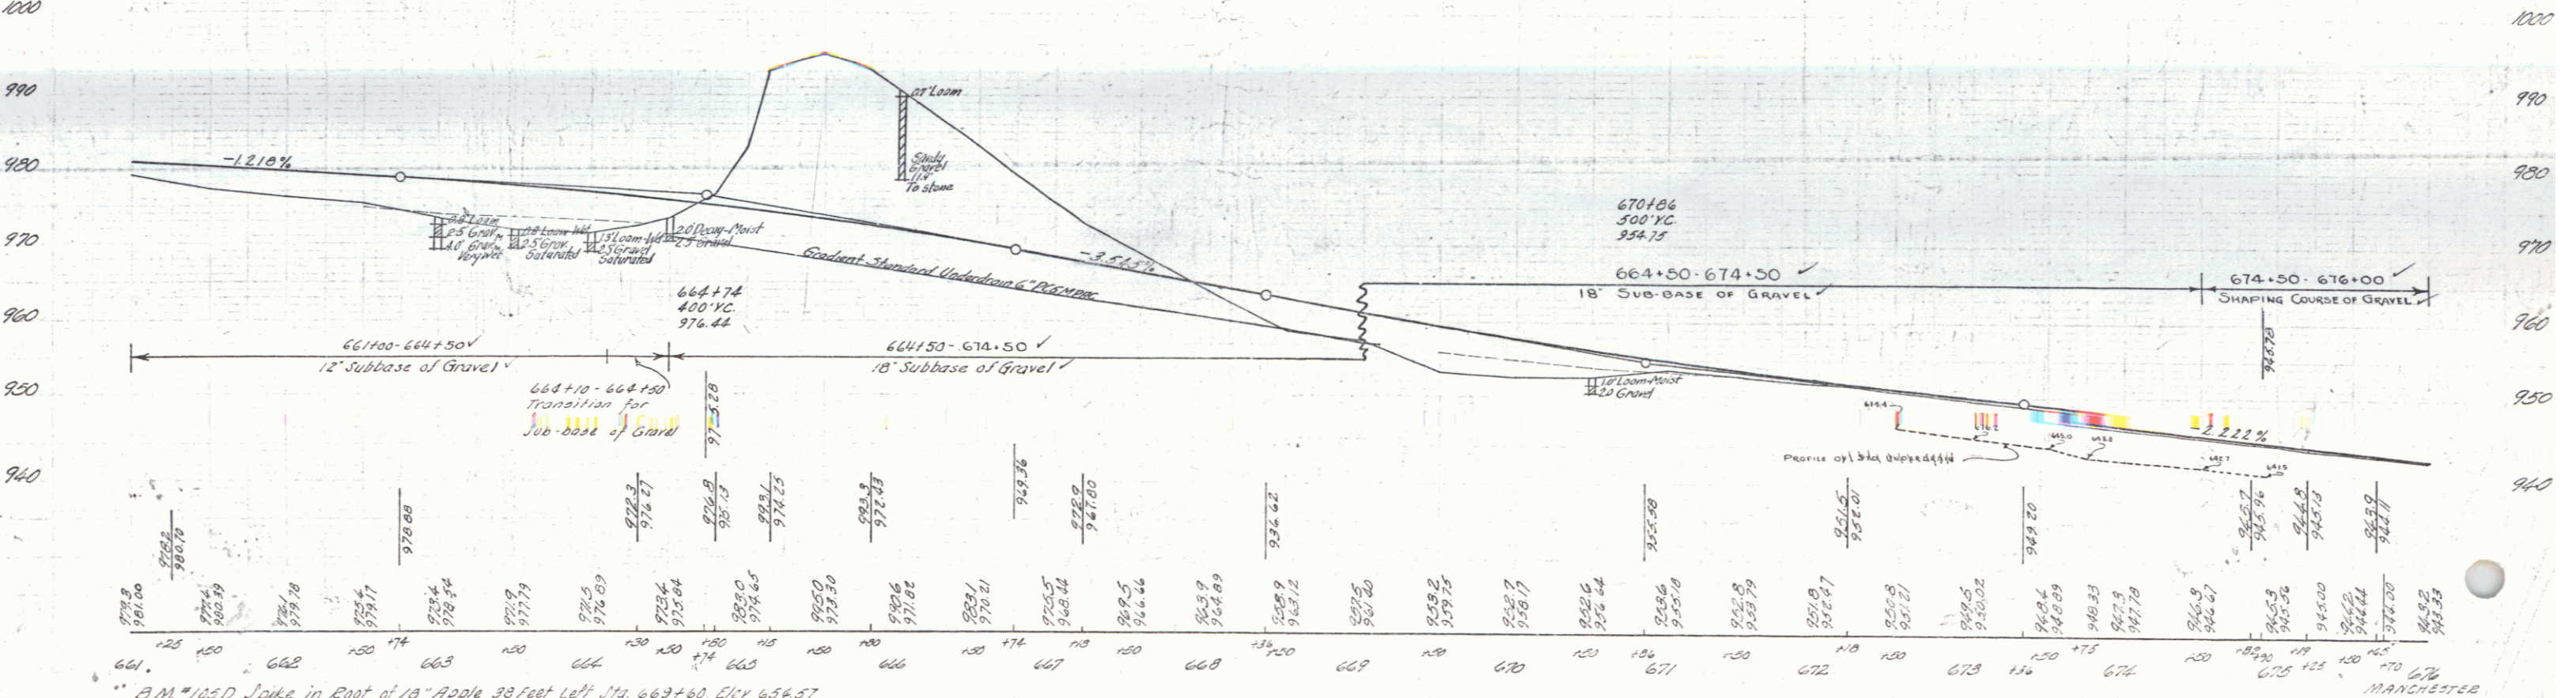

B.M. #105D Spike in Root of 18" Apple 38 feet left Sta. 669+60 Elev. 654.57

MANCHESTER
SHEET 1 OF 2 SHEETS