


PARCEL	INSTRUMENT	DATE	GRANTOR	GRANTEE	RECORDED	REMARKS
B	VD	10-31-39	HUGH SMITH	ST OF VT	8025	2005
B'	VD	10-31-39	FRED E & HERVIE W HILL	ST OF VT	40	176
A	VD	10-31-39	CHRISTOPHER MANN SWEEZY	ST OF VT	40	168
A'	VD	10-31-39	CHRISTOPHER SWEEZY D	ST OF VT	40	173

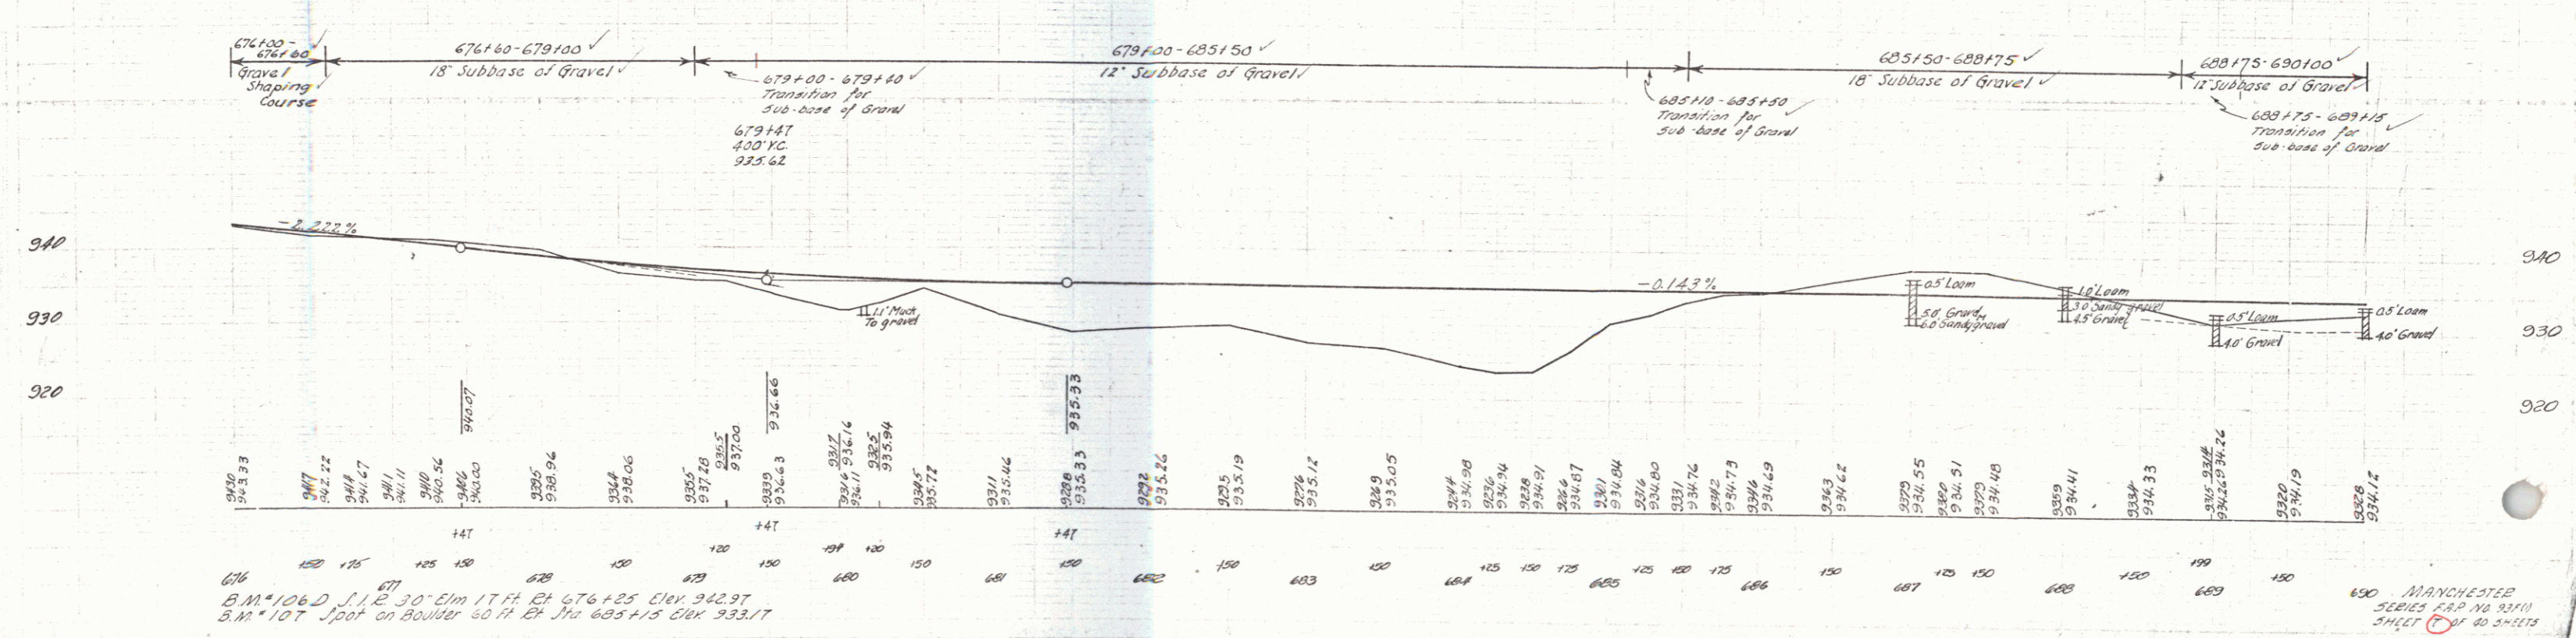

B.M. 106 D 11.2 30' Elm 17 ft Bl 676+25 Elev 942.97
 B.M. 107 100' on Boulder 50 ft Bl 685+15 Elev 933.17

MANCHESTER
 SERIES MAP NO 9310
 SHEET 7 OF 40 SHEETS