


PARCEL	INTRUMENT	DATE	GRANTOR	GRANTEE	RECORDED MANCHETTER	REMARK
B	V.D.	10-31-39	CHRISTOPHER SWEZEY Sr.	ST OF VT	BOOK PAGE DATE	PI 700-109
C	W.D.	10-31-39	FRED L HERVIEW HILL	ST OF VT	40 175 11-10-39	
A	Q.C.D.	3-18-40	MYRON JONES	ST OF VT	40 337 4-25-40	700-158
B'	Q.C.D.	3-18-40	STELLA EKE	ST OF VT	40 324 4-25-40	

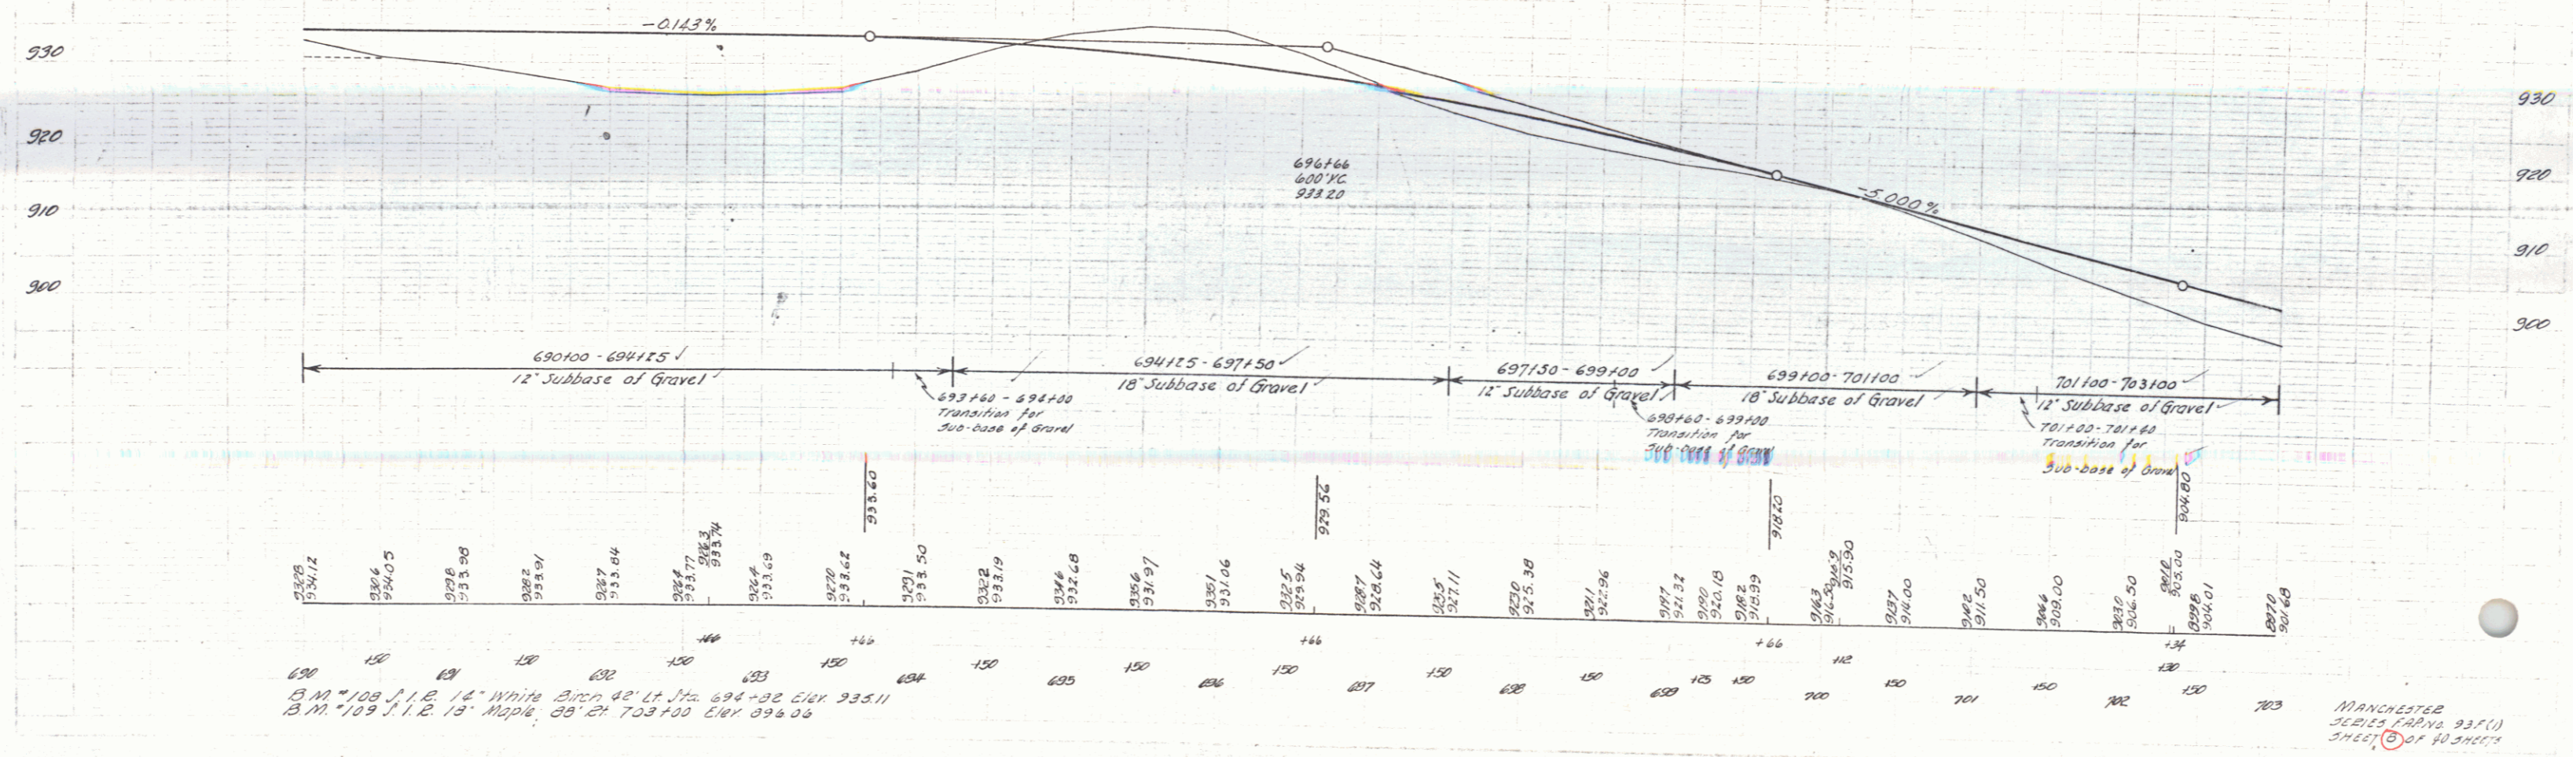

B.M. 109 J. R. 14" White Birch 42' Lt. Sta. 694+32 Elev. 935.11
 B.M. 109 J. R. 13" Maple 38' Rt. Sta. 703+00 Elev. 926.06

MANCHESTER
 24215 PARING 935(1)
 SHEET 0 OF 40 SHEETS