



PARCEL	INSTRUMENT	DATE	GRANTOR	GRANTEE	RECORDED	REMARKS
A	VD	8-30-39	THOMAS E. L. BERTRICE SMITH	ST. OF VT.	MANCHESTER BOOK PAGE 818E 173 3-25-39	


93DU 1940 2 41

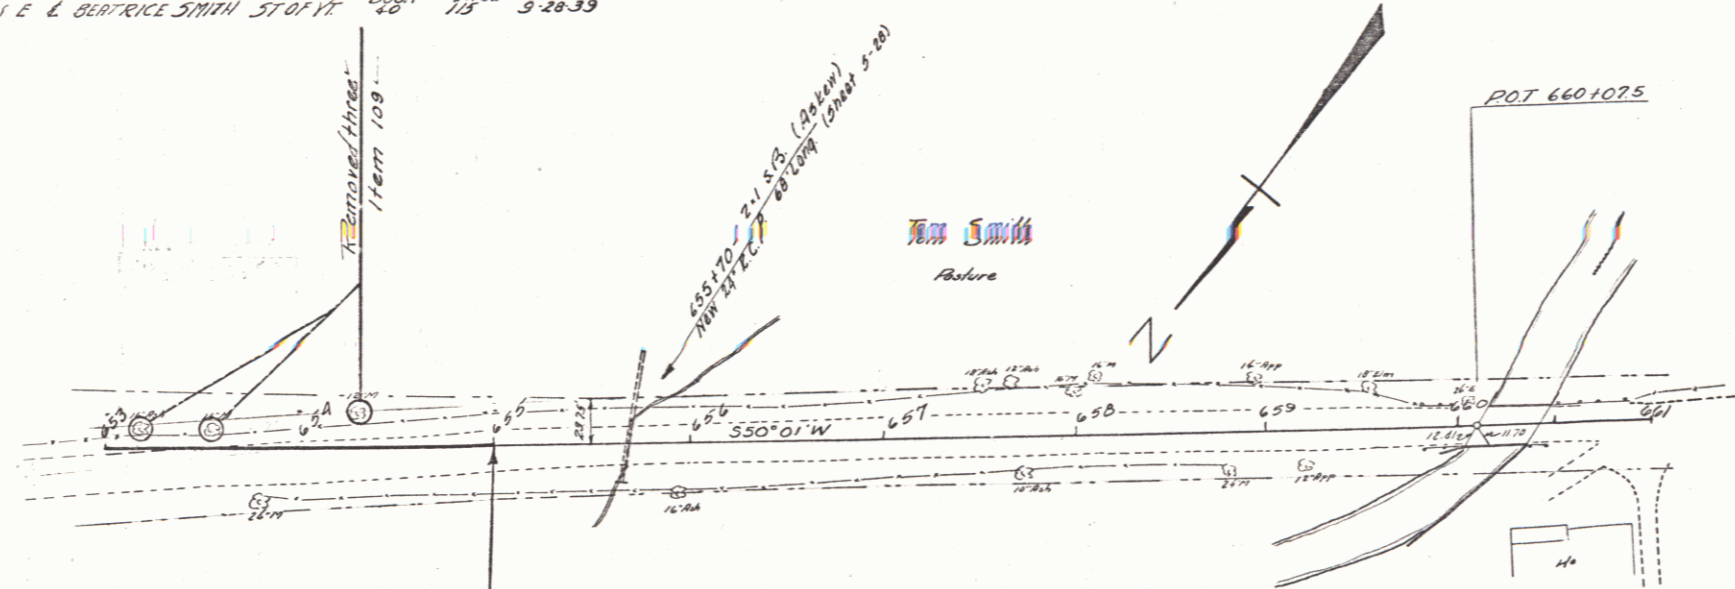

Sta. 655+00  
END OF PROJECT F&P 93DU  
10' Marker Constructed  
Sta 655+00.00

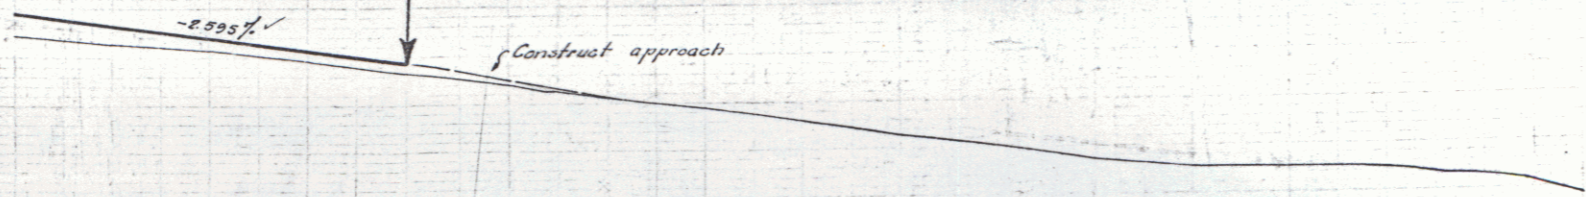

Sta 653+00  
Sta 653+00  
Sta 653+00 - Sta 653+00  
Asisting Course of Gravel  
10' 500' 1000' of 3000'

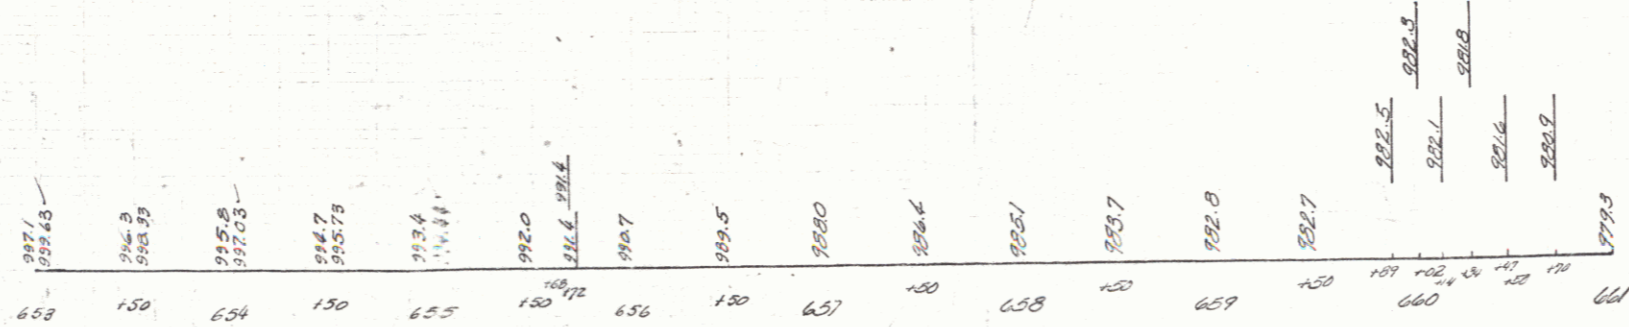

SERIES F&P 93DU  
SHEET 2 OF 2

5