

INDEX OF SHEETS

SHEET NO. 1	TITLE PAGE
2	TYPICAL CROSS-SECTION OF IMPROVEMENT (2 1/2" CRUSHED GRAVEL MIXED-IN-PLACE SURFACE COURSE) (WITH CUT-BACK ASPHALT & PRIME COAT OF REFINED TAR)
3	BANKING AND WIDENING TABLES (ITEMS 26, 30, 31)
4-9	PLAN AND PROFILE STA.
10-11	DETAILS: 10' x 10' REINFORCED CONCRETE BOX CULVERT
12	STANDARD STRUCTURE SHEET S 28: PIPE CULVERTS
13	S 30: GUARD RAIL
14	S 30 A: F.A. & BOUNDARY MARKERS, UNDERDRAIN
15	S 40: BARRICADES, SIGNS & LIGHTS
16	S 41: TYPICAL GRADING X-SECTIONS
17-41	CROSS-SECTIONS

STATE OF VERMONT
STATE HIGHWAY DEPARTMENT

PLAN AND PROFILE OF PROPOSED
STATE HIGHWAY
FEDERAL AID PROJECT

TOWNS OF WINHALL - MANCHESTER


PERU-MANCHESTER ROAD

BEGINNING ABOUT 1800 FEET EASTERLY OF INTERSECTION WITH ROAD TO BARNUMVILLE
AND EXTENDING SOUTH-WESTERLY TO A POINT 373 FEET WEST OF THE WINHALL -
MANCHESTER TOWN LINE

LENGTH OF PROJECT = 3,994.1 FT = 0.756 MI.

Standard Structure Sheets
Approved by the Chief Engineer
5-28 July 11, 1933
5-30 August 15, 1934


(To Be Returned To R.O.W. Division)
PERPETUAL
TOWN OF
E T I I H N M O J
RIGHT-OF-WAY DIVISION

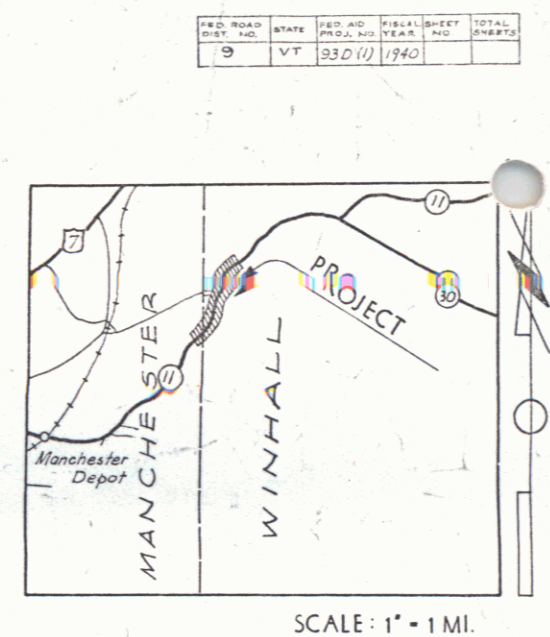

SCALE: 1" = 1 MI.

Record Plans
By
D. M. Lewis 6/11/41

RIGHT-OF-WAY DIVISION
TOWN FILE
PERPETUAL
Town of
(To Be Returned To R.O.W. Division)

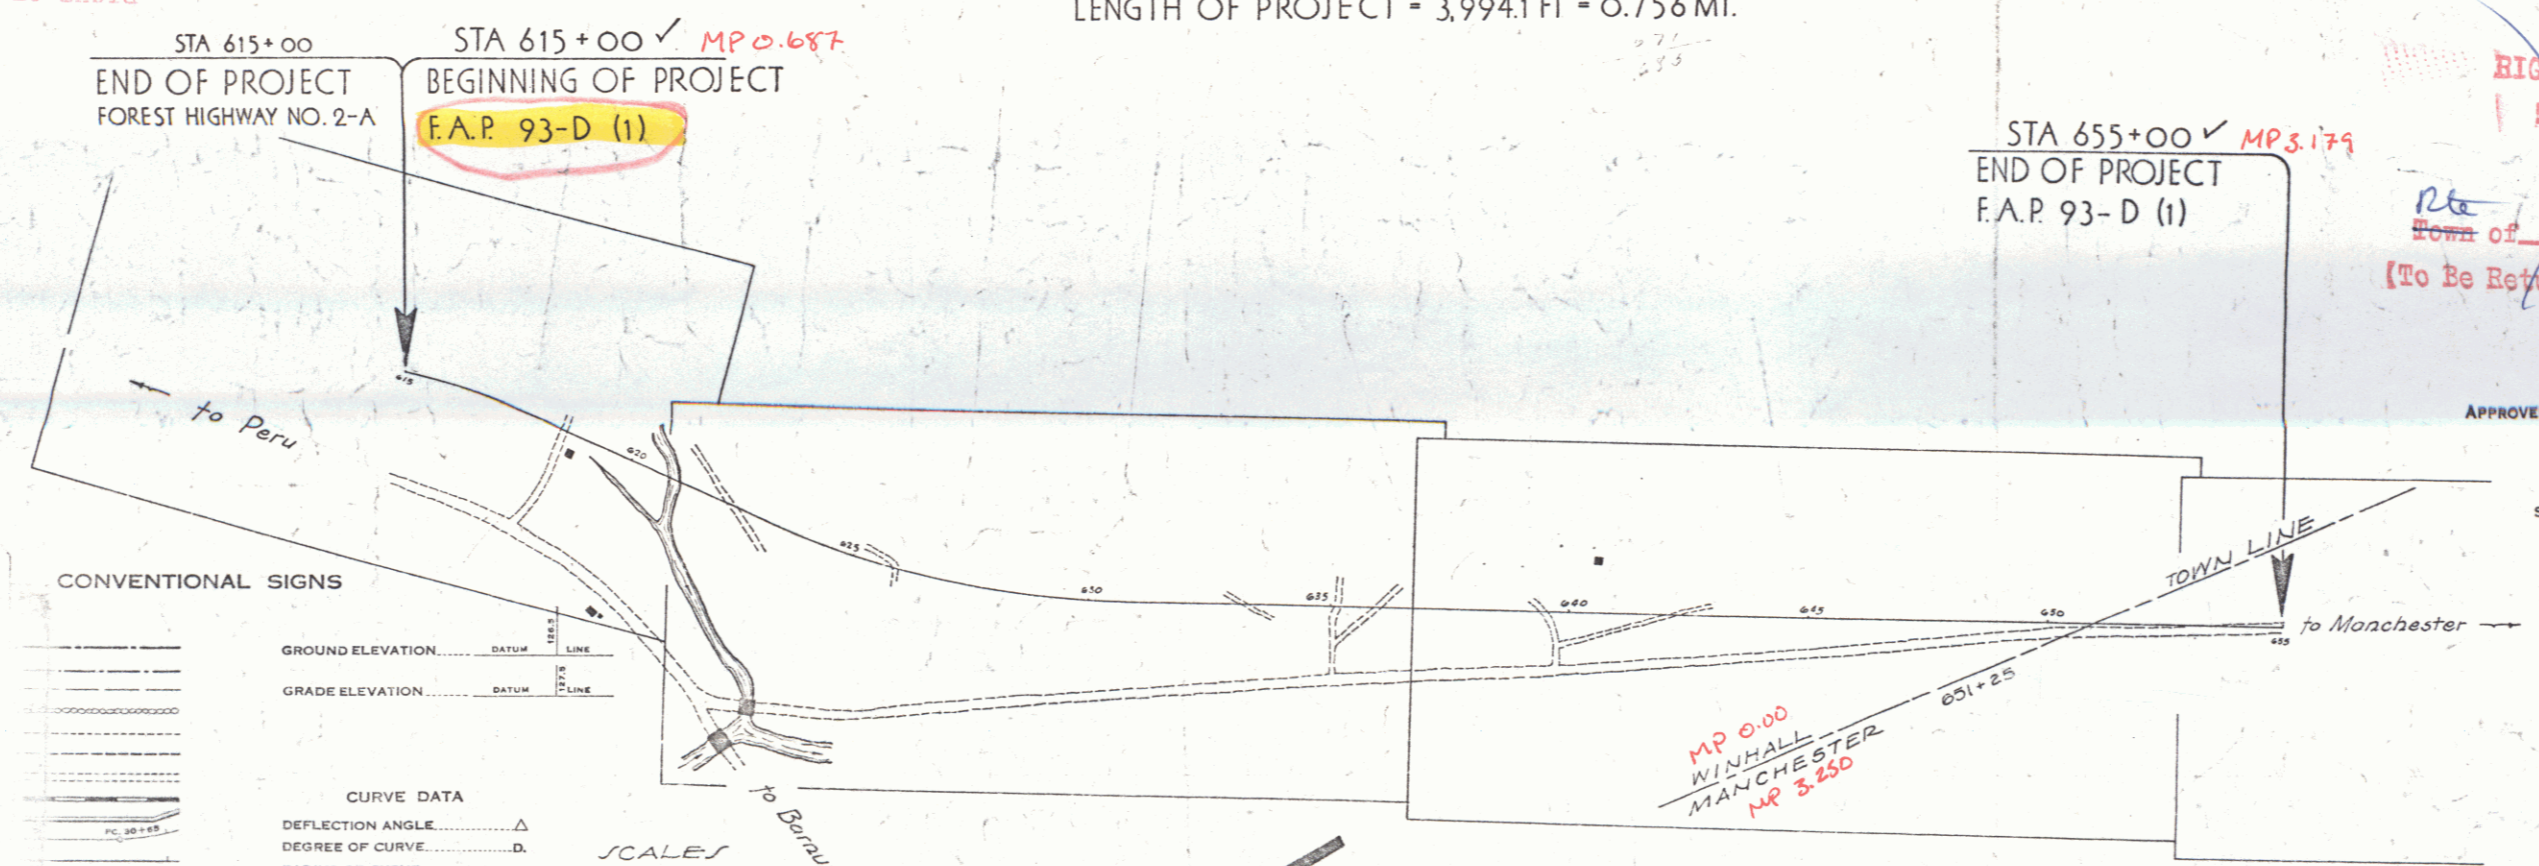

CONVENTIONAL SIGNS

GROUND ELEVATION	DATUM	LINE
GRADE ELEVATION	DATUM	LINE

CURVE DATA

DEFLECTION ANGLE	Δ
DEGREE OF CURVE	D
RADIUS OF CURVE	R
TANGENT DISTANCE	T
LENGTH OF CURVE	L
EXTERNAL DISTANCE	E
POINT OF INTERSECTION	P. I.
POINT OF CURVE	P. C.
POINT OF TANGENT	P. T.
POINT ON TANGENT	P. O. T.

SCALES
TITLE: 1" = 200'
TYPICAL: 1" = 50'
PLAN: 1" = 50'
PROFILE: HOR. 1" = 50'
VER. 1" = 10'
CROSS-SECTIONS: 1" = 5'


APPROVED: *Albee 9/1939*
H. S. Langcut
COMMISSIONER OF HIGHWAYS
SUBMITTED BY ORDER OF THE STATE HIGHWAY BOARD

RECOMMENDED FOR APPROVAL
DISTRICT HIGHWAY ENGINEER
PUBLIC ROADS ADMINISTRATION
FEDERAL WORKERS AGENCY

These plans are subject to such revisions as may be required by the Public Roads Administration or the Commissioner of Highways. Construction is to be carried on in accordance with the plans and the Standard Road Bridge Specifications of 1936 as approved Dec. 29, 1936 by the Public Roads Administration, including all subsequent approved revisions and such revised specifications and special provisions as are submitted with the plans.


CORRECT: *Albee 7/1939*
ROAD ENGINEER
APPROVED: *Albee 7/1939*
DISTRICT HIGHWAY COMMISSIONER
SERIES FAP NO. 330 (1) FILED
SHEET 1 OF

DIST. # 1 PLANS

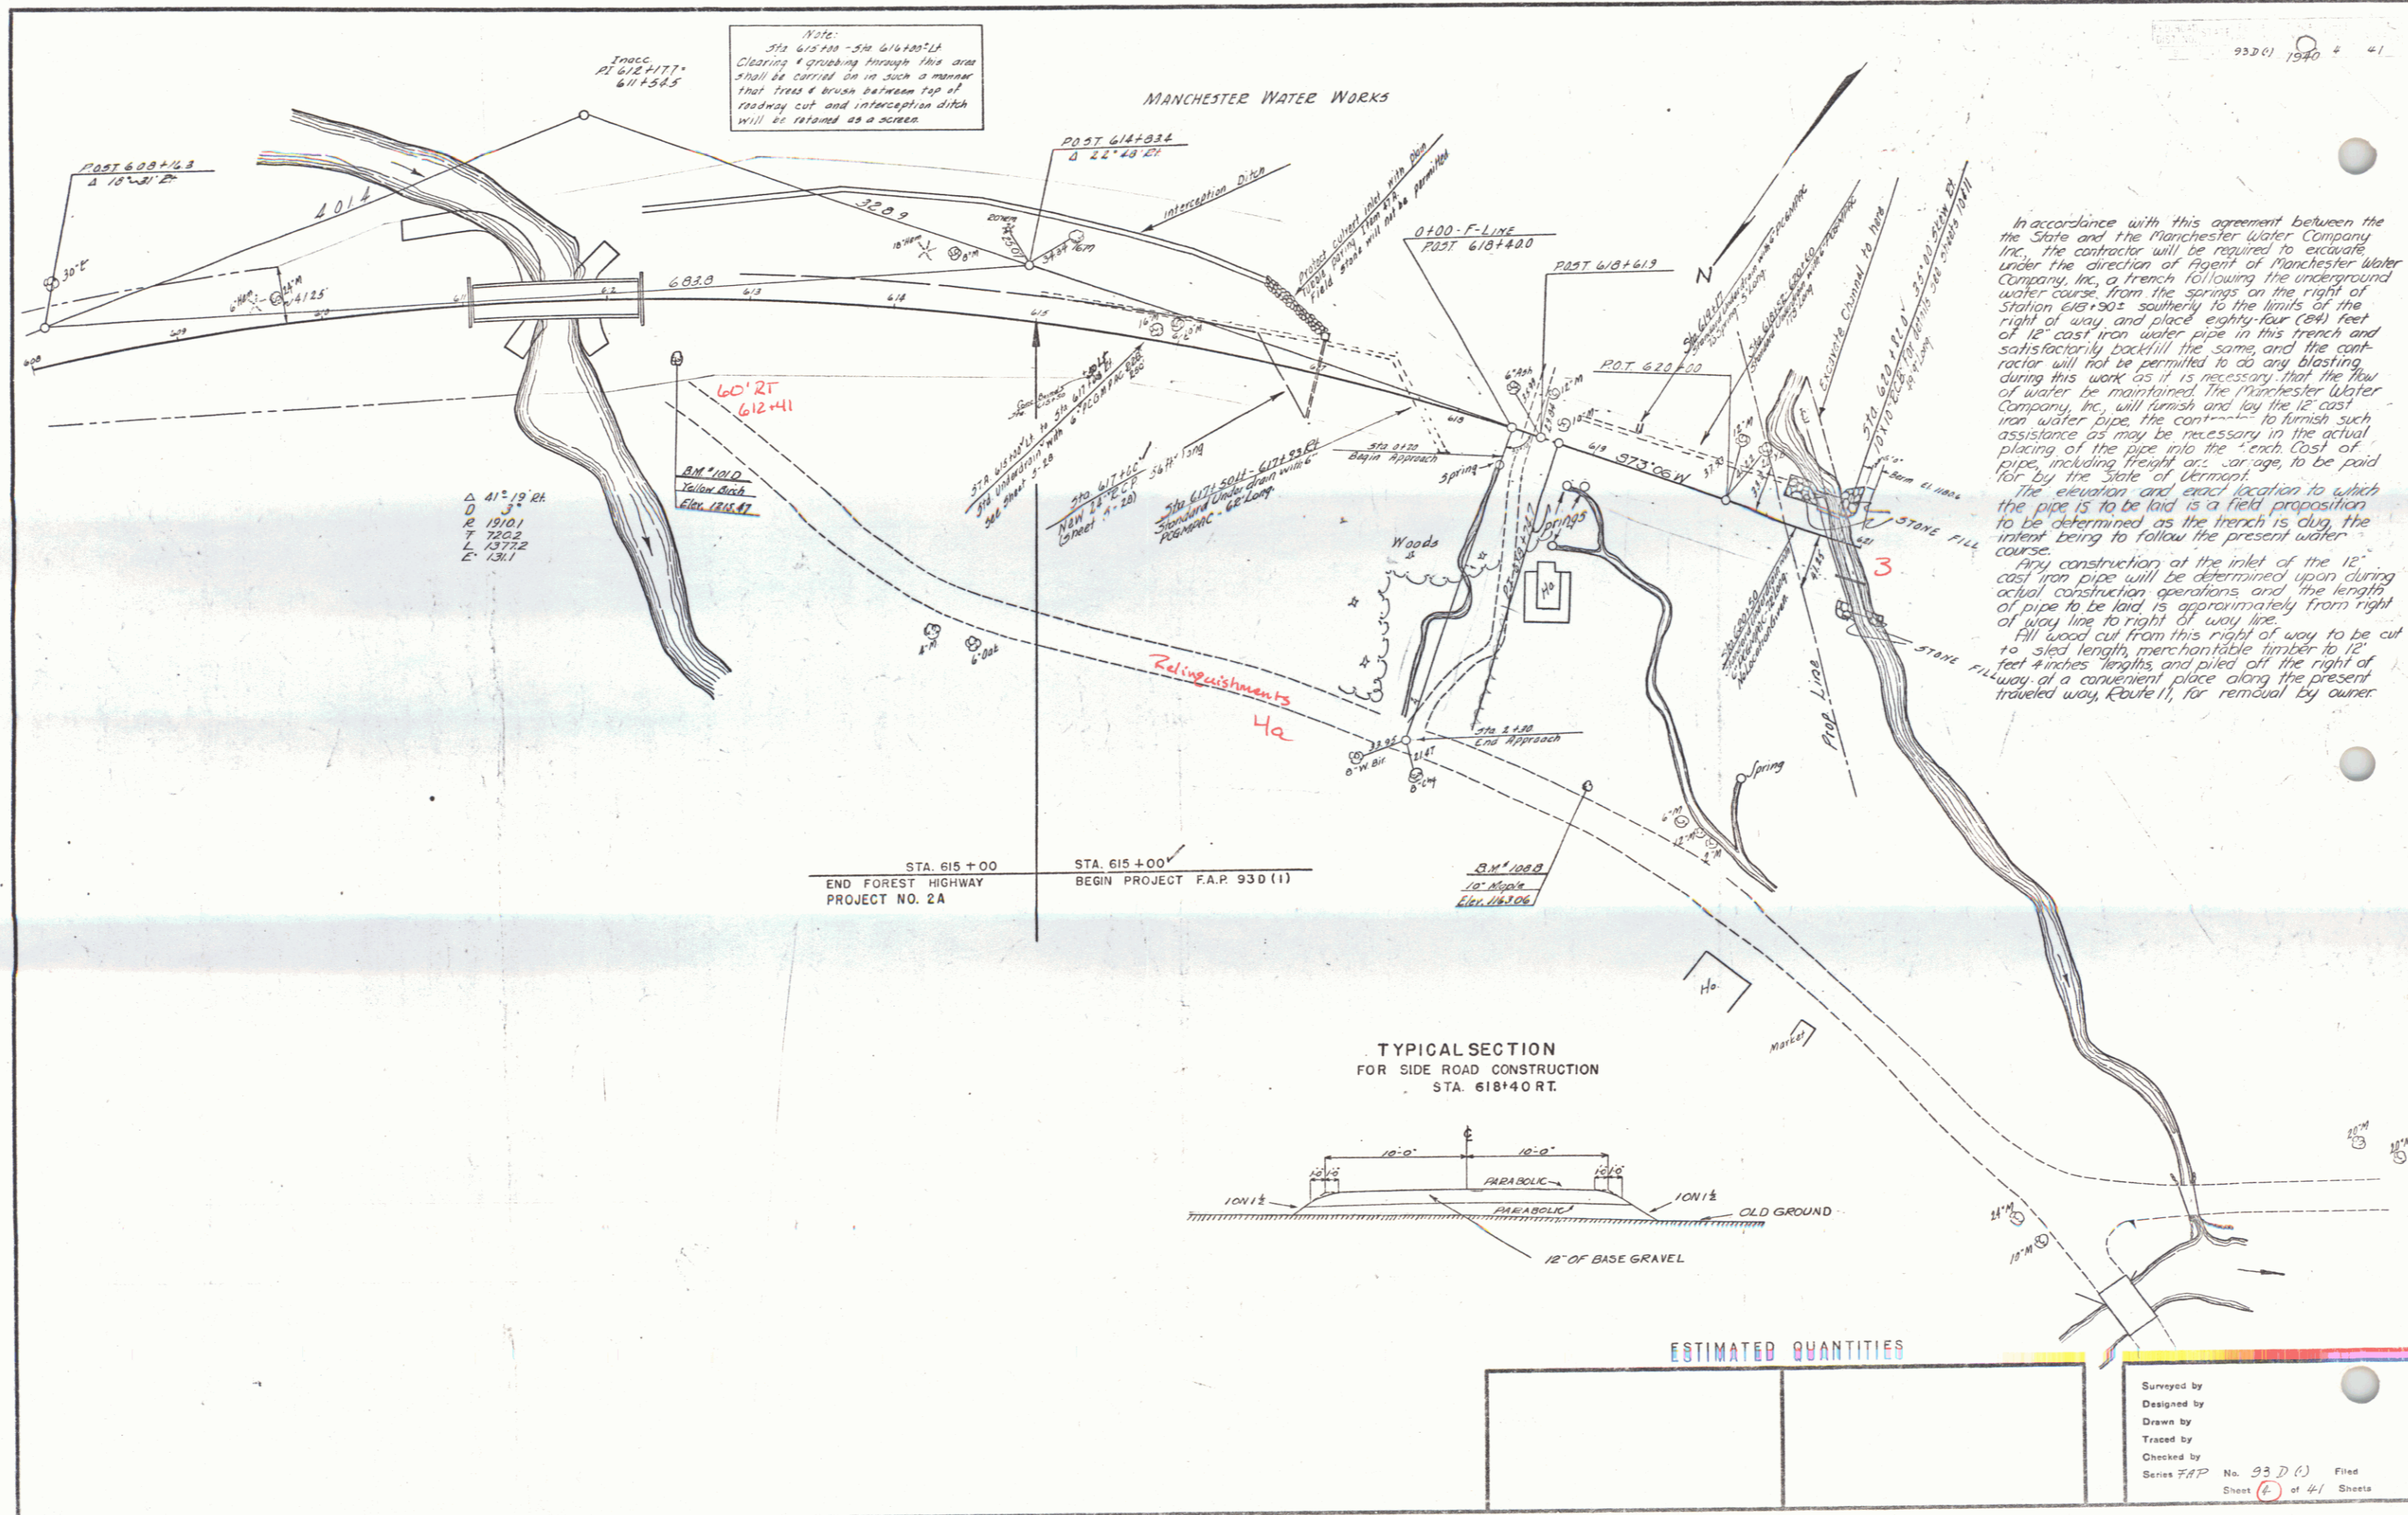


Note:
 STA 615+00 - STA 616+00
 Clearing & grubbing through this area
 shall be carried on in such a manner
 that trees & brush between top of
 roadway cut and interception ditch
 will be retained as a screen.

In accordance with this agreement between the
 State and the Manchester Water Company
 Inc. the contractor will be required to excavate
 under the direction of Agent of Manchester Water
 Company, Inc. a trench following the underground
 water course from the springs on the right of
 Station 618+00 southward to the limits of the
 right of way and place eighty-four (84) feet
 of 12" cast iron water pipe in this trench and
 satisfactorily backfill the same and the contractor
 will not be permitted to do any blasting
 during this work as it is necessary that the flow
 of water be maintained. The Manchester Water
 Company, Inc. will furnish and lay the 12" cast
 iron water pipe, the contractor to furnish such
 assistance as may be necessary in the actual
 placing of the pipe into the trench. Cost of
 pipe, including freight and storage, to be paid
 for by the State of Vermont.
 The elevation and exact location to which
 the pipe is to be laid is a field proposition
 to be determined as the trench is dug, the
 intent being to follow the present water
 course.
 Any construction of the inlet of the 12"
 cast iron pipe will be determined upon during
 actual construction operations and the length
 of pipe to be laid is approximately from right
 of way line to right of way line.
 All wood cut from this right of way to be cut
 to sled length, merchantable timber to 12"
 feet inches lengths, and piled off the right of
 way at a convenient place along the present
 traveled way, Route 11, for removal by owner.

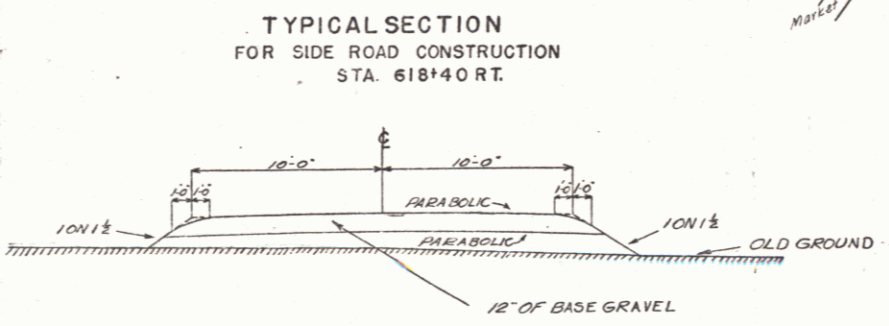

ESTIMATED QUANTITIES


Surveyed by
 Designed by
 Drawn by
 Traced by
 Checked by
 Series F.A.P. No. 93 D (1) Filed
 Sheet 6 of 41 Sheets

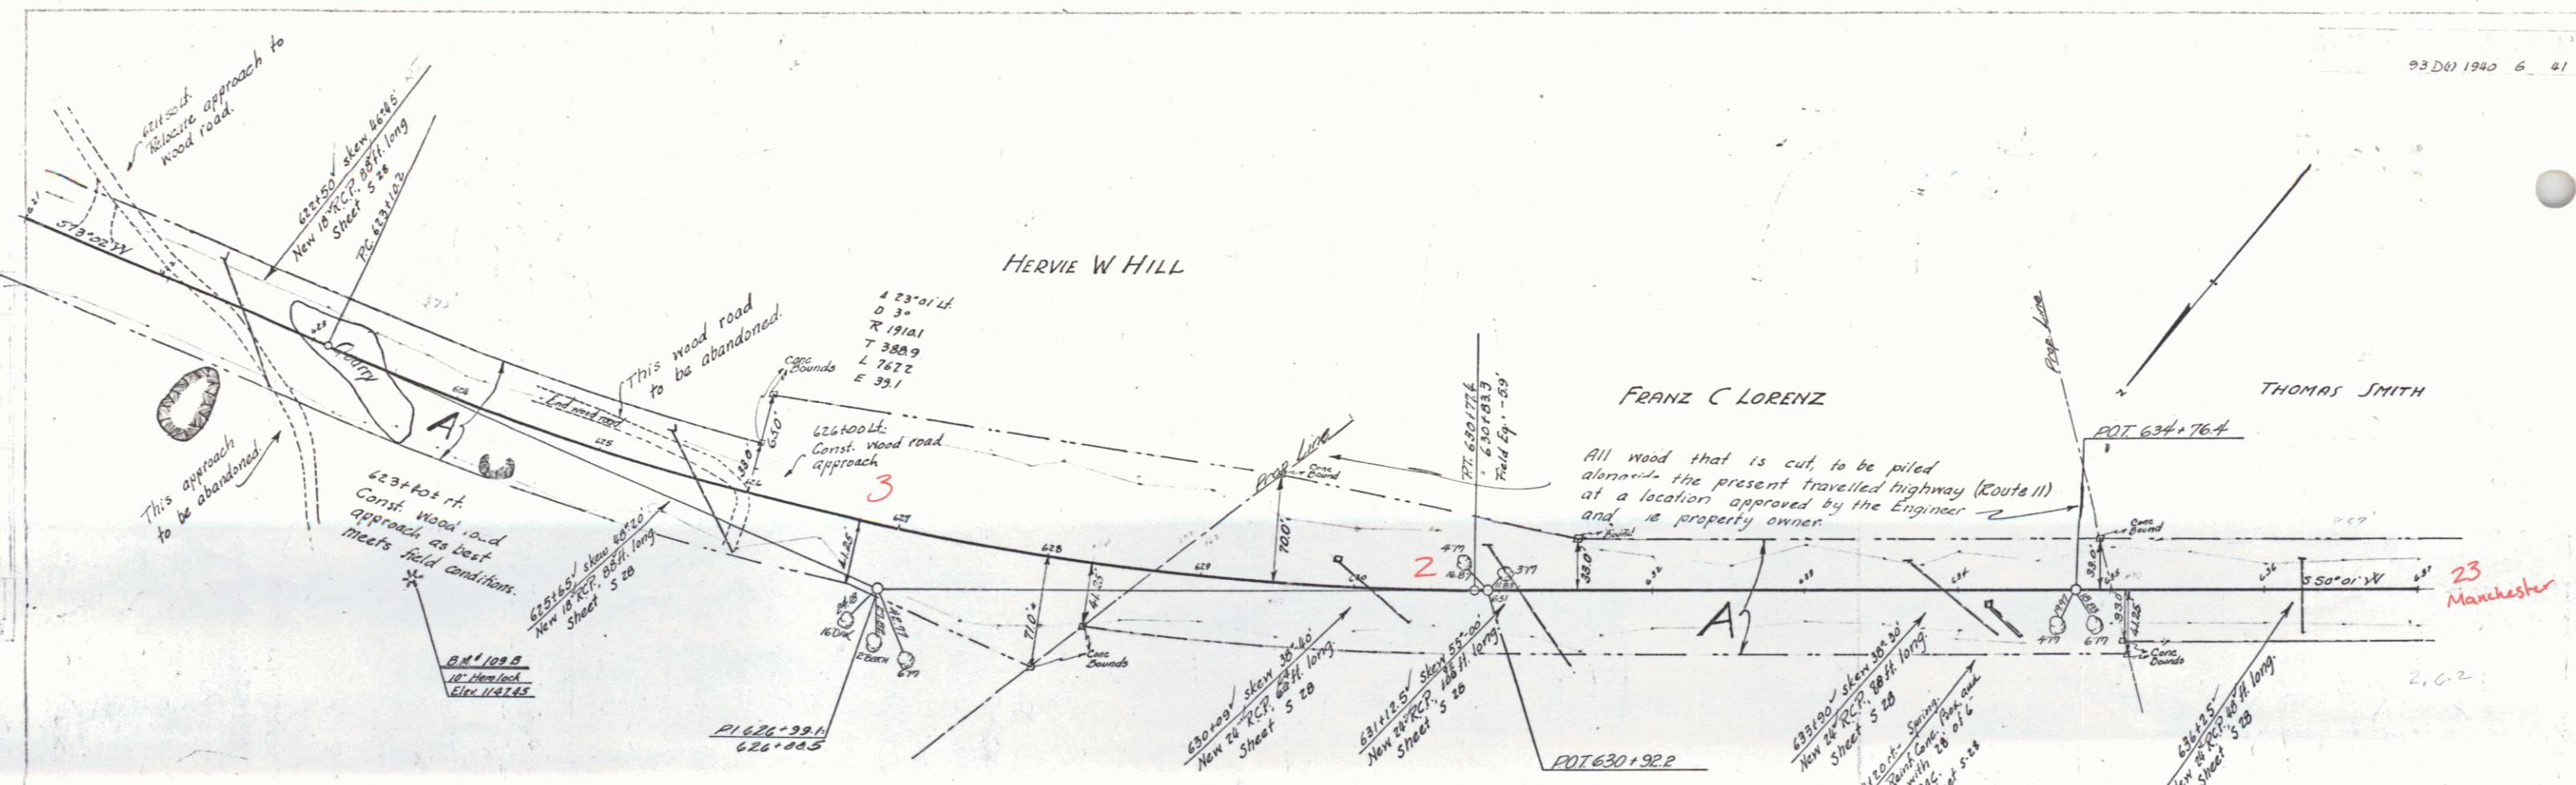

PARCEL	INTRUMENT	DATE	GRANTOR	GRANTEE	RECORDED	REMARKS
A	WD	9-25-39	HERVIE W HILL	ST OF VT	BOOK 15 PAGE 90	2 CULV.
A	QC	9-25-39	FRANZ C LORENZ	ST OF VT	BOOK 15 PAGE 89	3 CULV.

PARCEL INSTRUMENT DATE GRANTOR GRANTEE RECORDED REMARK
 A V.D. 8-30-39 THOMAS E. L. BEATRICE SMITH ST. CITY WINHALL
 BOOK 15 PAGE 83-2 DATE 9-15-39 400LY

93 D(4) 1940 B 41

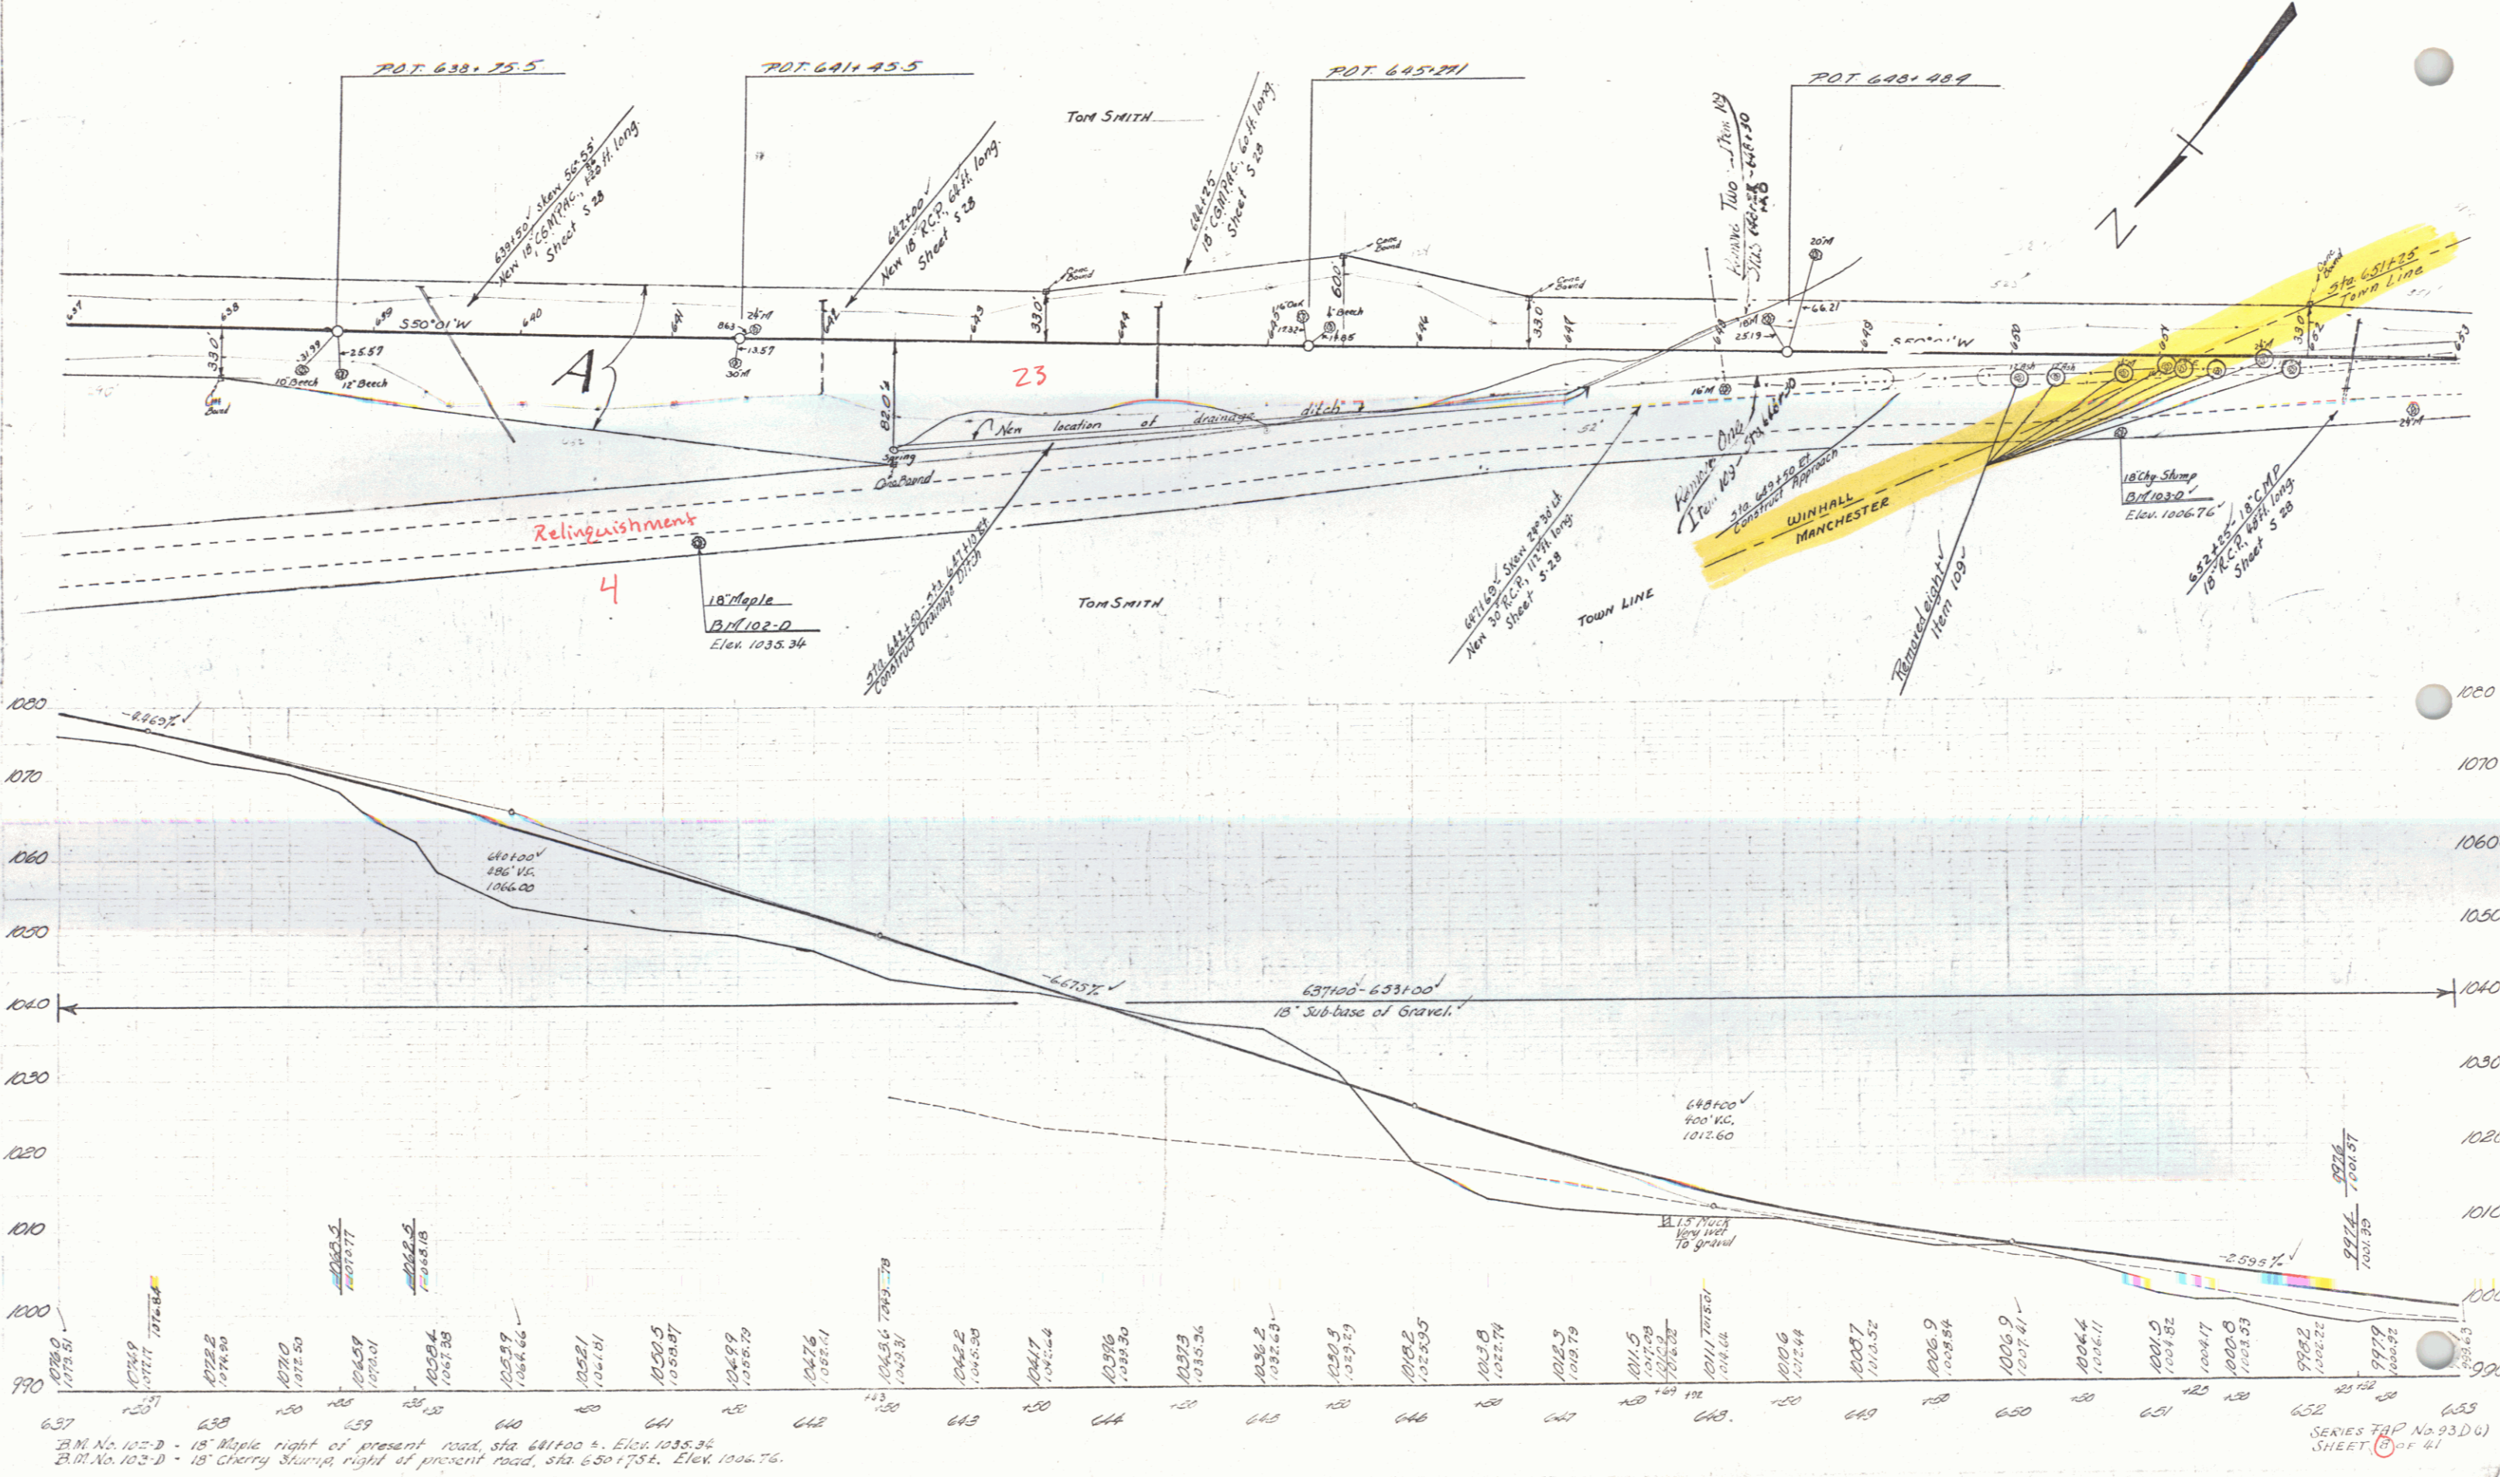


B.M. No. 102-D - 18" Maple, right of present road, sta 641+00 ±, Elev. 1035.34
 B.M. No. 103-D - 18" Cherry Stump, right of present road, sta 650+75 ±, Elev. 1006.76



SERIES T&P No. 93 D(4)
 SHEET 16 OF 41

PARCEL	INSTRUMENT	DATE	GRANTOR	GRANTEE	RECORDED	REMARKS
A	VD	8-30-39	THOMAS E. L. BERTRICE SMITH	ST. OF VT.	MANCHESTER BOOK PAGE 818E 73 3-25-39	

93 DU 1940 2 41

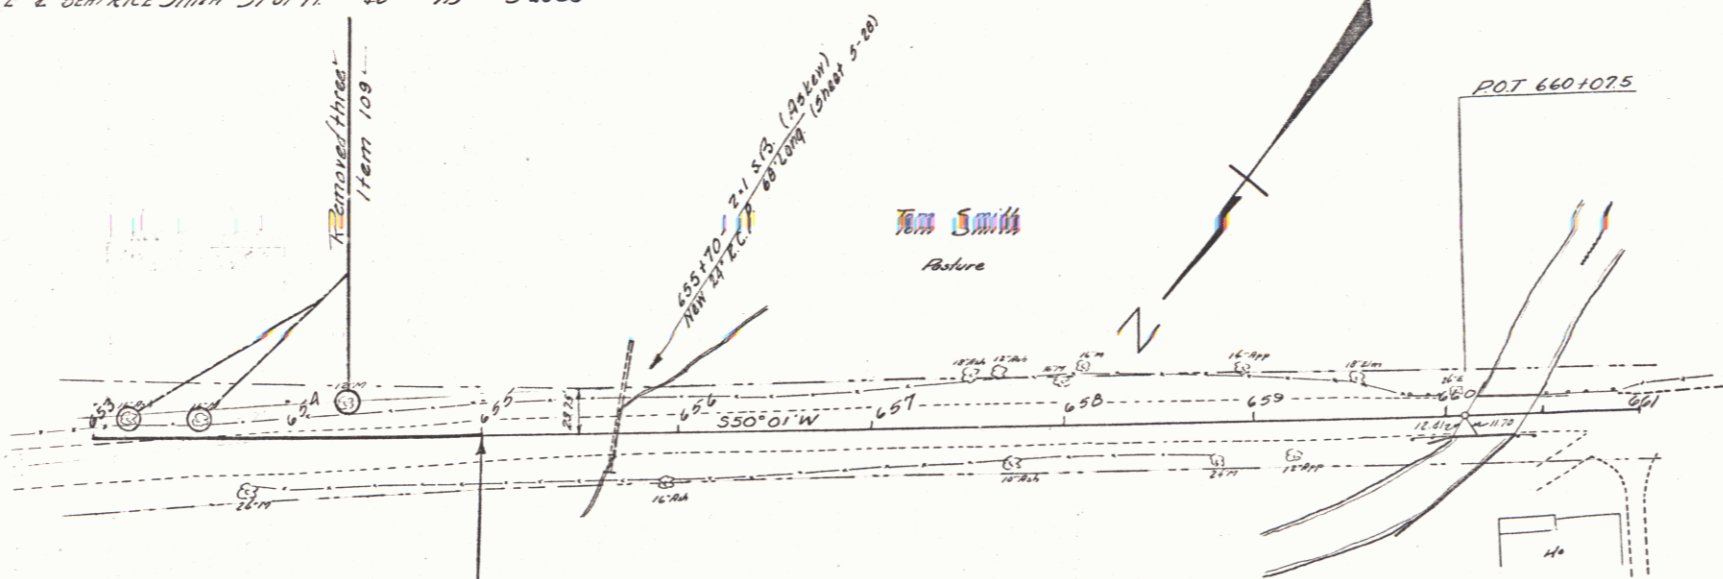

Sta. 655+00
END OF PROJECT F&P 350(1)
PA. Marker Constructed
Sta 655+00.00

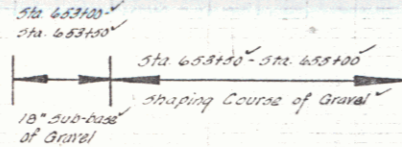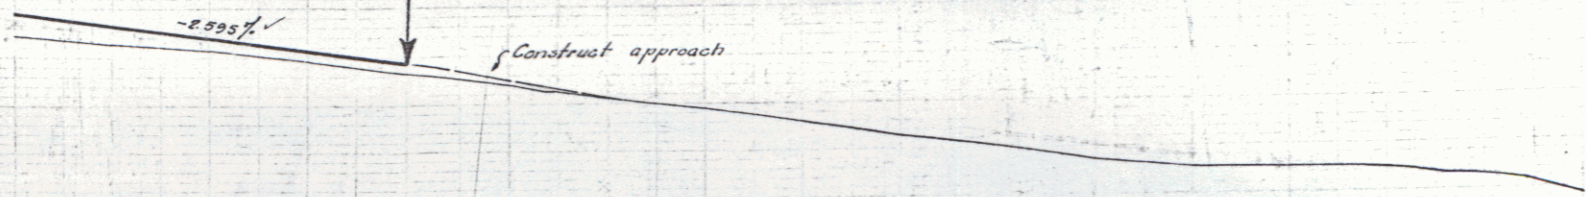

987.48	988.35	989.03	989.75	990.4	991.0	991.7	992.4	1599.3	1599.9	1600.6	1601.3	1668.5	1
--------	--------	--------	--------	-------	-------	-------	-------	-------	-------	-------	-------	-------	-------	-------	-------	-------	-------	--------	--------	---