

PLAN  
 DRAWN BY: [Name]  
 CHECKED BY: [Name]  
 DATE: [Date]

PROFILE  
 DRAWN BY: [Name]  
 CHECKED BY: [Name]  
 DATE: [Date]

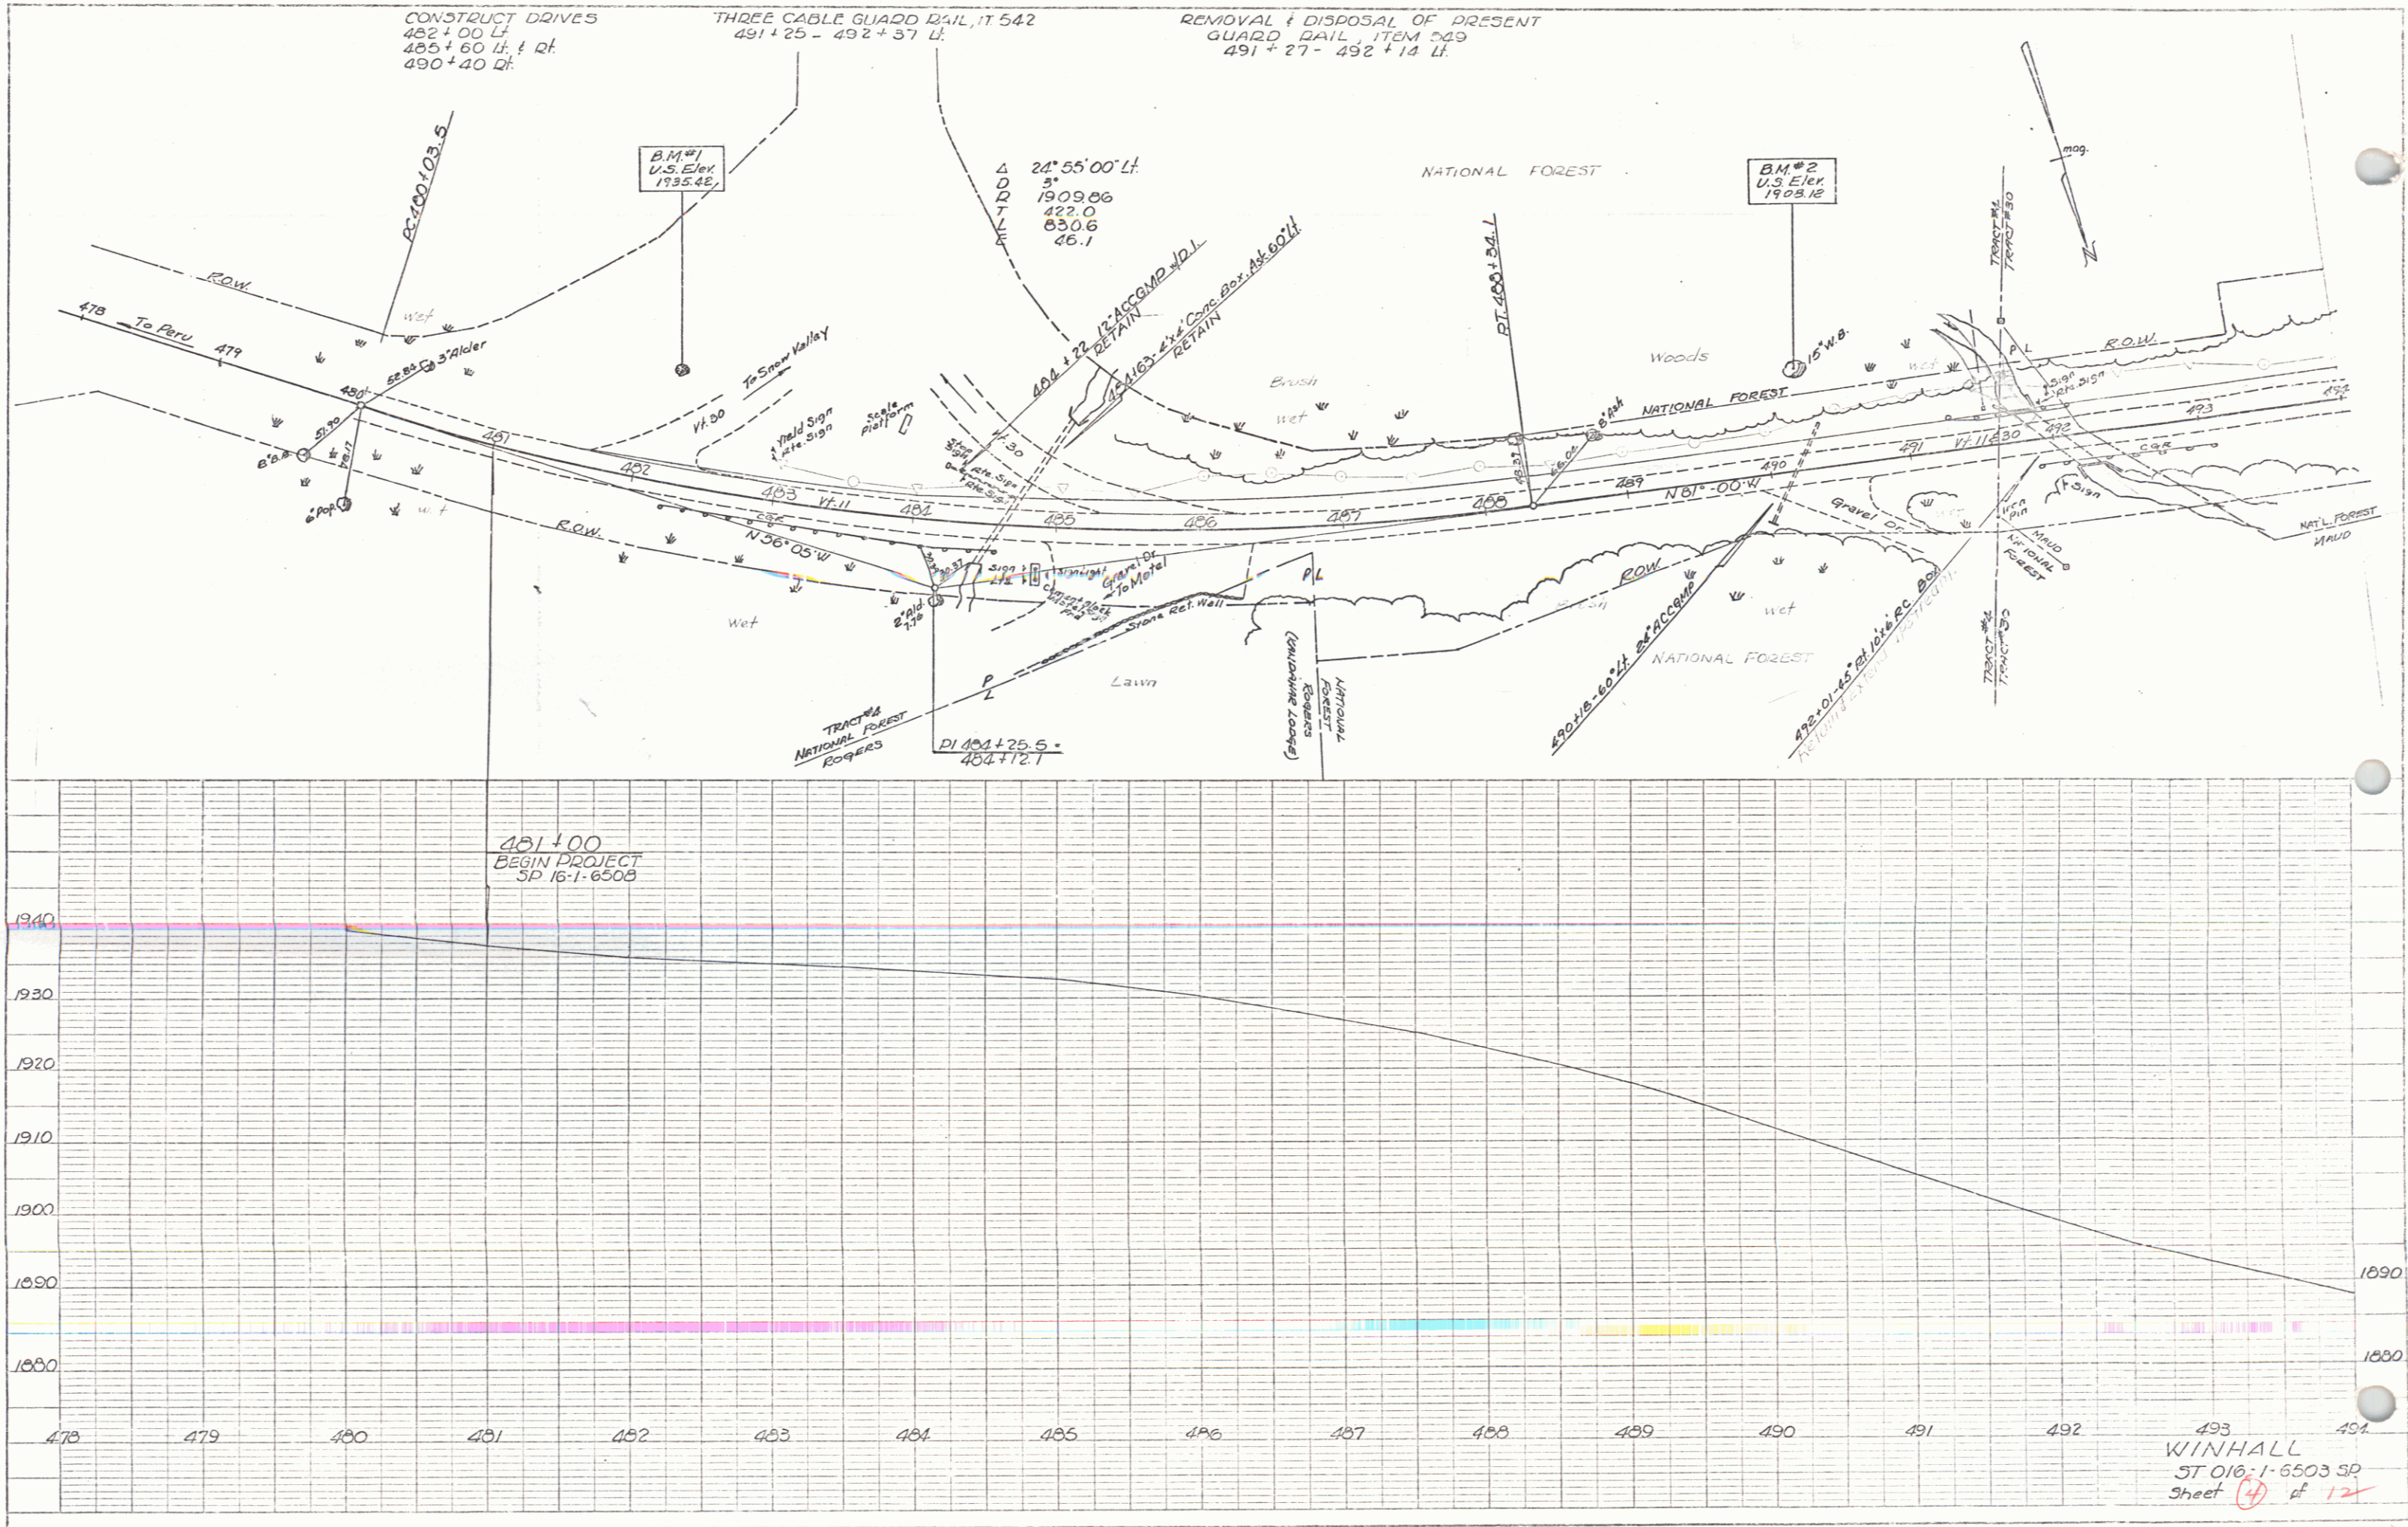


PLATE 1, PLAN PROFILE  
 487012 IMPERIAL 11x17 IN. 1960

WINHALL  
 ST 016-1-6503 SP  
 Sheet 4 of 12