


PLAN
 DATE: 10/15/11
 DRAWN BY: [Signature]
 CHECKED BY: [Signature]
 NO. OF SHEETS: 12
 SHEET NO.: 7

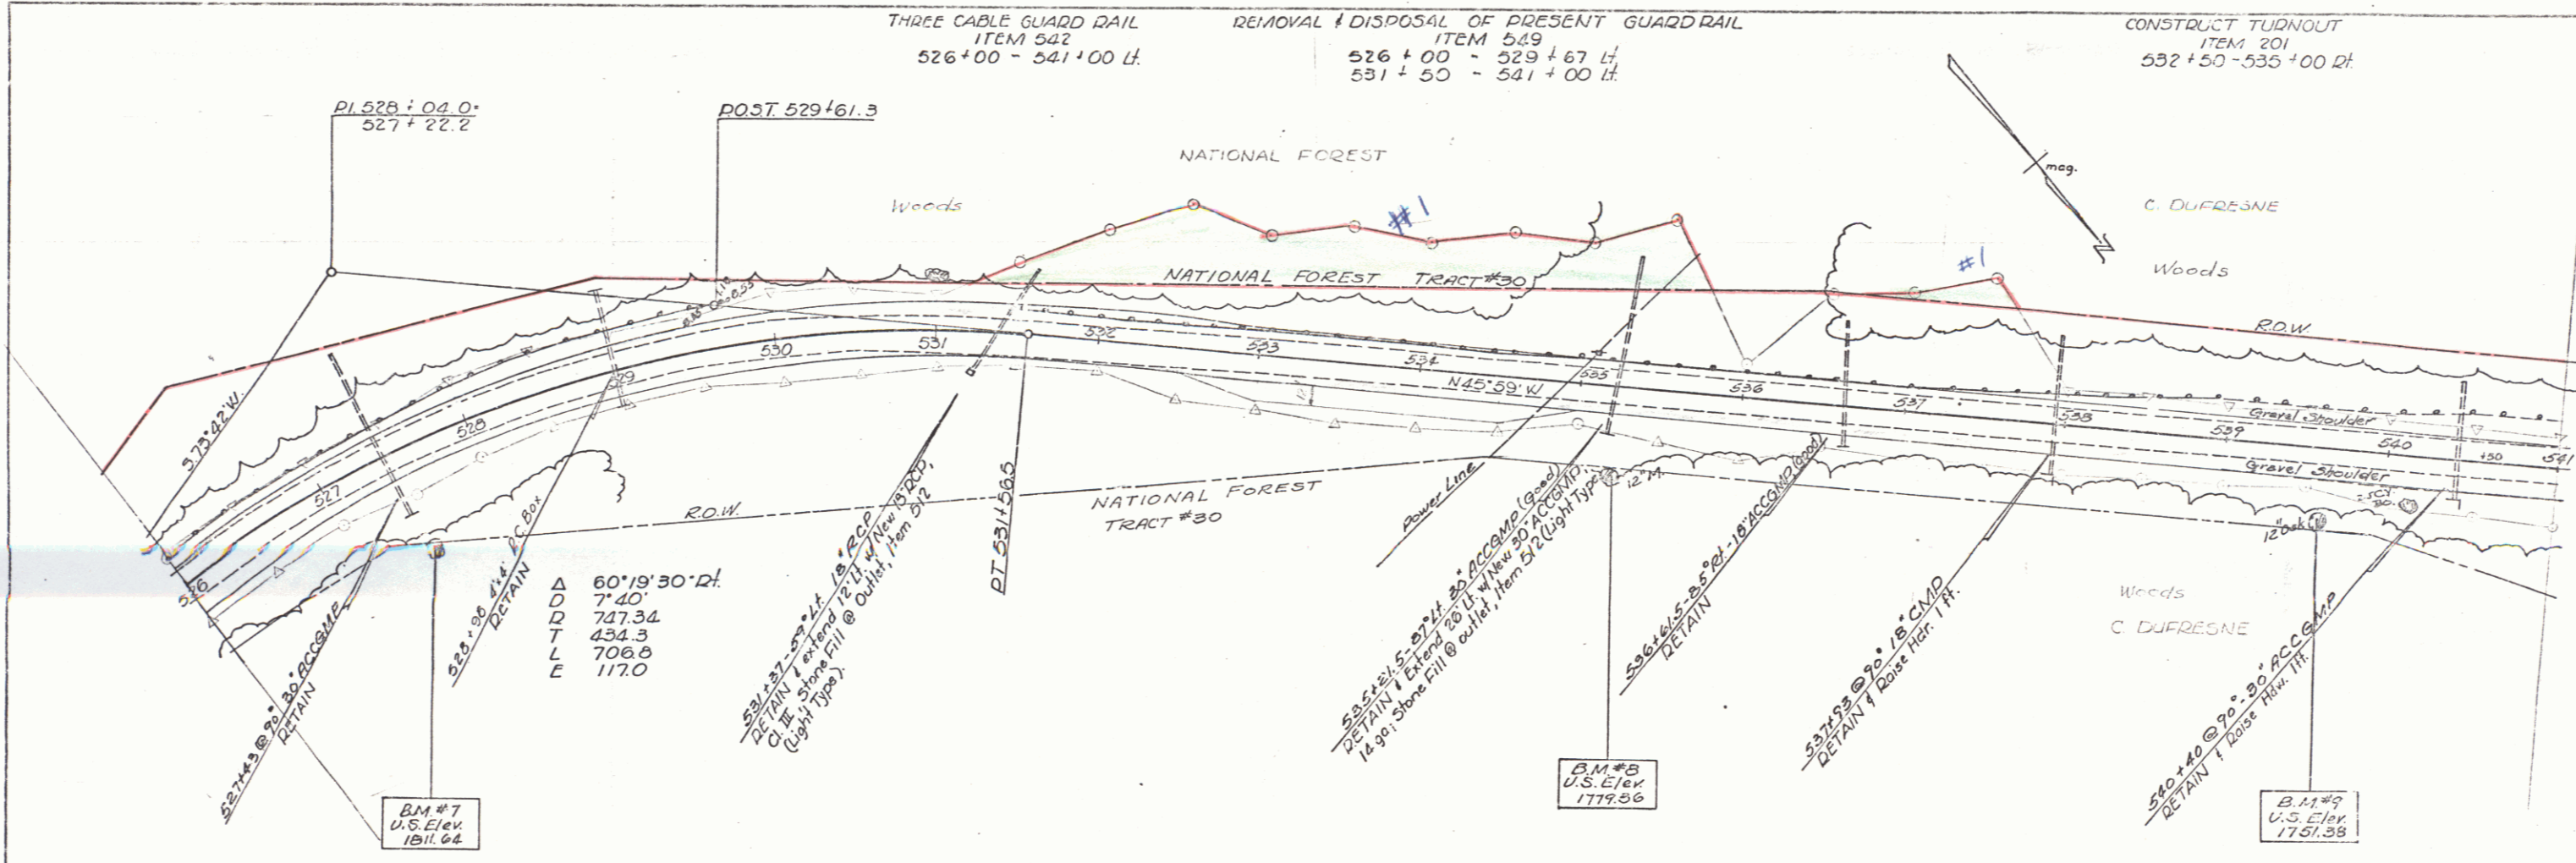

PROFILE
 DATE: 10/15/11
 DRAWN BY: [Signature]
 CHECKED BY: [Signature]
 NO. OF SHEETS: 12
 SHEET NO.: 7

