


POOR ORIGINAL COPY


3" x 36" CASEY QUARTZ DRILL
ITEM 547
609+27 - 611+40 LI
609+27 - 611+40 LI

TREATED THAMES SOILS
ITEM 548
609+27 - 611+40 LI

REMOVAL & DISPOSAL OF PRESENT
ITEM 549
609+27 - 609+30 LI
609+30 - 609+40 LI
611+10 - 611+40 LI
611+10 - 611+40 LI

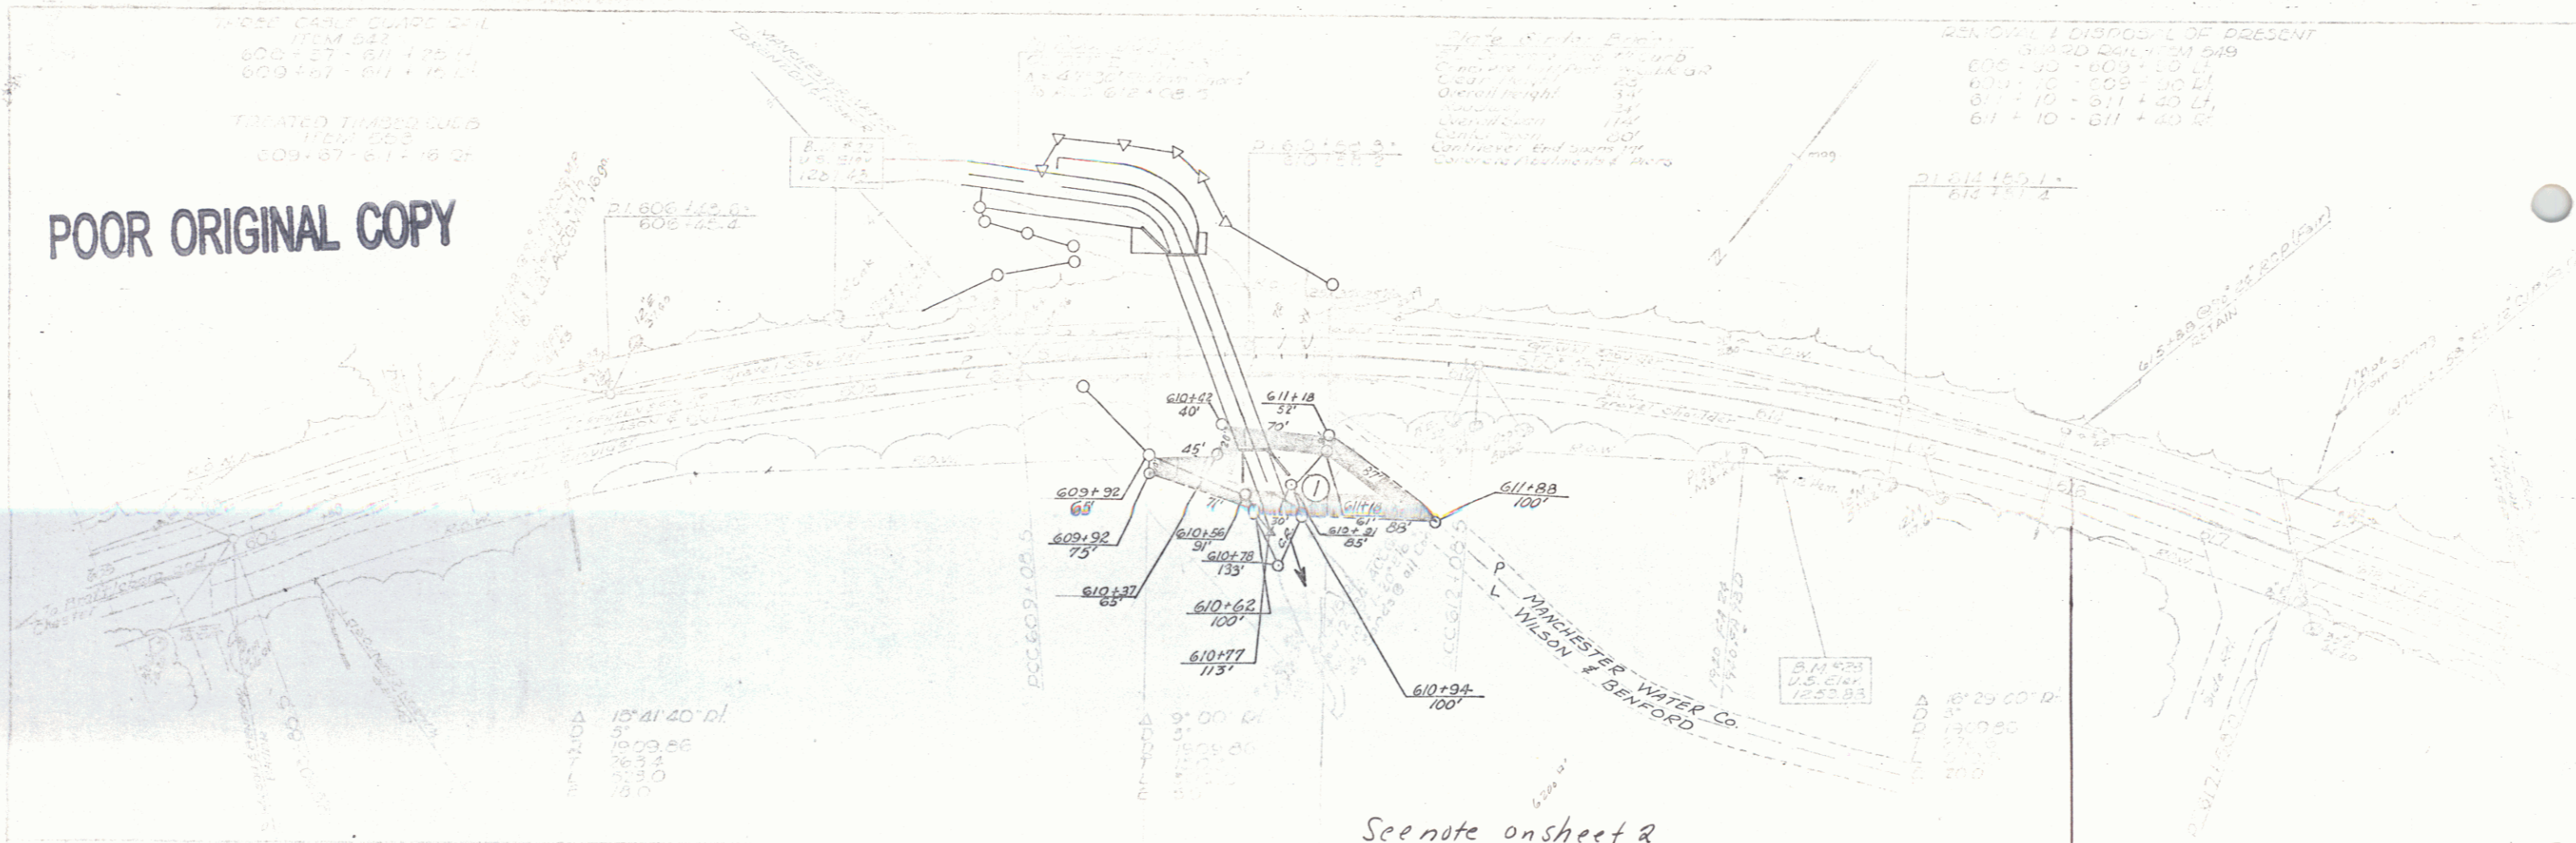

See note on sheet 2

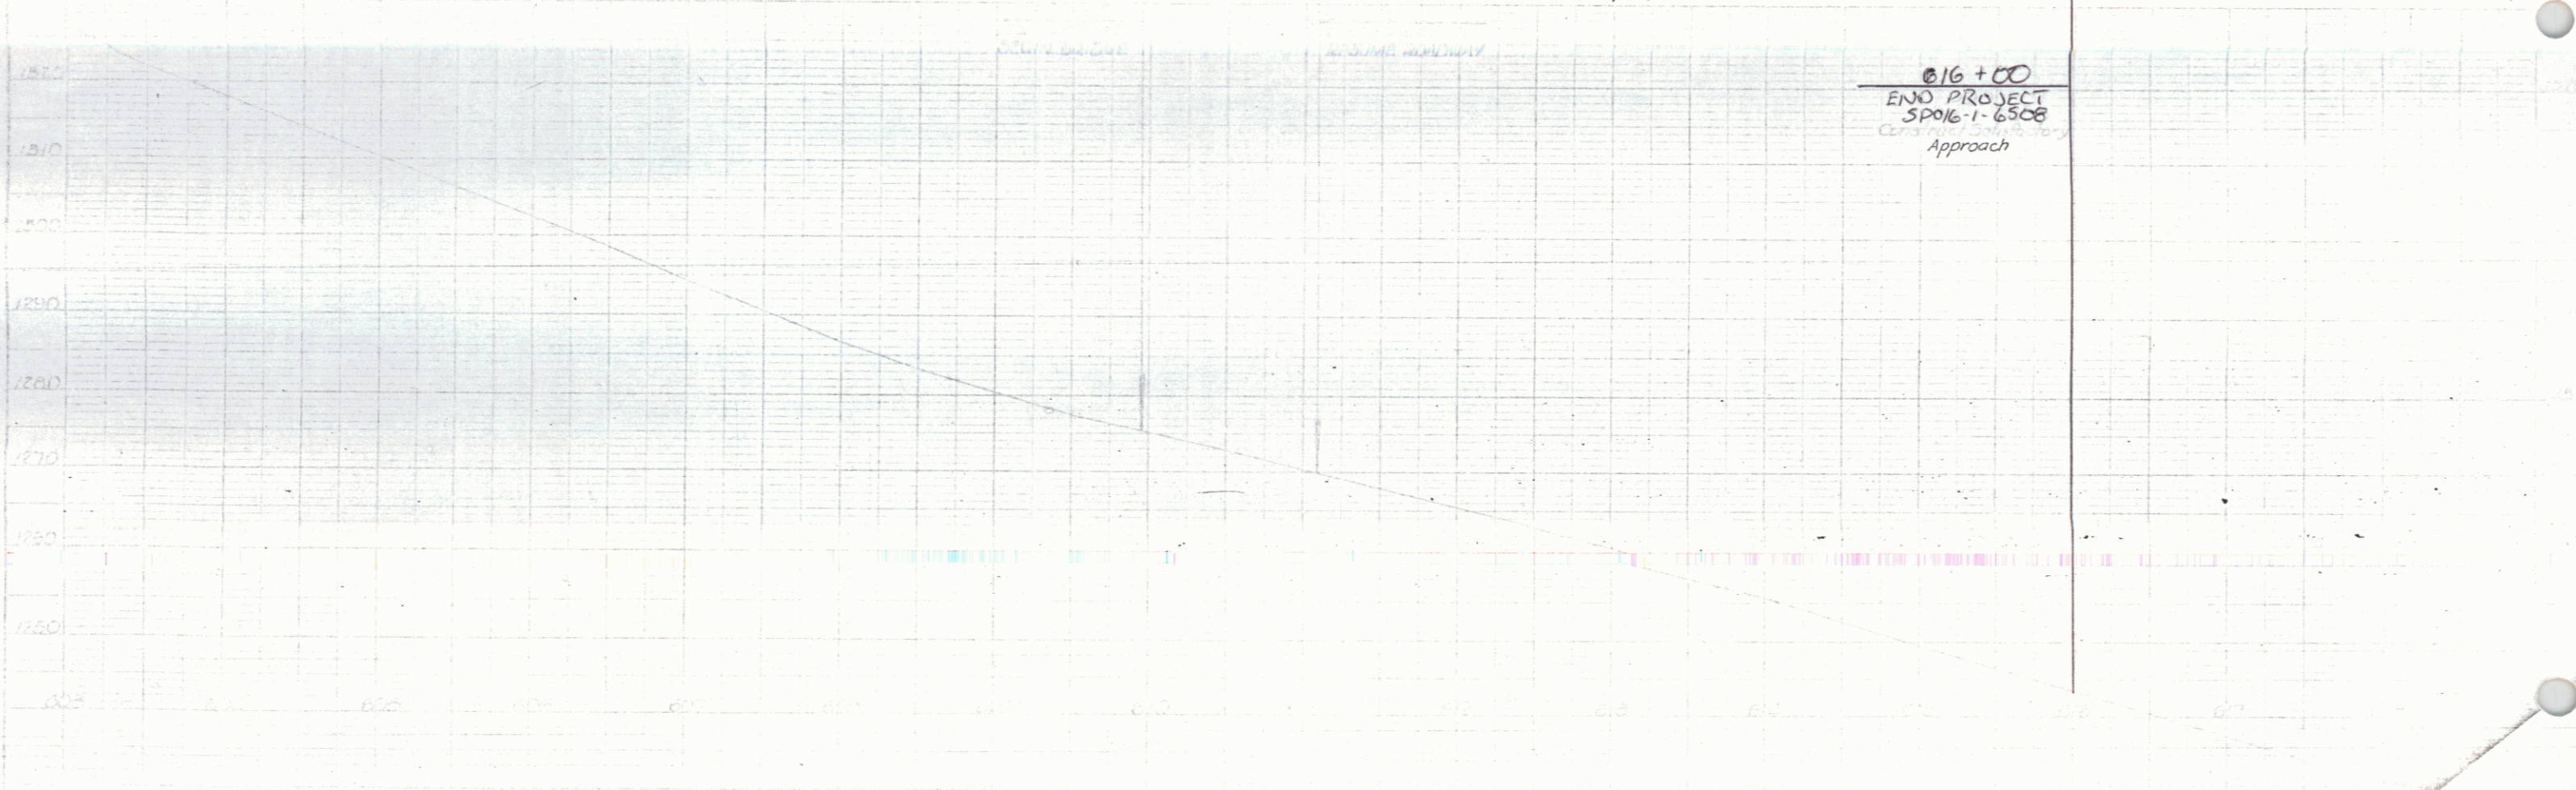

616+00
END PROJECT
SP016-1-6508
Approach