

**PLAN**  
 DRAWN BY: [Signature]  
 CHECKED BY: [Signature]  
 DATE: [Date]  
 SCALE: [Scale]  
 SHEET NO. [Number]

**PROFILE**  
 DRAWN BY: [Signature]  
 CHECKED BY: [Signature]  
 DATE: [Date]  
 SCALE: [Scale]  
 SHEET NO. [Number]

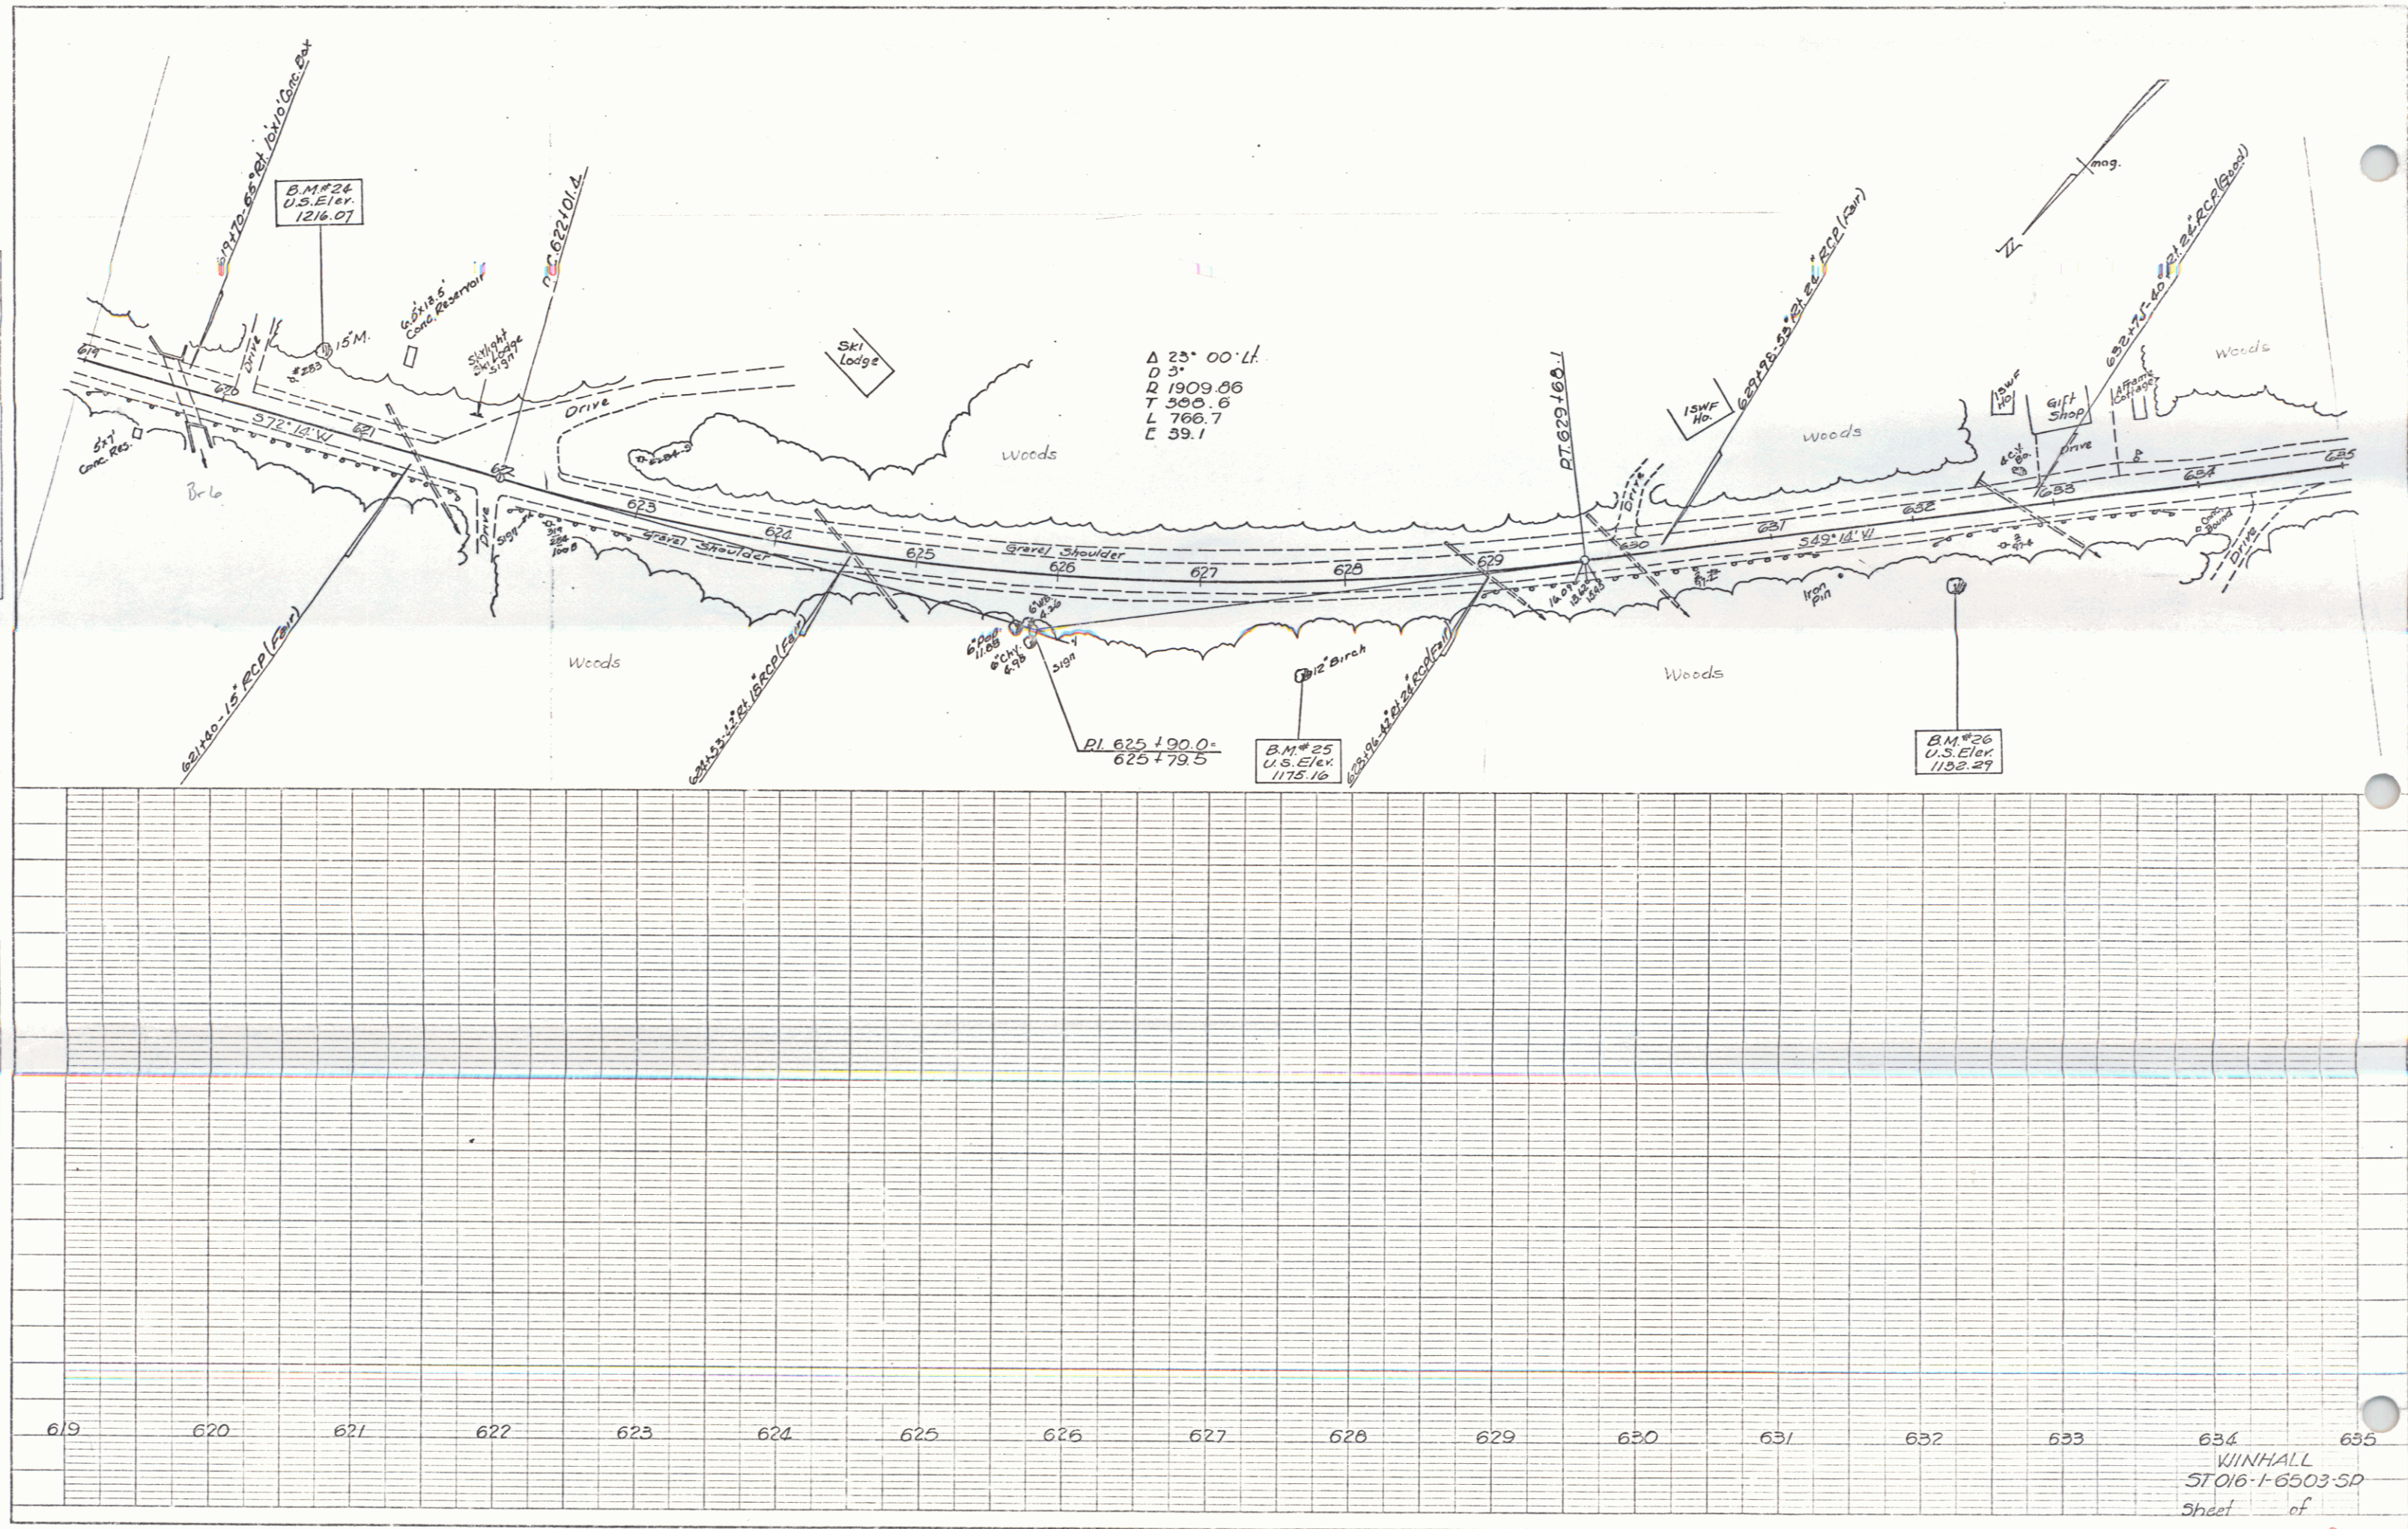


PLATE 1, PLAN PROFILE  
 H&E ENGINEERS & SURVEYORS  
 48 7012 IMPERIAL

634 WINHALL  
 57016-1-6503-5D  
 Sheet of