



PLAN
 SUBMITTED BY
 DATE
 CHECKED BY
 DATE
 NOTE BOOK NO.
 DATE
 NO.

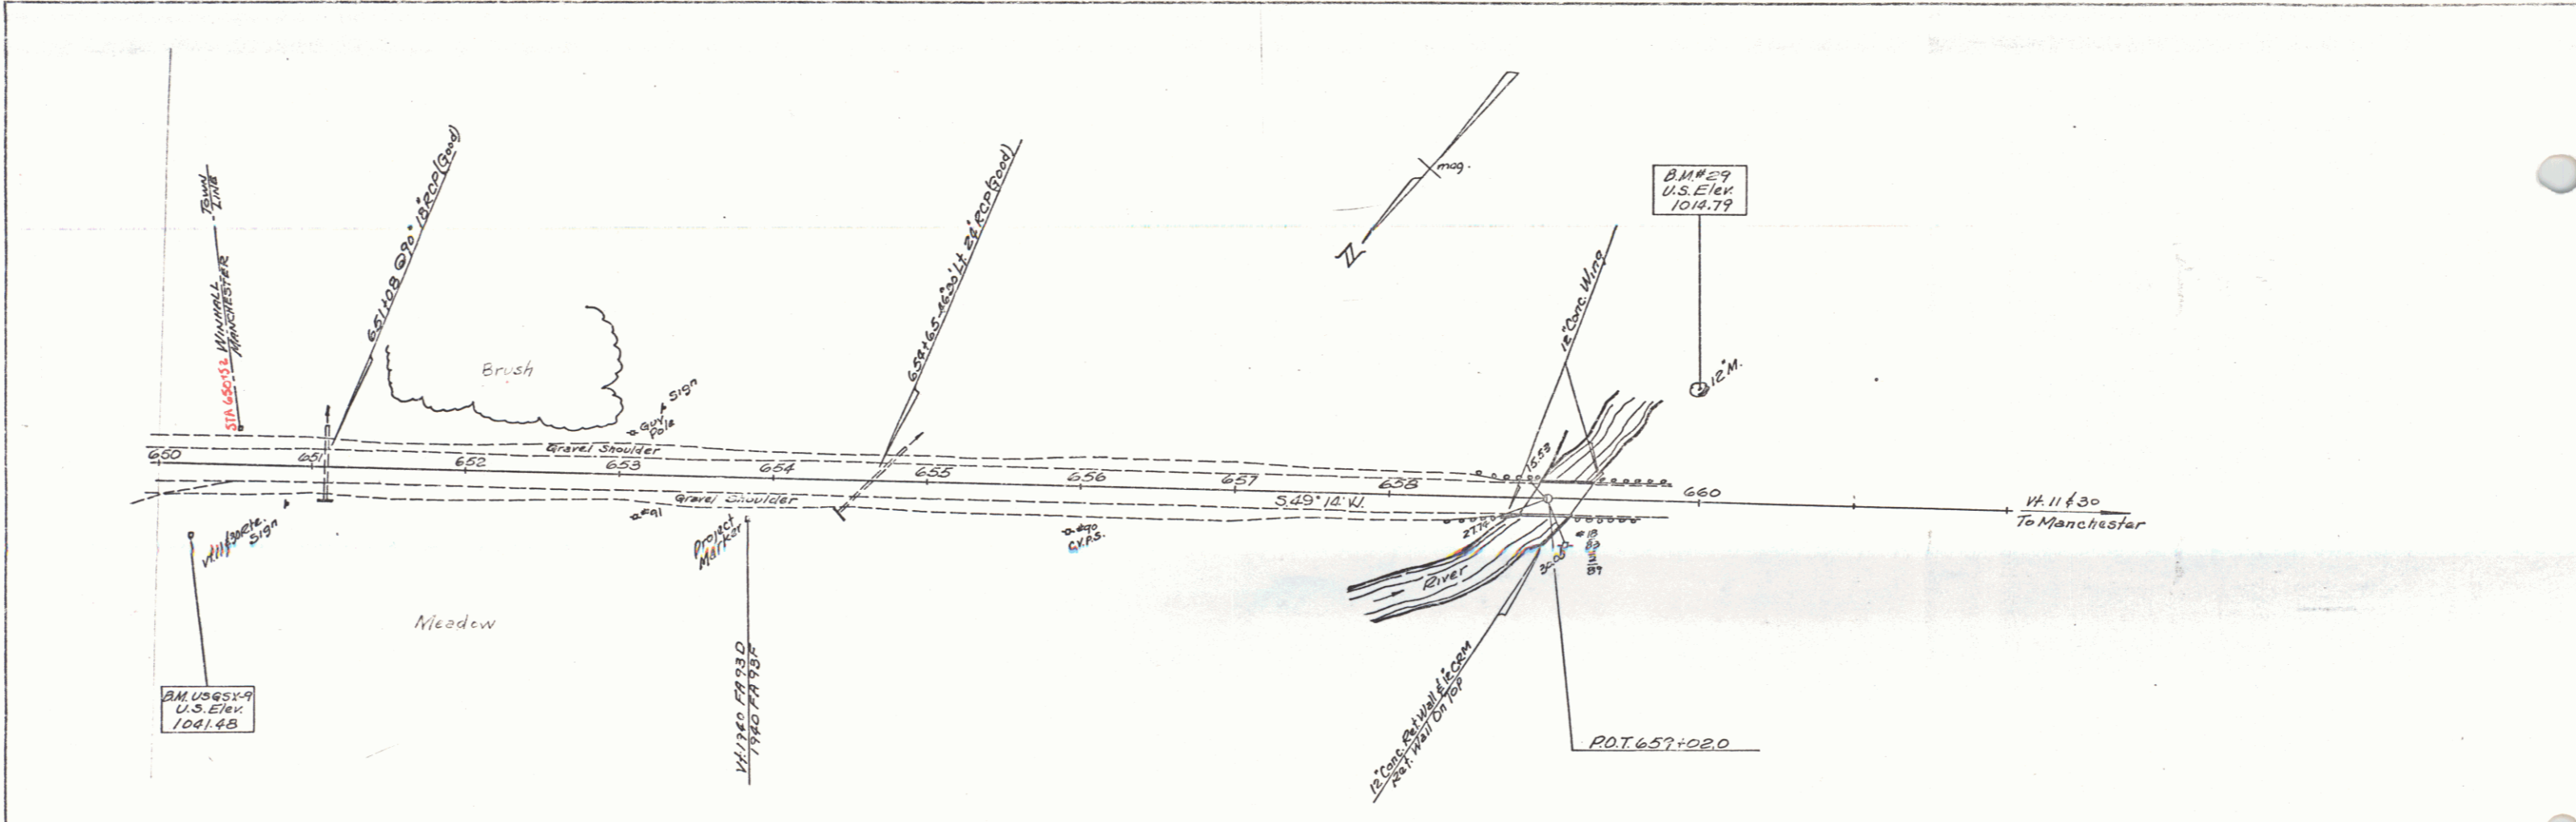

PROFILE
 DATE
 CHECKED BY
 DATE
 NOTE BOOK NO.
 DATE
 NO.

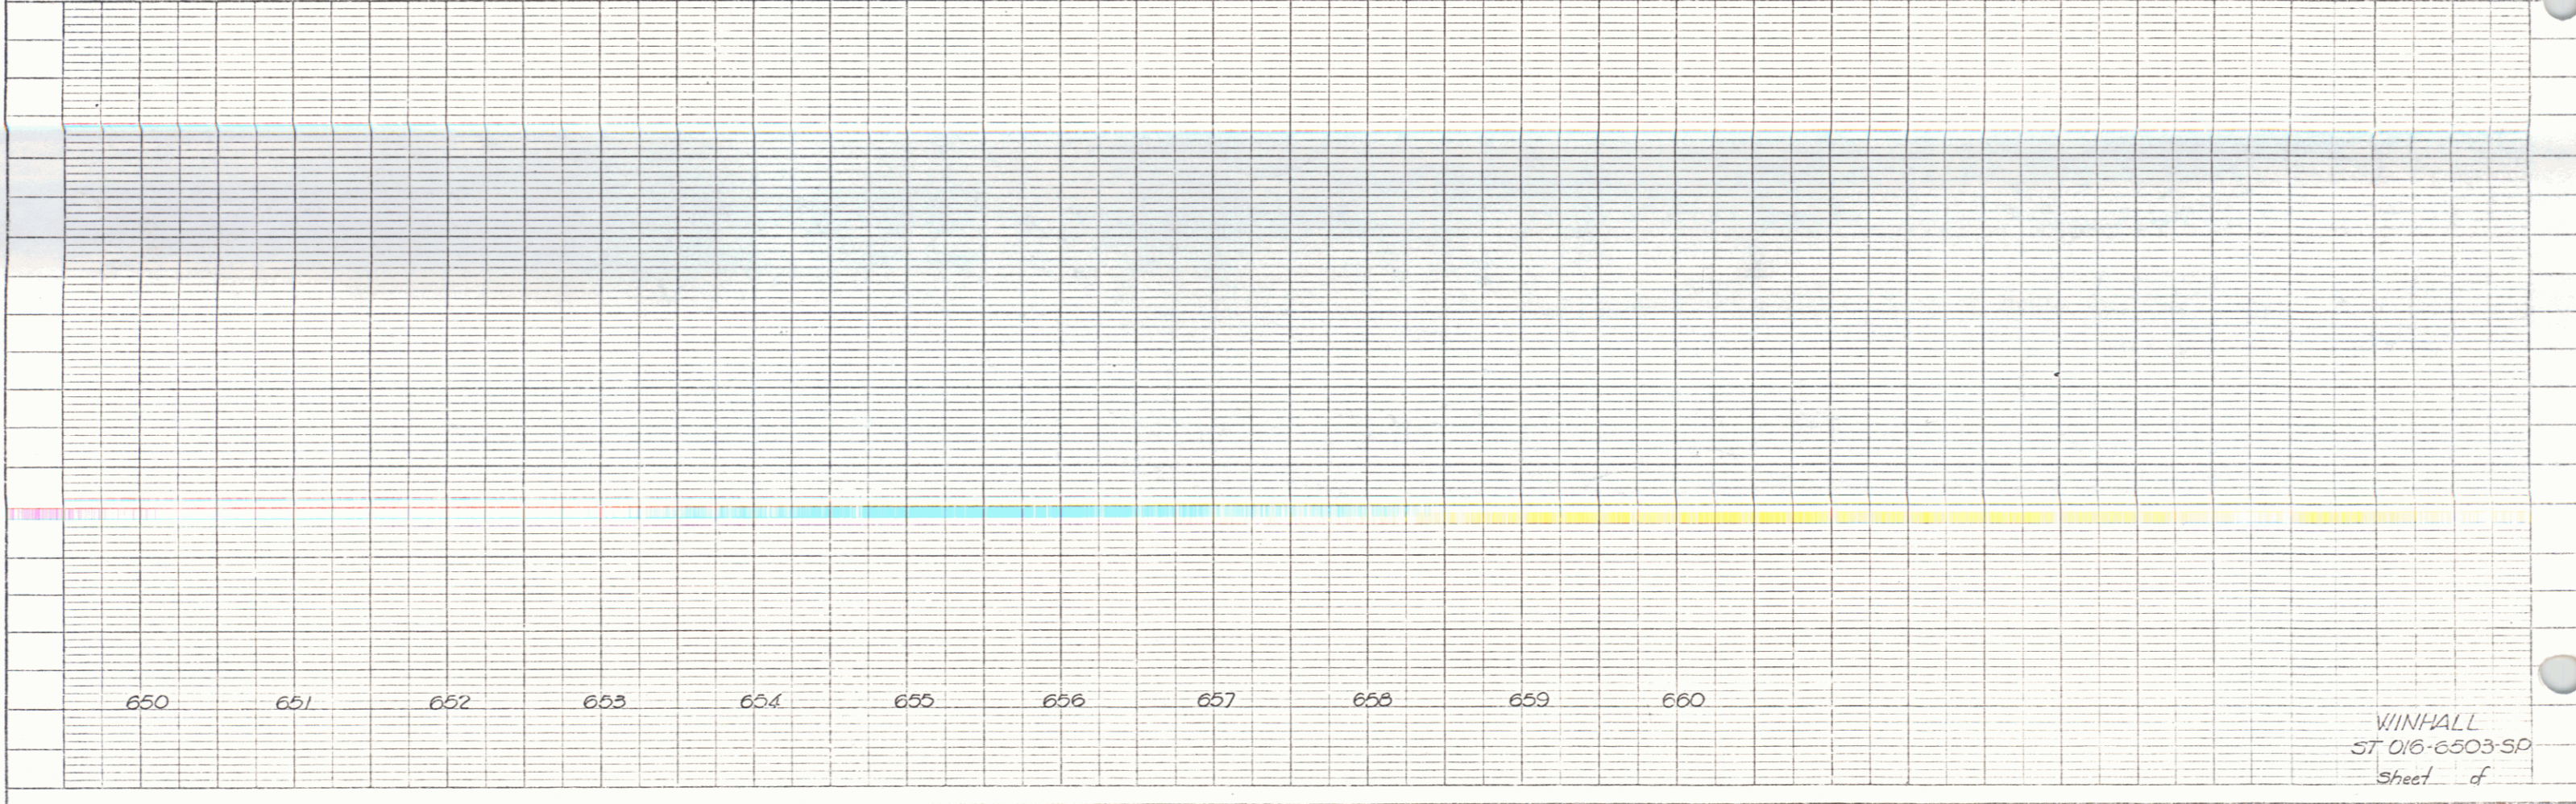

WINHALL
 ST 016-6503-50
 Sheet d