
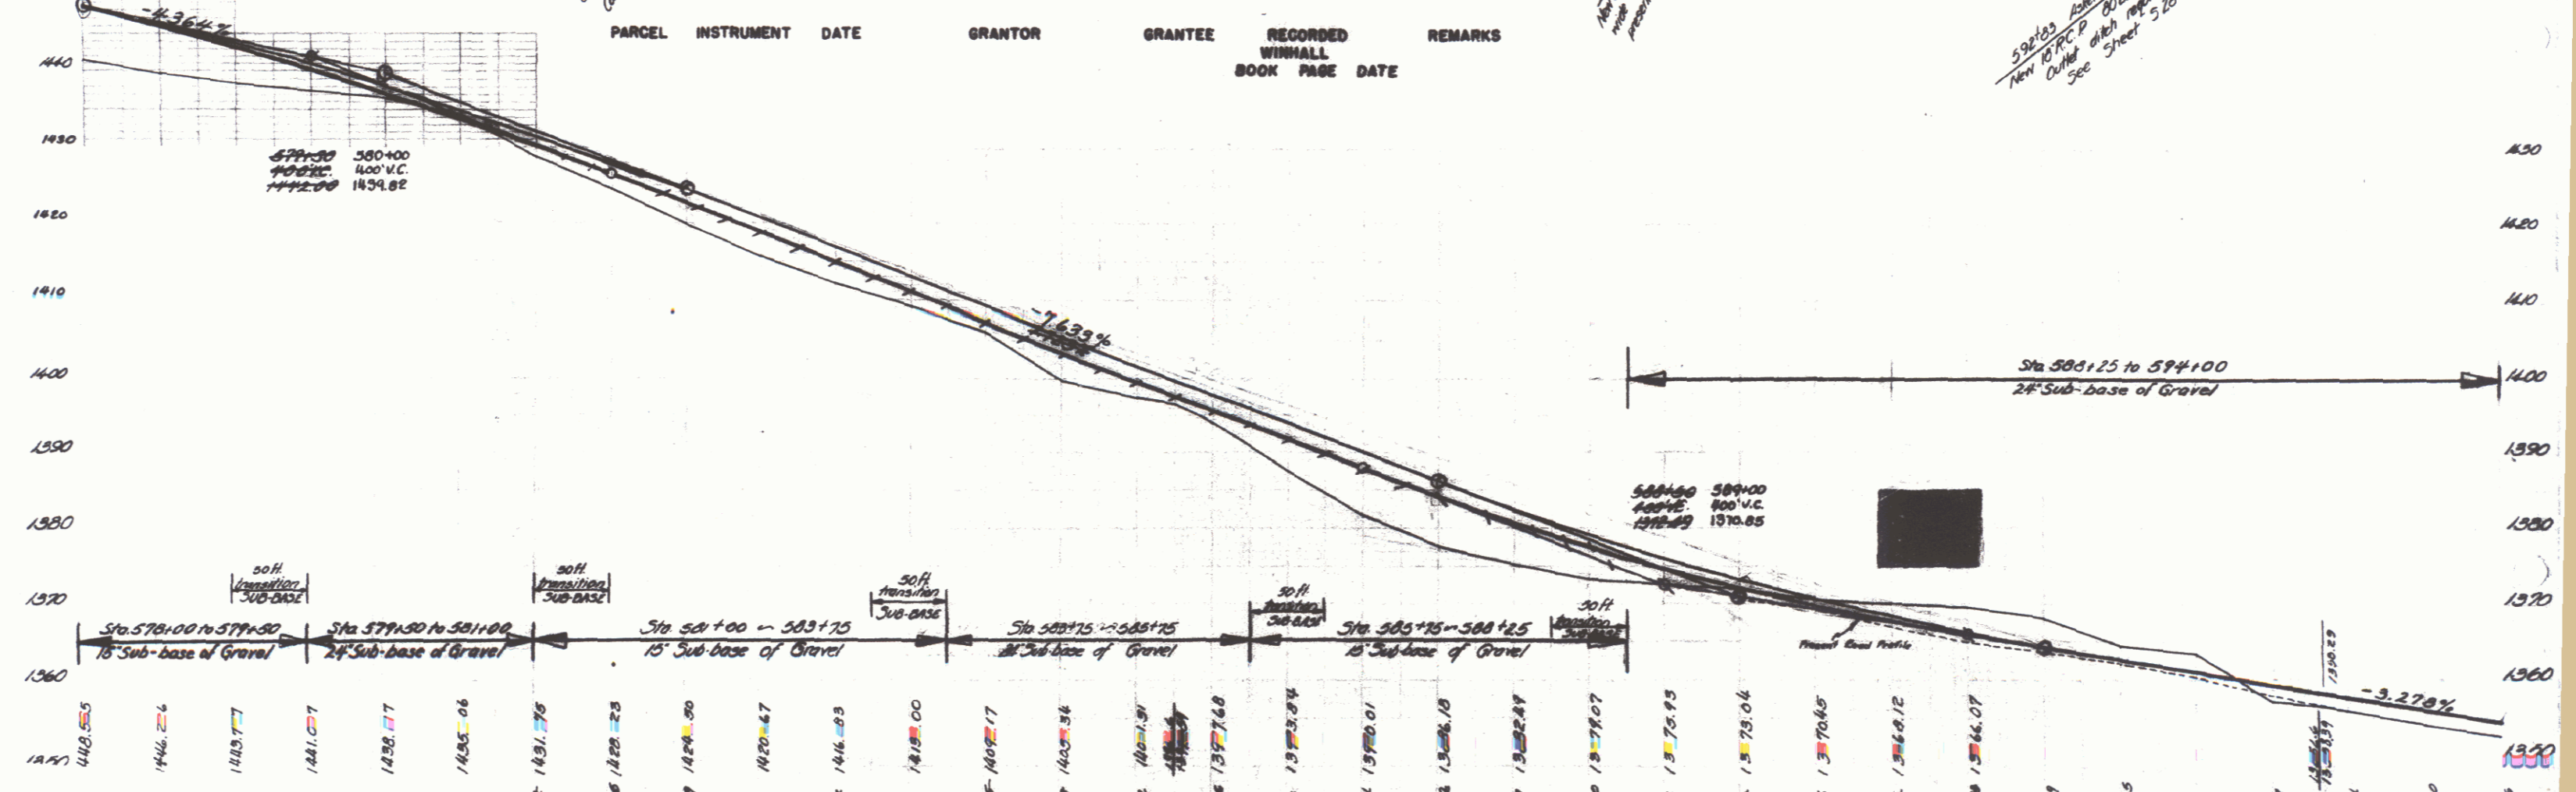


POOR ORIGINAL COPY

ED. ROAD	DATE	SCALE	SHEET	TOTAL
1941	1942	9	67	

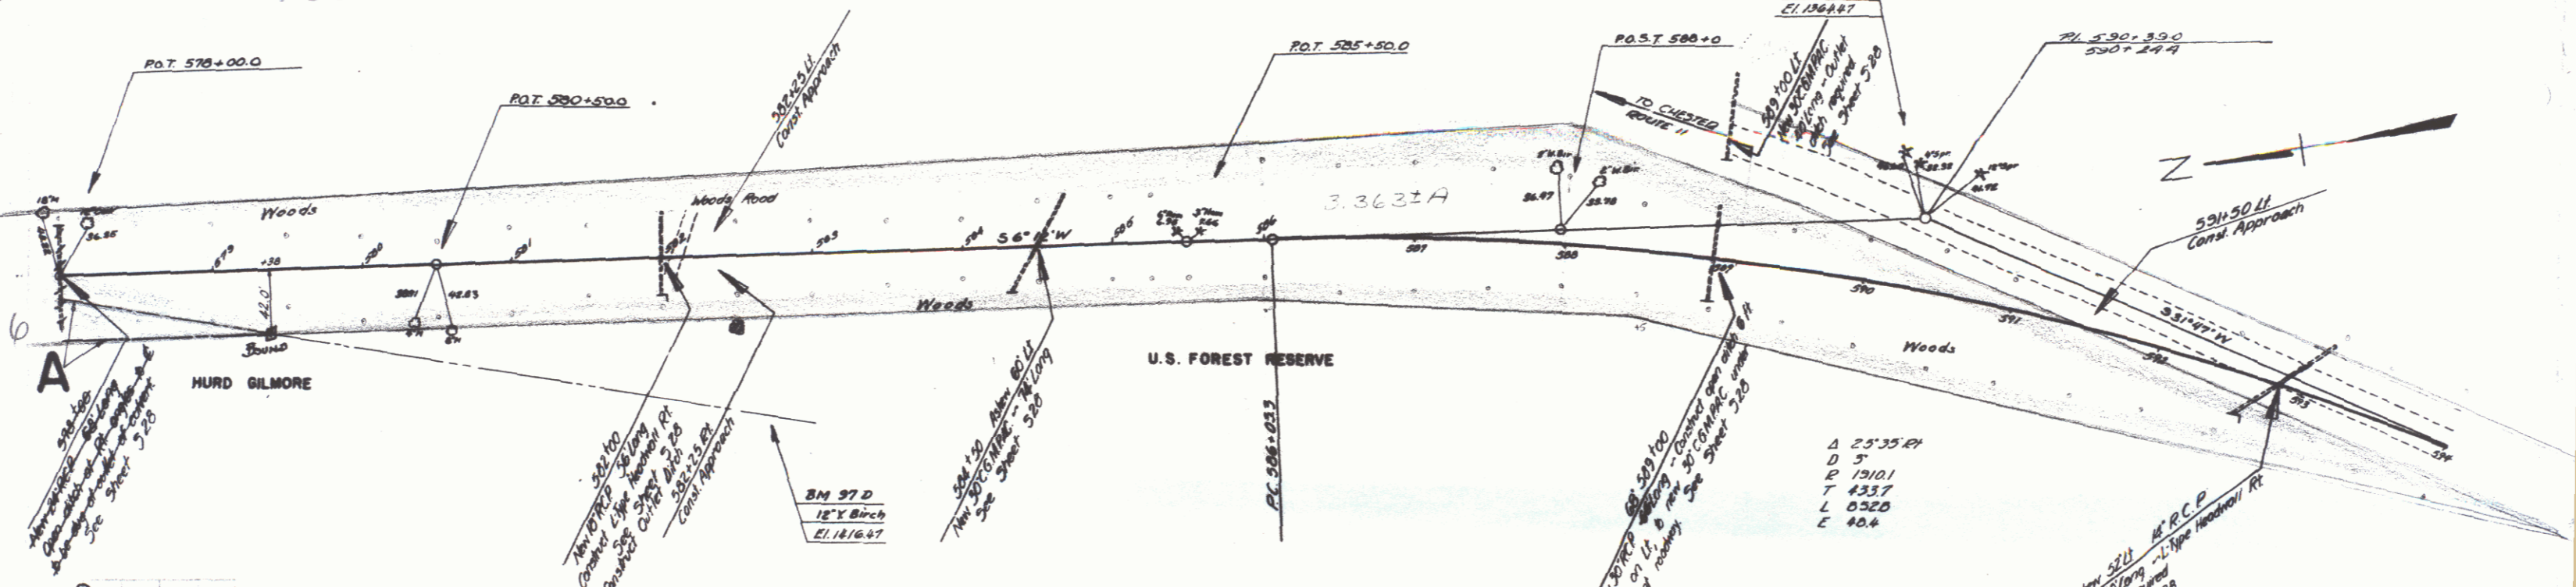

PARCEL	INSTRUMENT	DATE	GRANTOR	GRANTEE	RECORDED	REMARKS
					BOOK	
					PAGE	
					DATE	

Δ 25.35 FT
 D 3'
 P 13101
 T 4337
 L 0528
 E 40.4

9