


POOR ORIGINAL COPY

PARCEL	INSTRUMENT	DATE	GRANTOR	GRANTEE	RECORDED	REMARKS
A, B	CONDOM	12-1-43	BERTHA WALKER	5T OF VT	BOOK 15 PAGE 441-448	DATE 12-9-43
A' B'	W.D.O.E.	12-11-45	BERTHA WALKER	3T OF VT	591-593	12-18-45

STATE OF VERMONT
 93(9) 1946 5 53

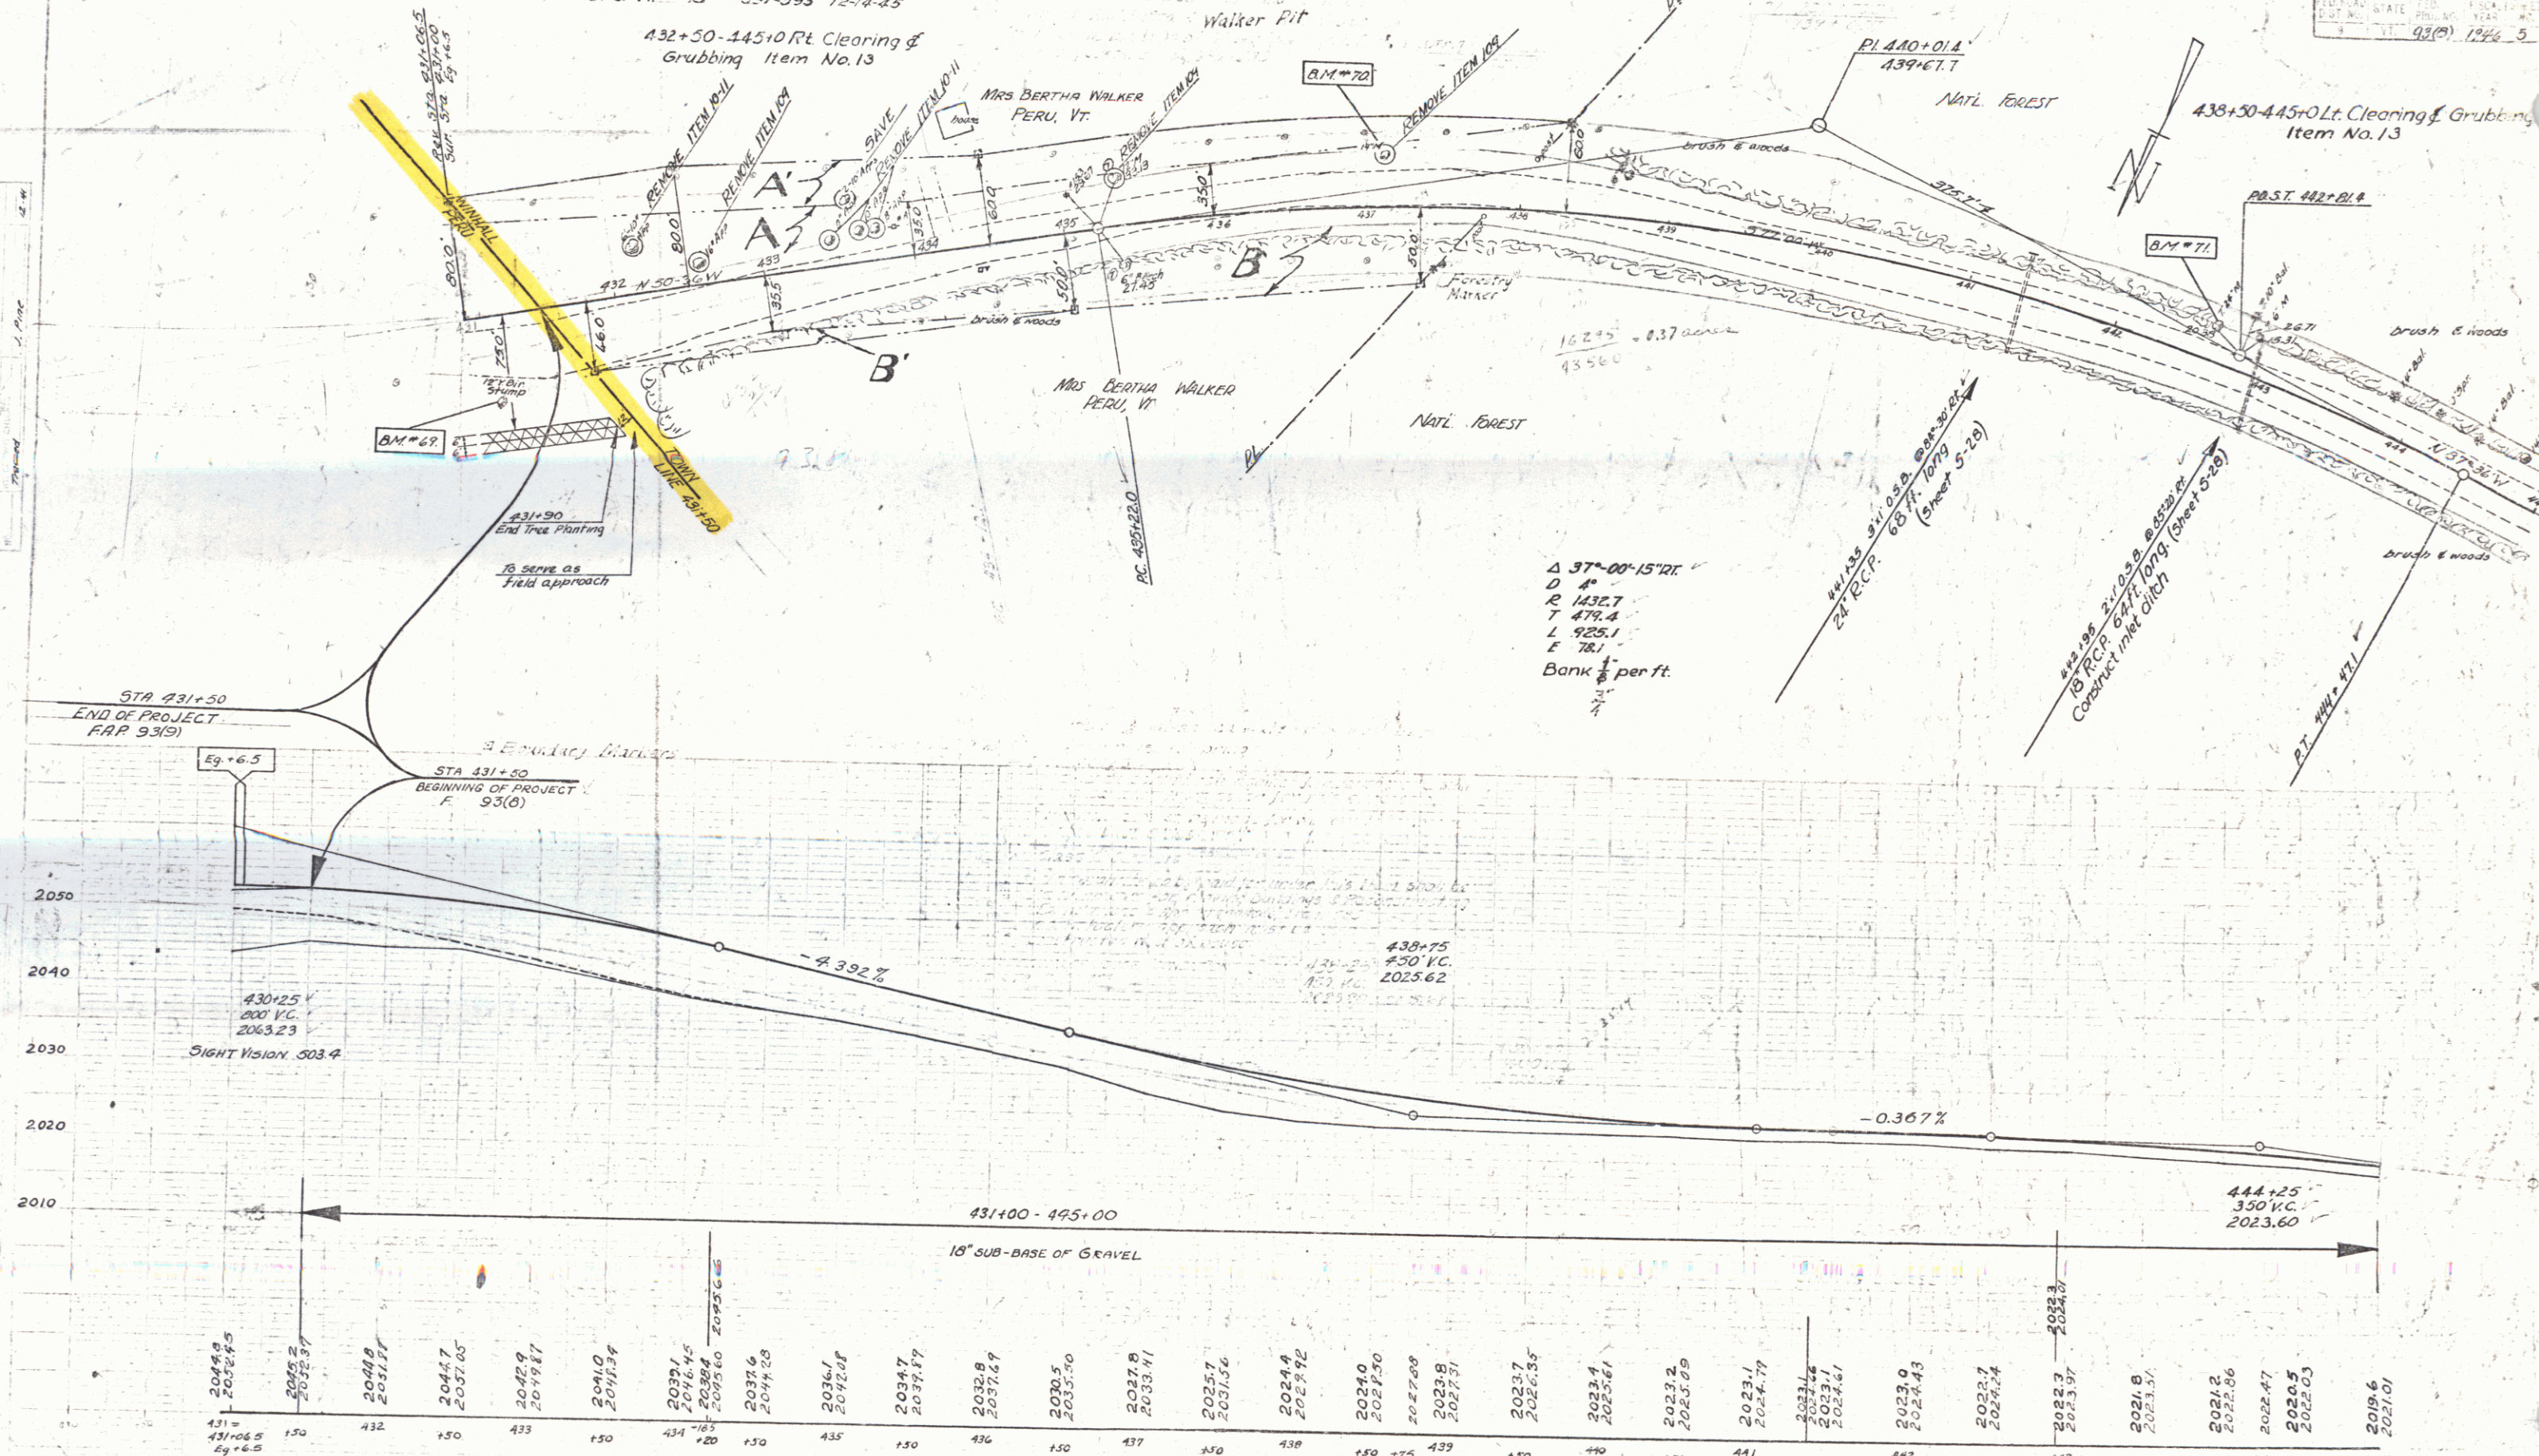

BM #69	S. 1. R. 24	Trunk 12" Birch	29' RT	Sta. 431+16	Elev. 2050.84	2050.84
BM #70	S. 1. R. 24	Maple	22' L.	Sta. 437+14	Elev. 2028.10	2028.10
BM #71	S. 1. R. 24	Maple	108' L.	Sta. 442+84	Elev. 2023.39	2023.39
BM #72	S. 1. R. 24	Maple	108' L.	Sta. 442+84	Elev. 2023.39	2023.39

Winhall F. 93(9)
 FAP 93(9)
 Sheet 5 of 53