


445+00-447+00 RT. CLEARING AND GRUBBING ITEM NO. 13

NAT'L FOREST

93(5) 1946 2 28

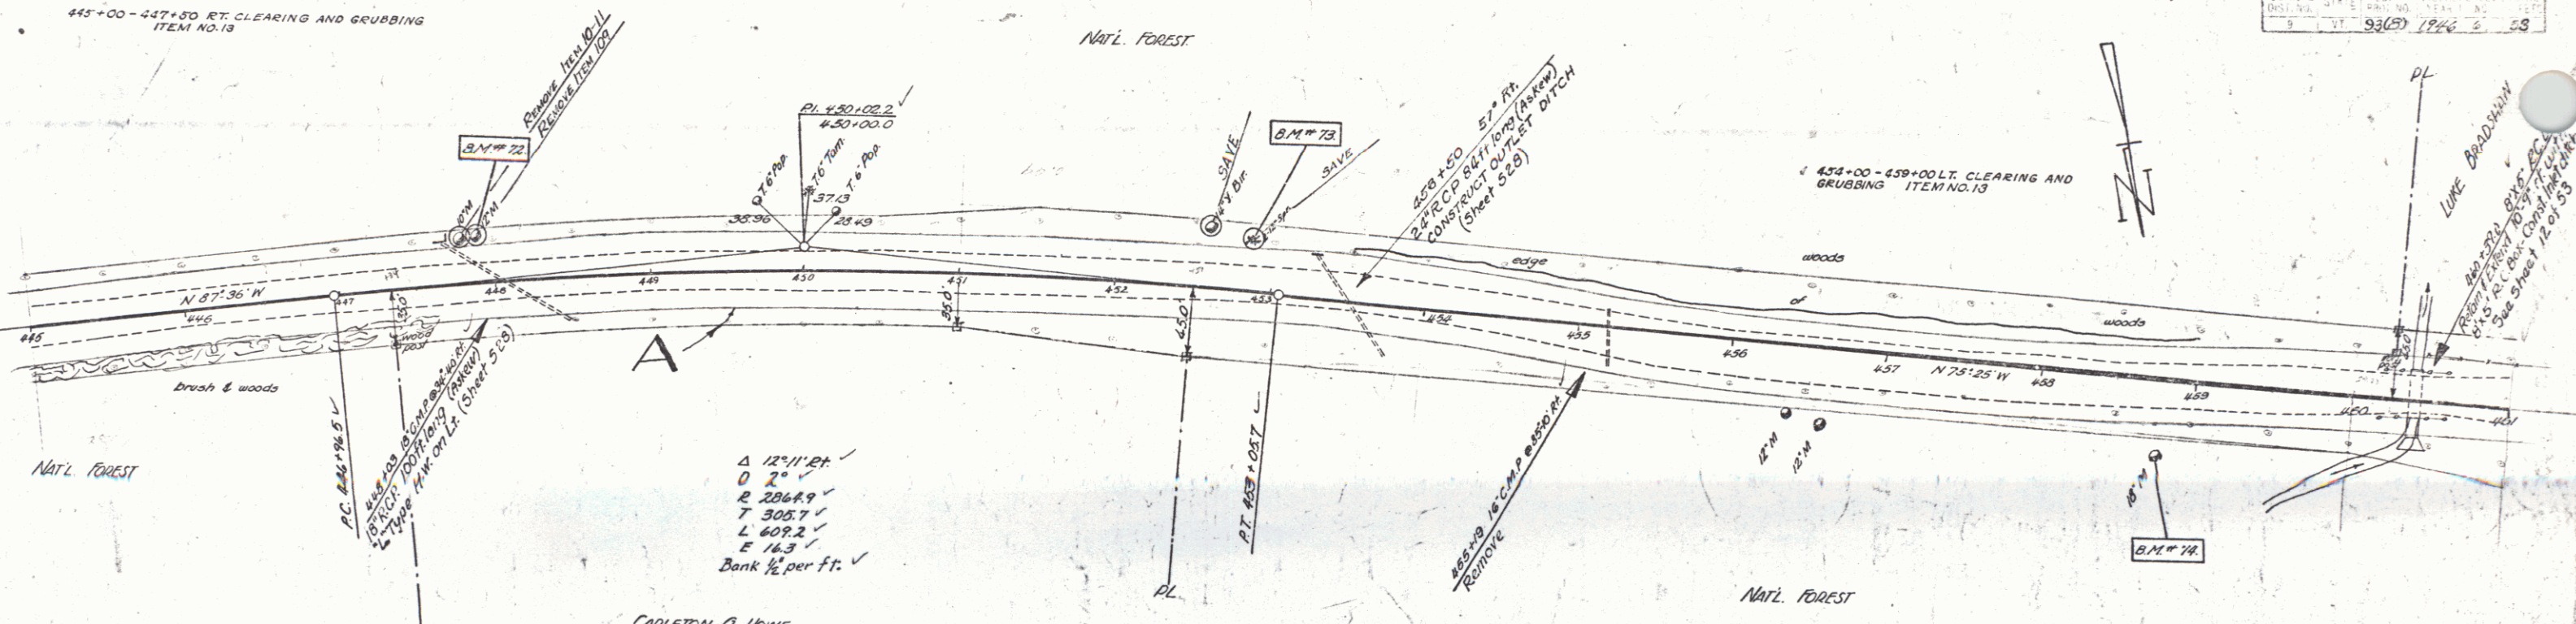


PARCEL INSTRUMENT DATE GRANTOR GRANTEE RECORDED REMARKS

A R.C.D. 1-12-44 CARLETON G. HOWE CARLETON G. HOWE L. DORSET, II WINHALL

BOOK PAGE DATE

15 461462 1-20-44

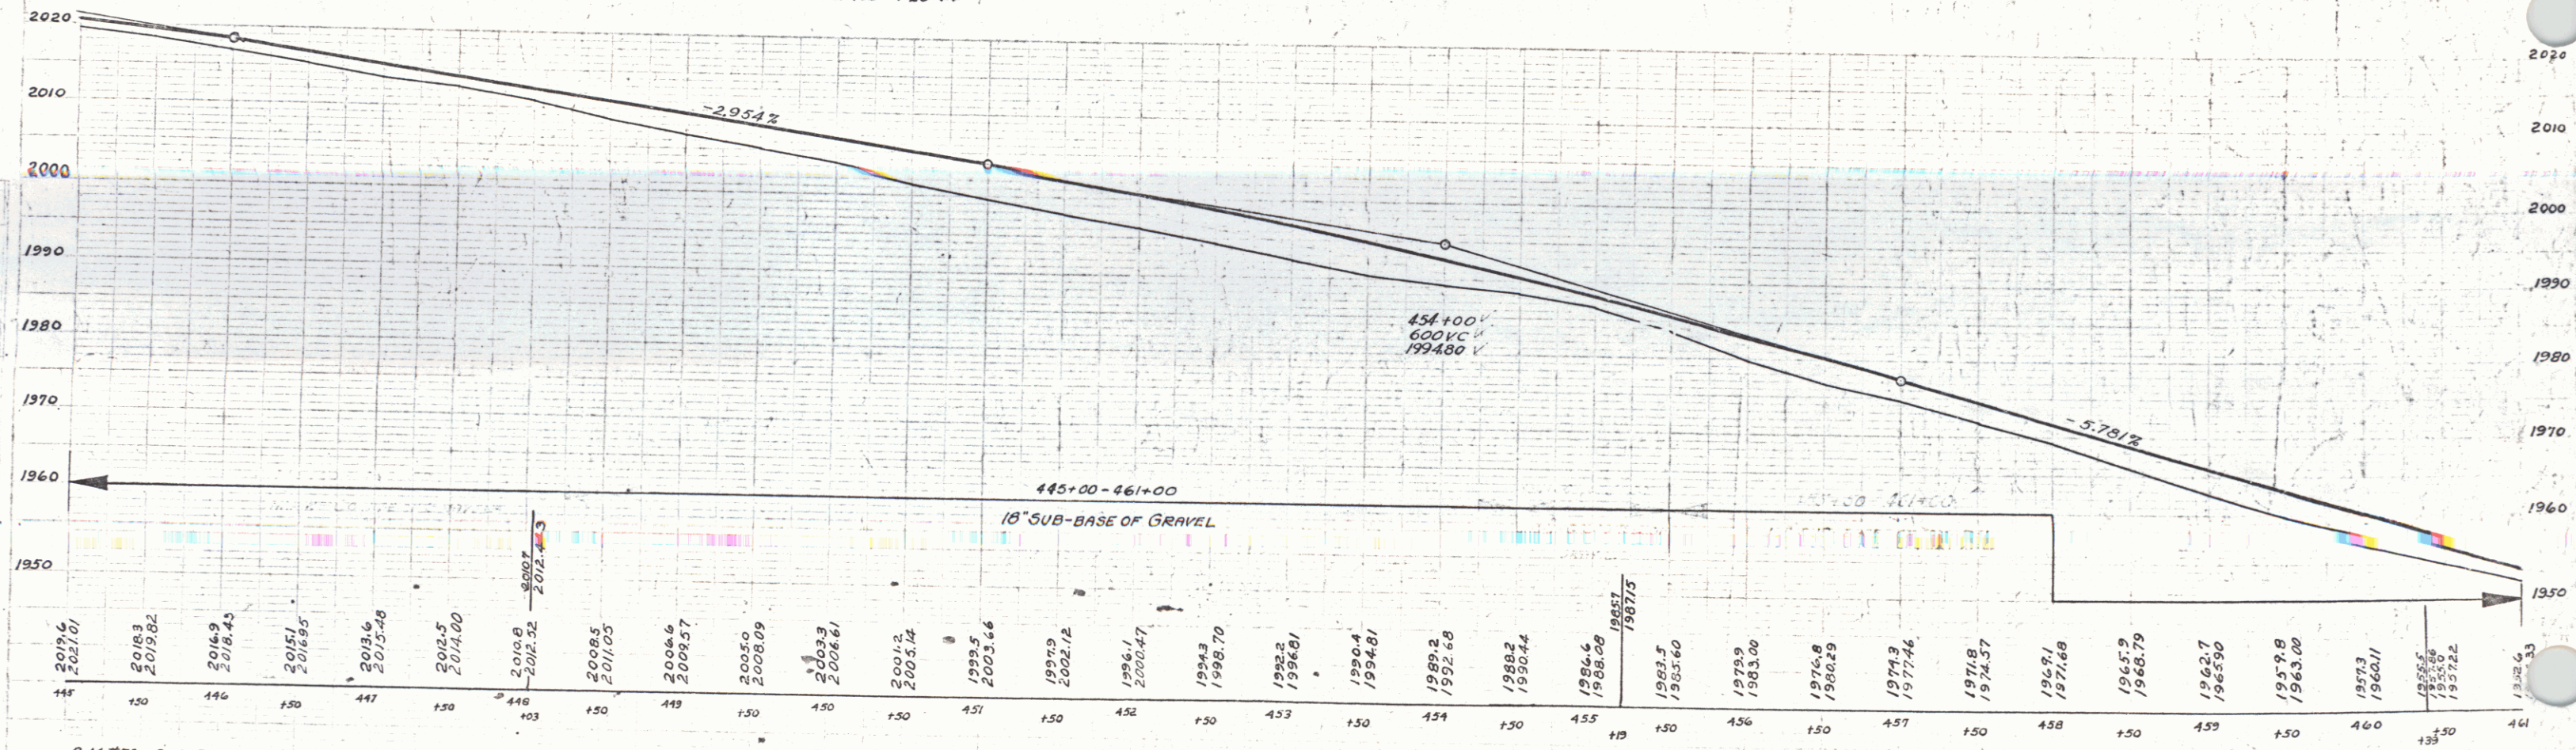

B.M. #72	S. I. R.	12" Mag	26' ET	Sta 447+90	Elev. 2013.19	72	2013.50
B.M. #73	S. I. R.	2 1/2" Mag	32' ET	Sta 452+83	Elev. 1993.69	73	1994.09
B.M. #74	S. I. R.	18" Mag	44.5' ET	Sta 458+04	Elev. 1963.66	74	1964.08