
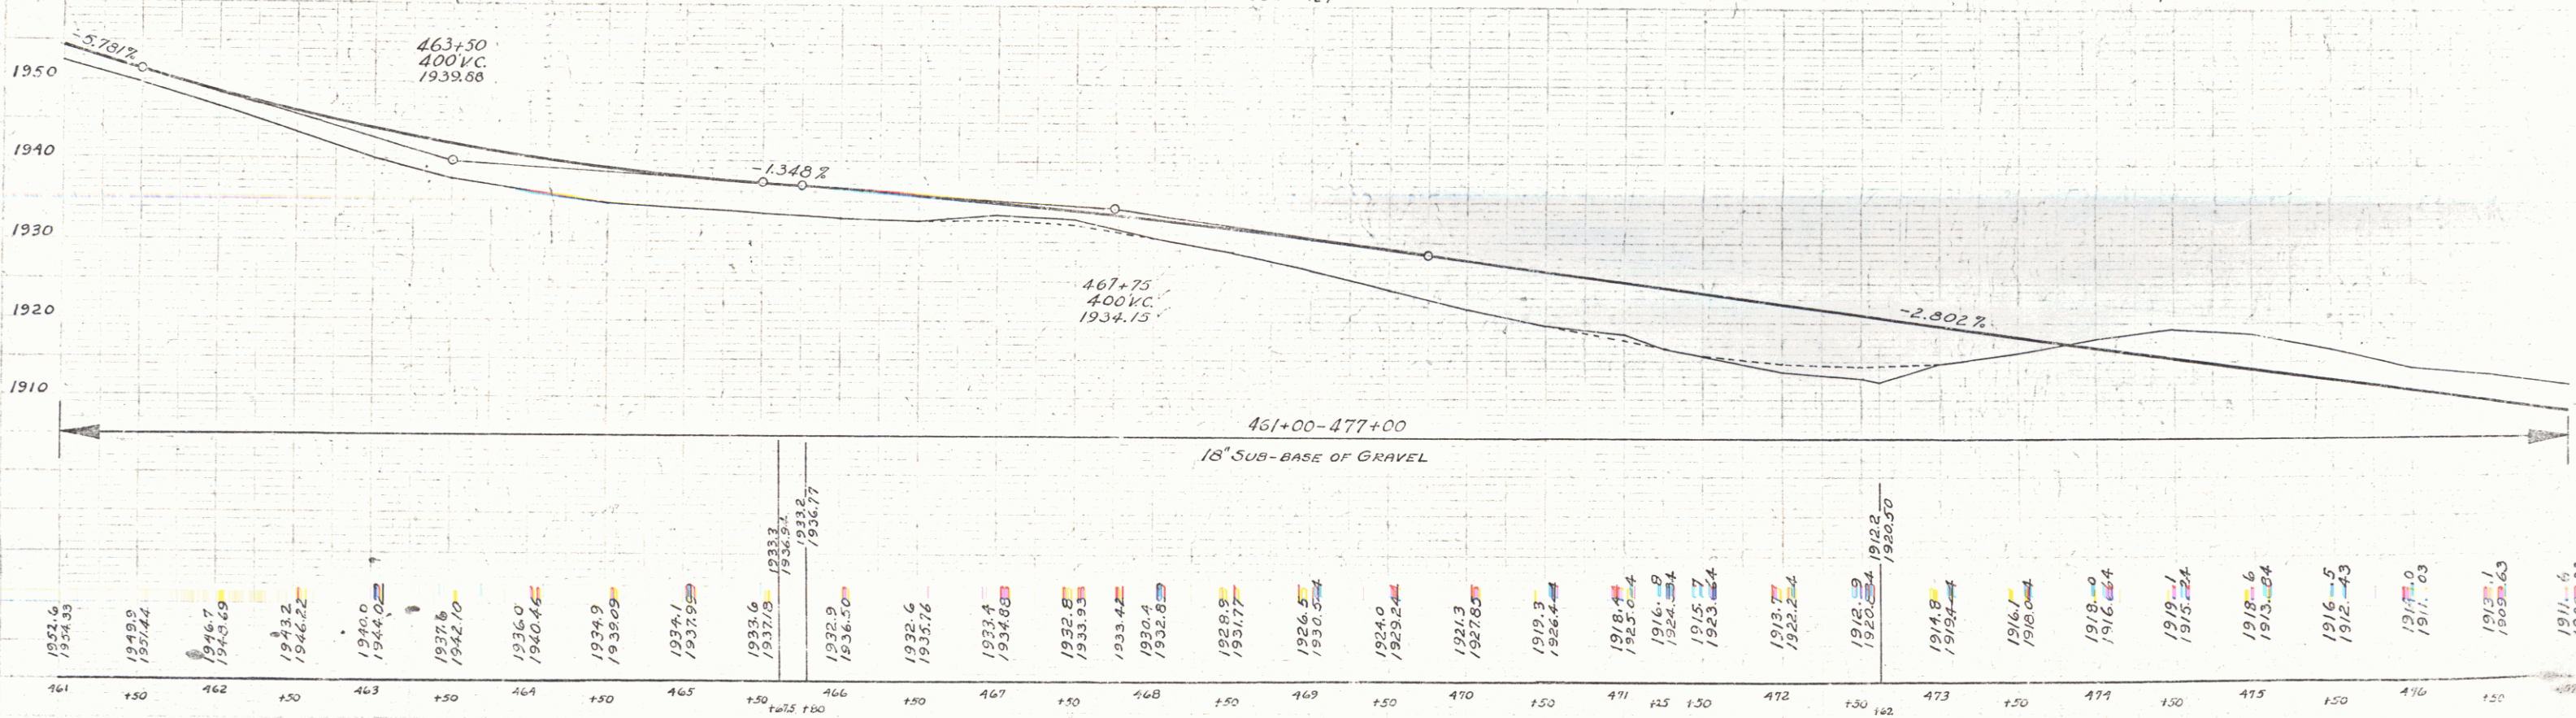


PARCEL INSTRUMENT DATE GRANTOR GRANTEE RECORDED REMARKS
 A 13 WOODS 1-3-44 LUKE BRADSHAW ST OF VT WINHALL
 BOOK PAGE DATE
 15 459-461 18-44

PLAT NO. 1260
 STATE VT
 DATE 17/2/44

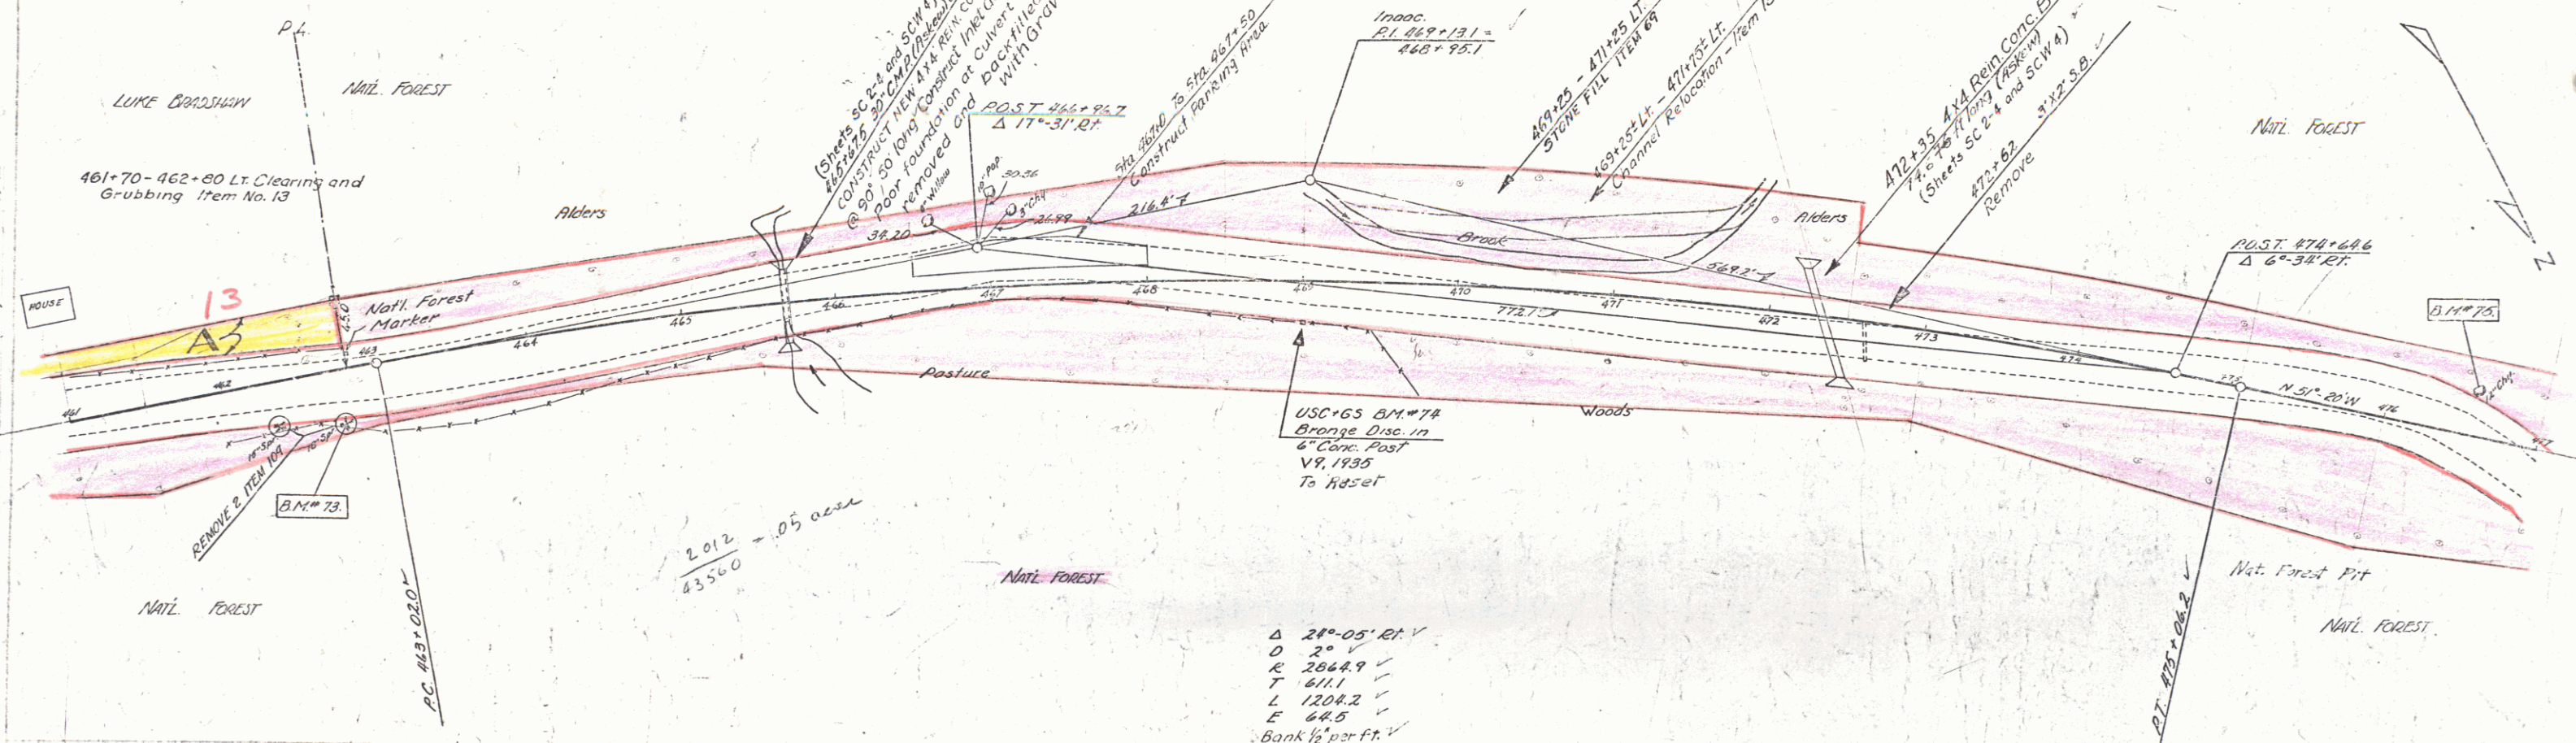

461+00-477+00
 18" SUB-BASE OF GRAVEL

1952.6
 1954.33
 1949.9
 1957.44
 1946.7
 1943.09
 1933.2
 1944.22
 1940.0
 1944.02
 1937.6
 1942.10
 1936.0
 1940.46
 1934.9
 1939.09
 1934.1
 1937.99
 1933.6
 1937.19
 1933.2
 1934.51
 1932.9
 1936.20
 1932.6
 1933.76
 1933.4
 1934.68
 1932.8
 1933.95
 1933.42
 1930.4
 1932.8
 1928.9
 1931.77
 1926.5
 1930.54
 1924.0
 1929.24
 1921.3
 1927.83
 1919.3
 1926.4
 1918.4
 1923.04
 1916.8
 1924.84
 1915.7
 1923.44
 1913.7
 1922.24
 1912.3
 1920.24
 1914.8
 1923.44
 1916.7
 1918.04
 1918.0
 1916.44
 1919.1
 1915.24
 1918.6
 1913.04
 1916.5
 1912.43
 1917.0
 1911.03
 1913.1
 1909.63
 1911.6
 1909.23

BM#73 S.I.R. 10" Spruce 55" St. Sta. 462+75 Elev. 1942.71 ✓
 BM#74 Bronze Disc in 6" Box Sta. 467+0 Elev. 1938.43 ✓
 BM#75 S.I.R. 10" Chy. 18" Lt. Sta. 474+25 Elev. 1912.67 ✓

Winhall F. 93-12
 Sheet 7 of 3