
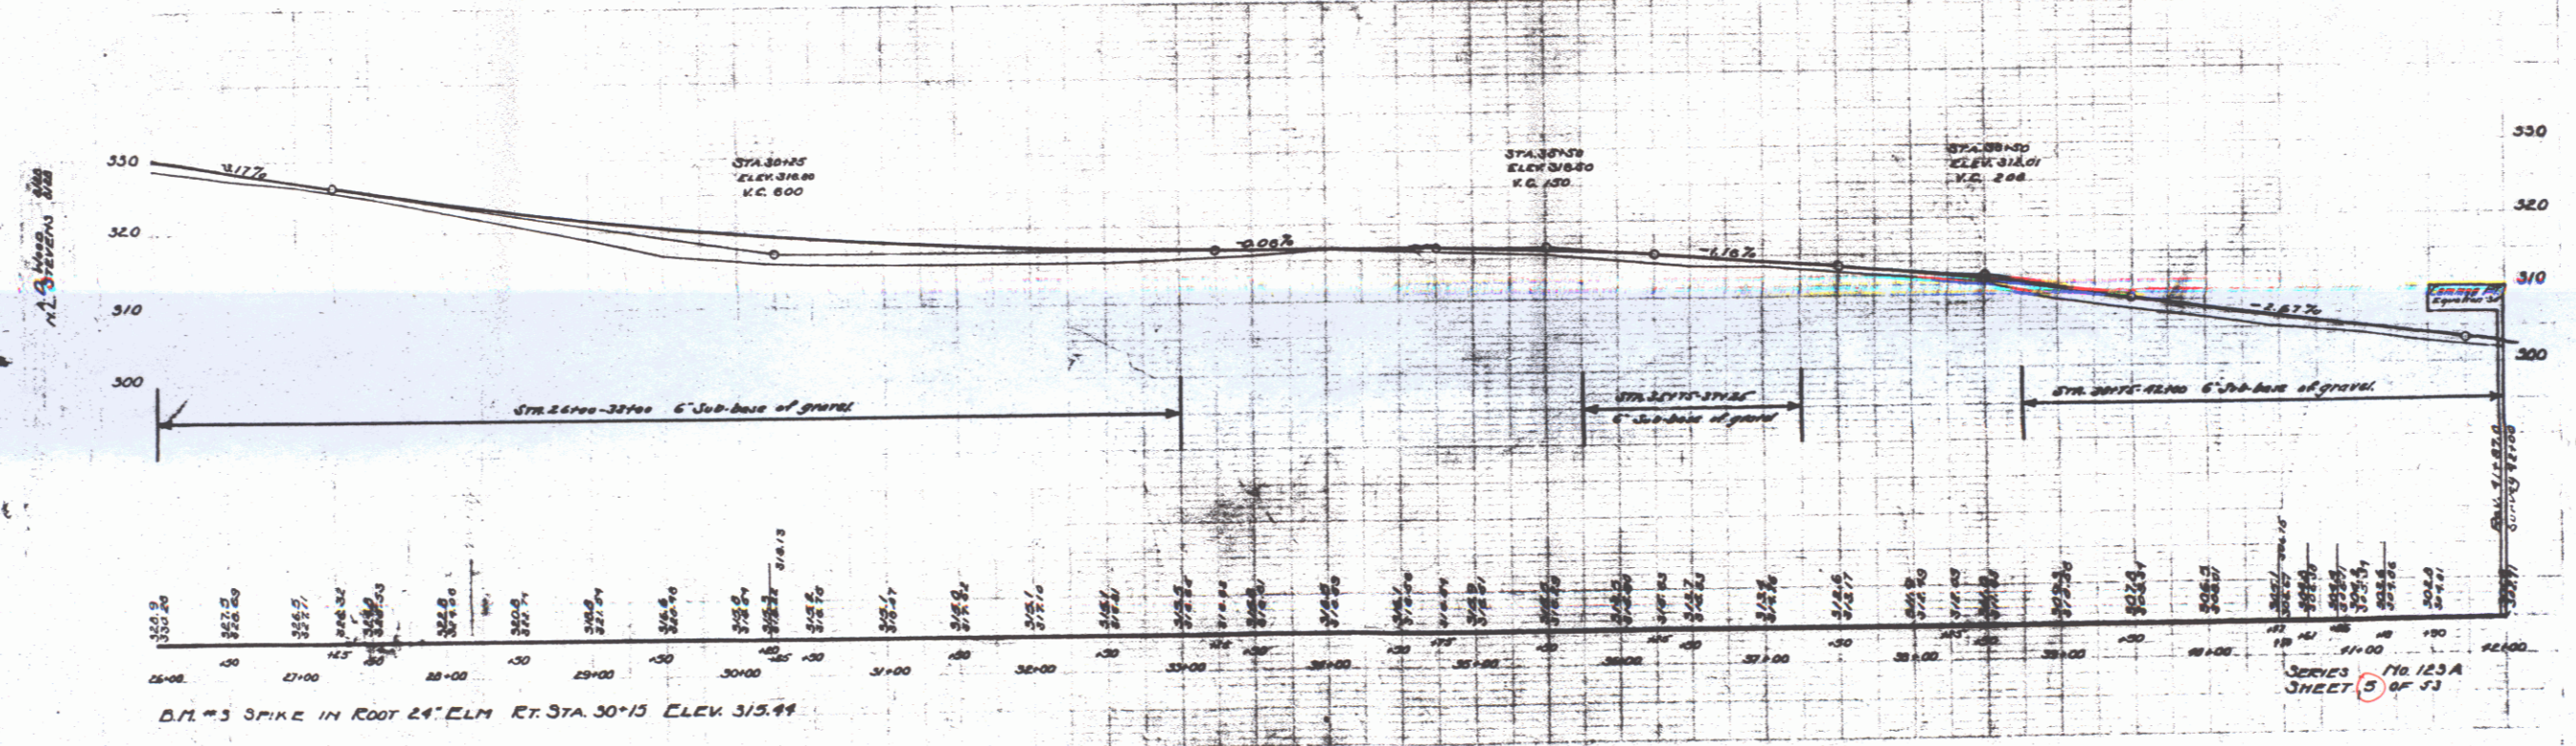


POOR ORIGINAL COPY

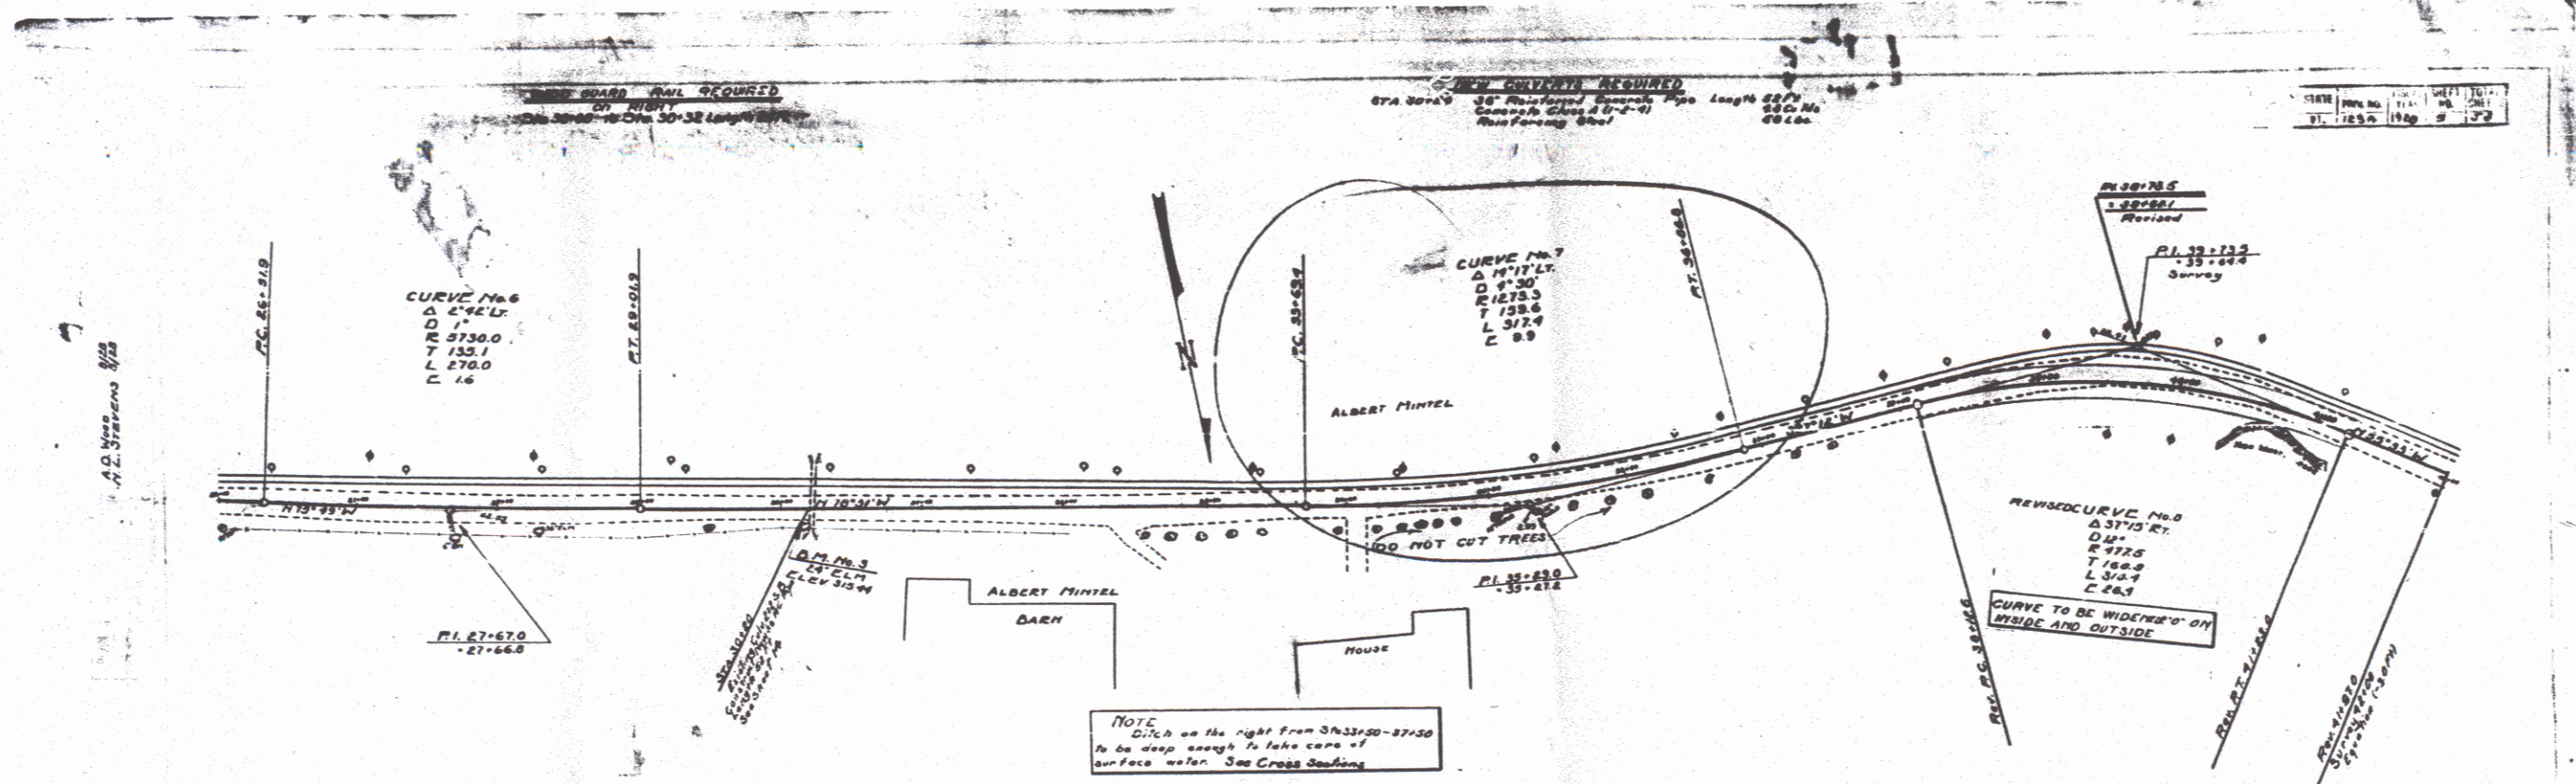

SHEET 5 OF 53