
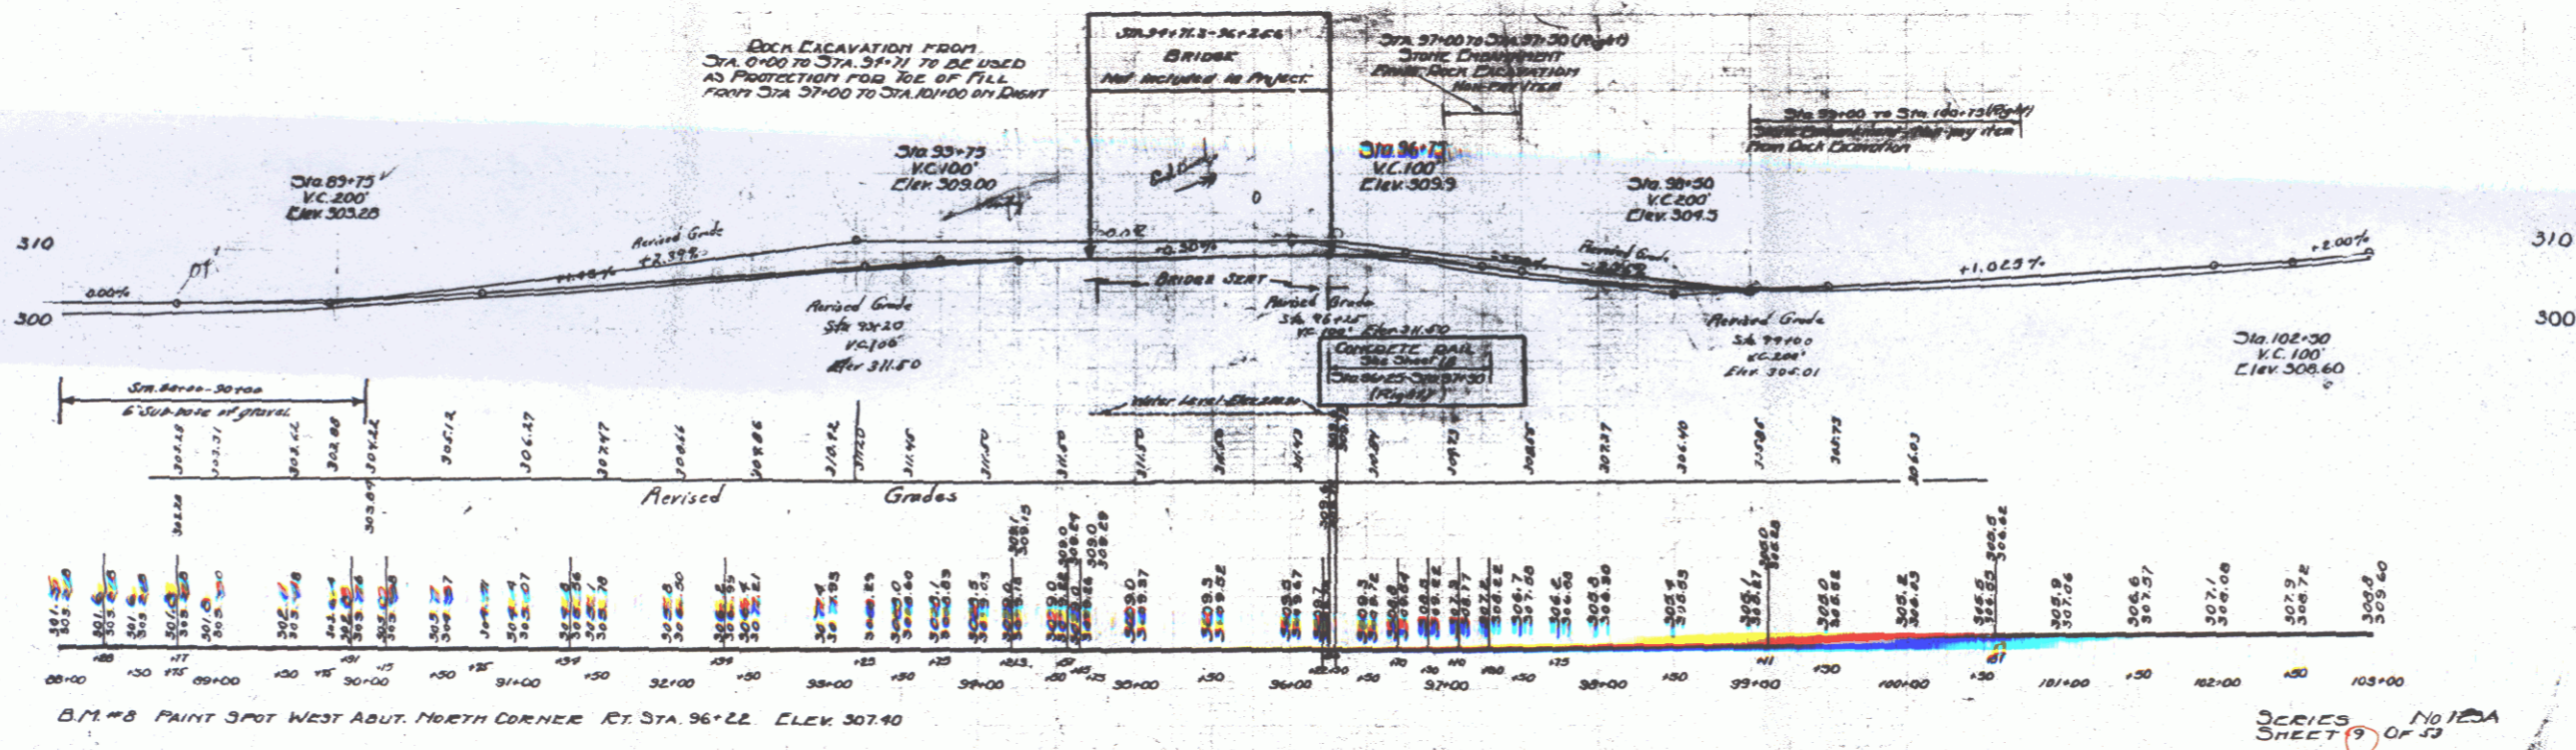


POOR ORIGINAL COPY

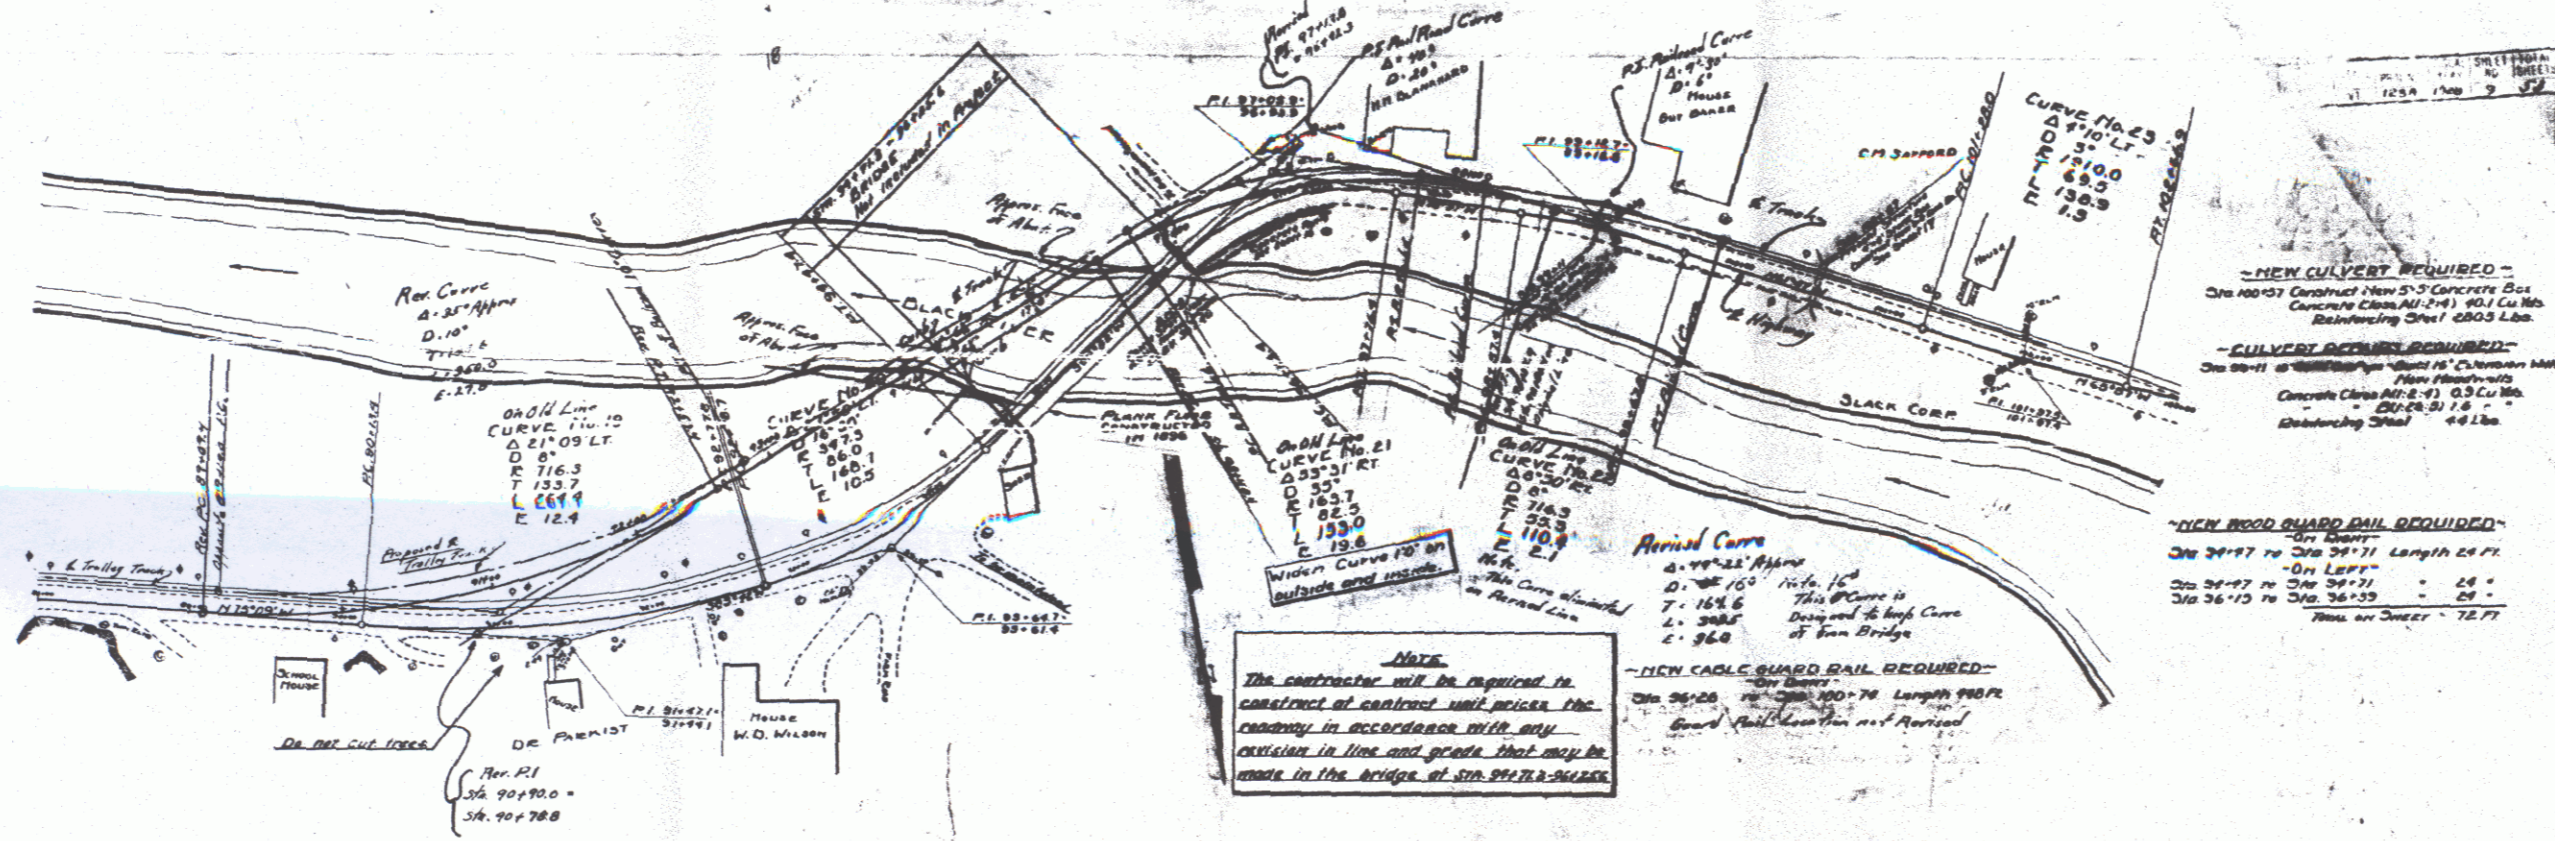

D.M. #8 PAINT SPOT WEST ABUT. NORTH CORNER RT. STA. 96+28. ELEV. 307.40

SERIES No 12A SHEET 9 OF 13