


L.T.

$$\begin{array}{r}
 750 \\
 18 \\
 \hline
 1200 \\
 150 \\
 \hline
 2700 \text{ sq.}
 \end{array}$$

80' Here ±

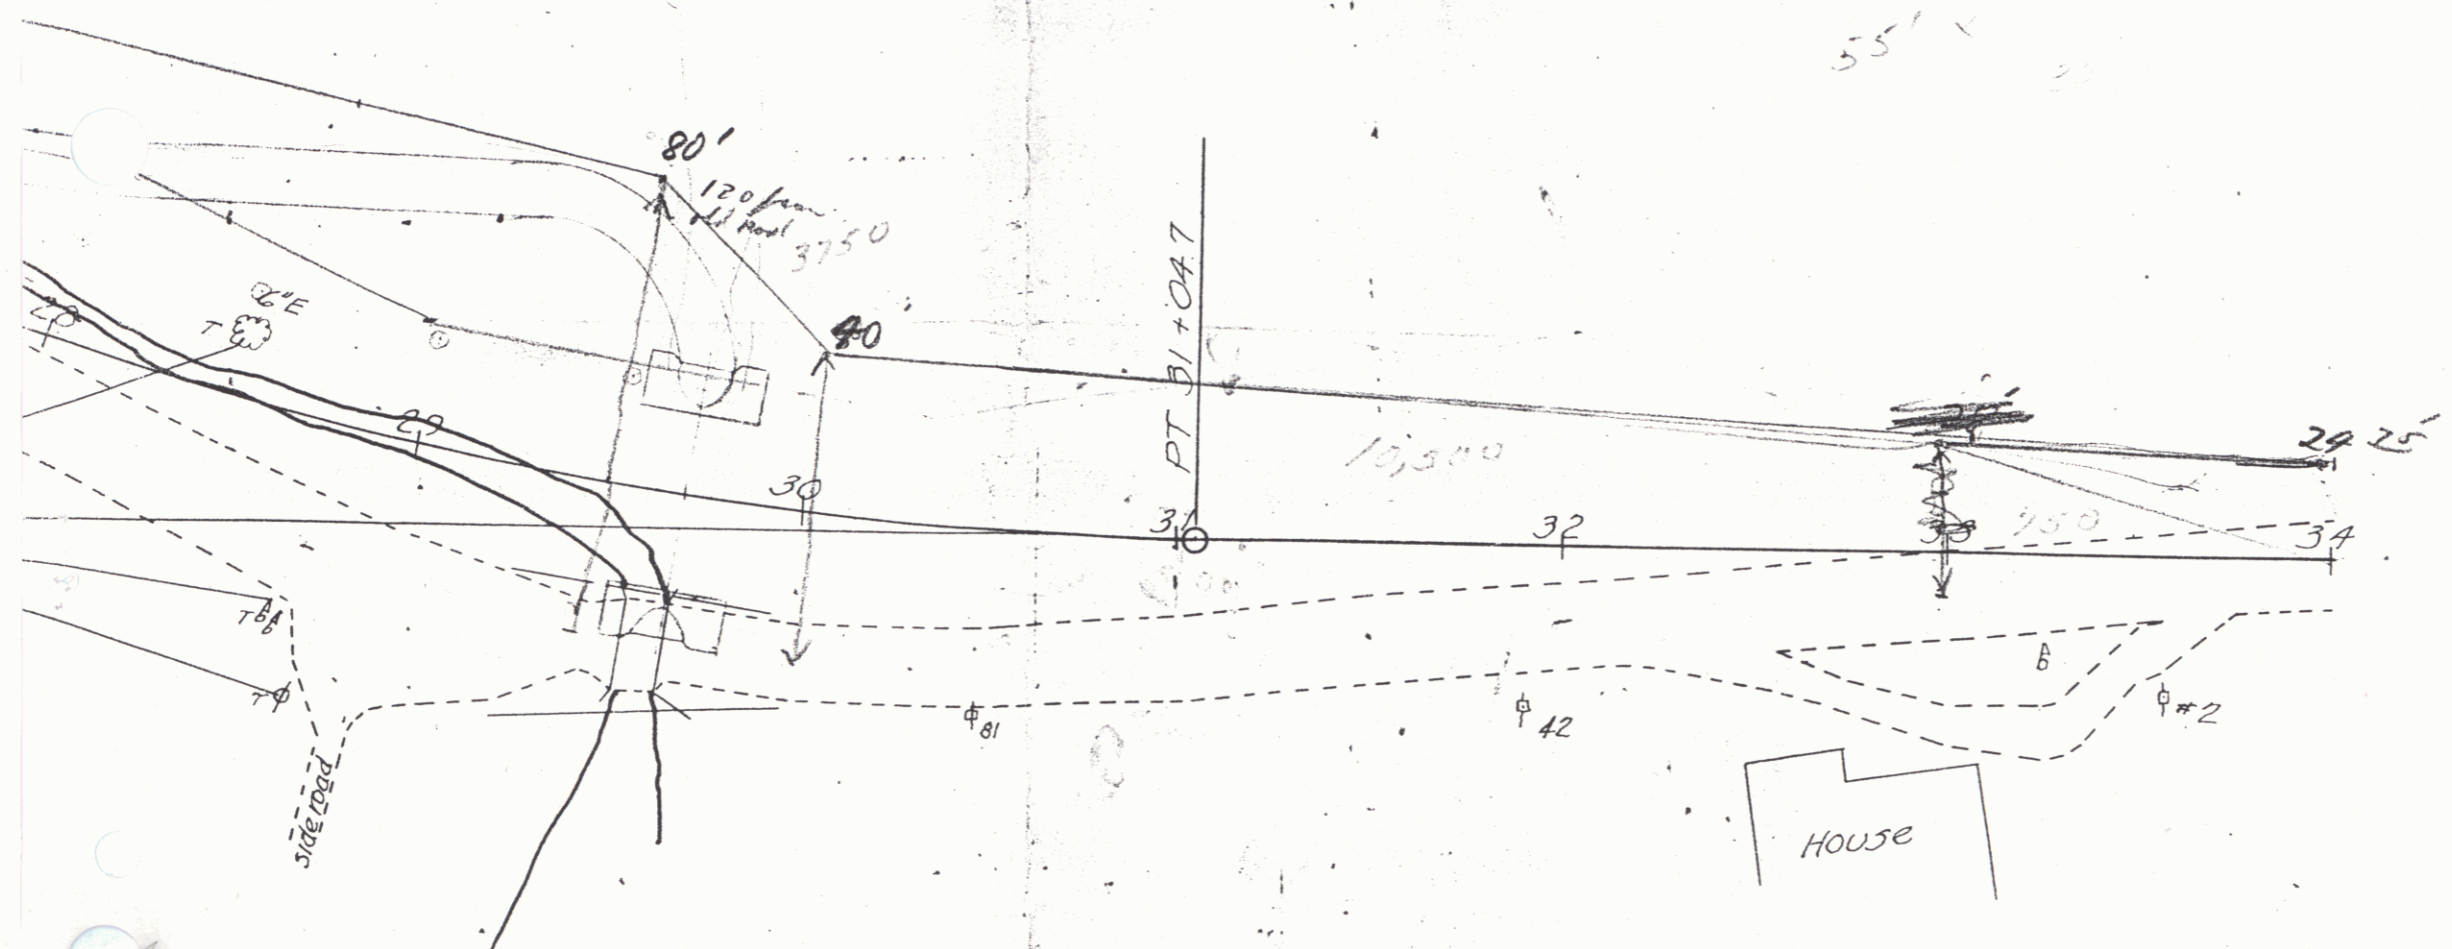

RIGHT-OF-WAY DIVISION  
 TOWN FILE  
 PERPETUAL SHEET (7B)  
 Town of Braintree Vt 12A MM 4.12  
 (To Be Returned To R.O.W. Division)  
 ST 145M Acquisition from Hill  
 10/30/56